




# Glastonbury Abbey


Polychrome Survey:



Record Drawings –

(3) S. Choir aisle


SKETCH

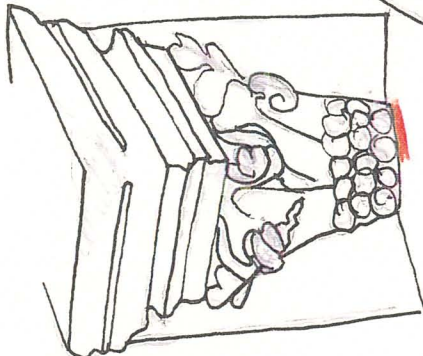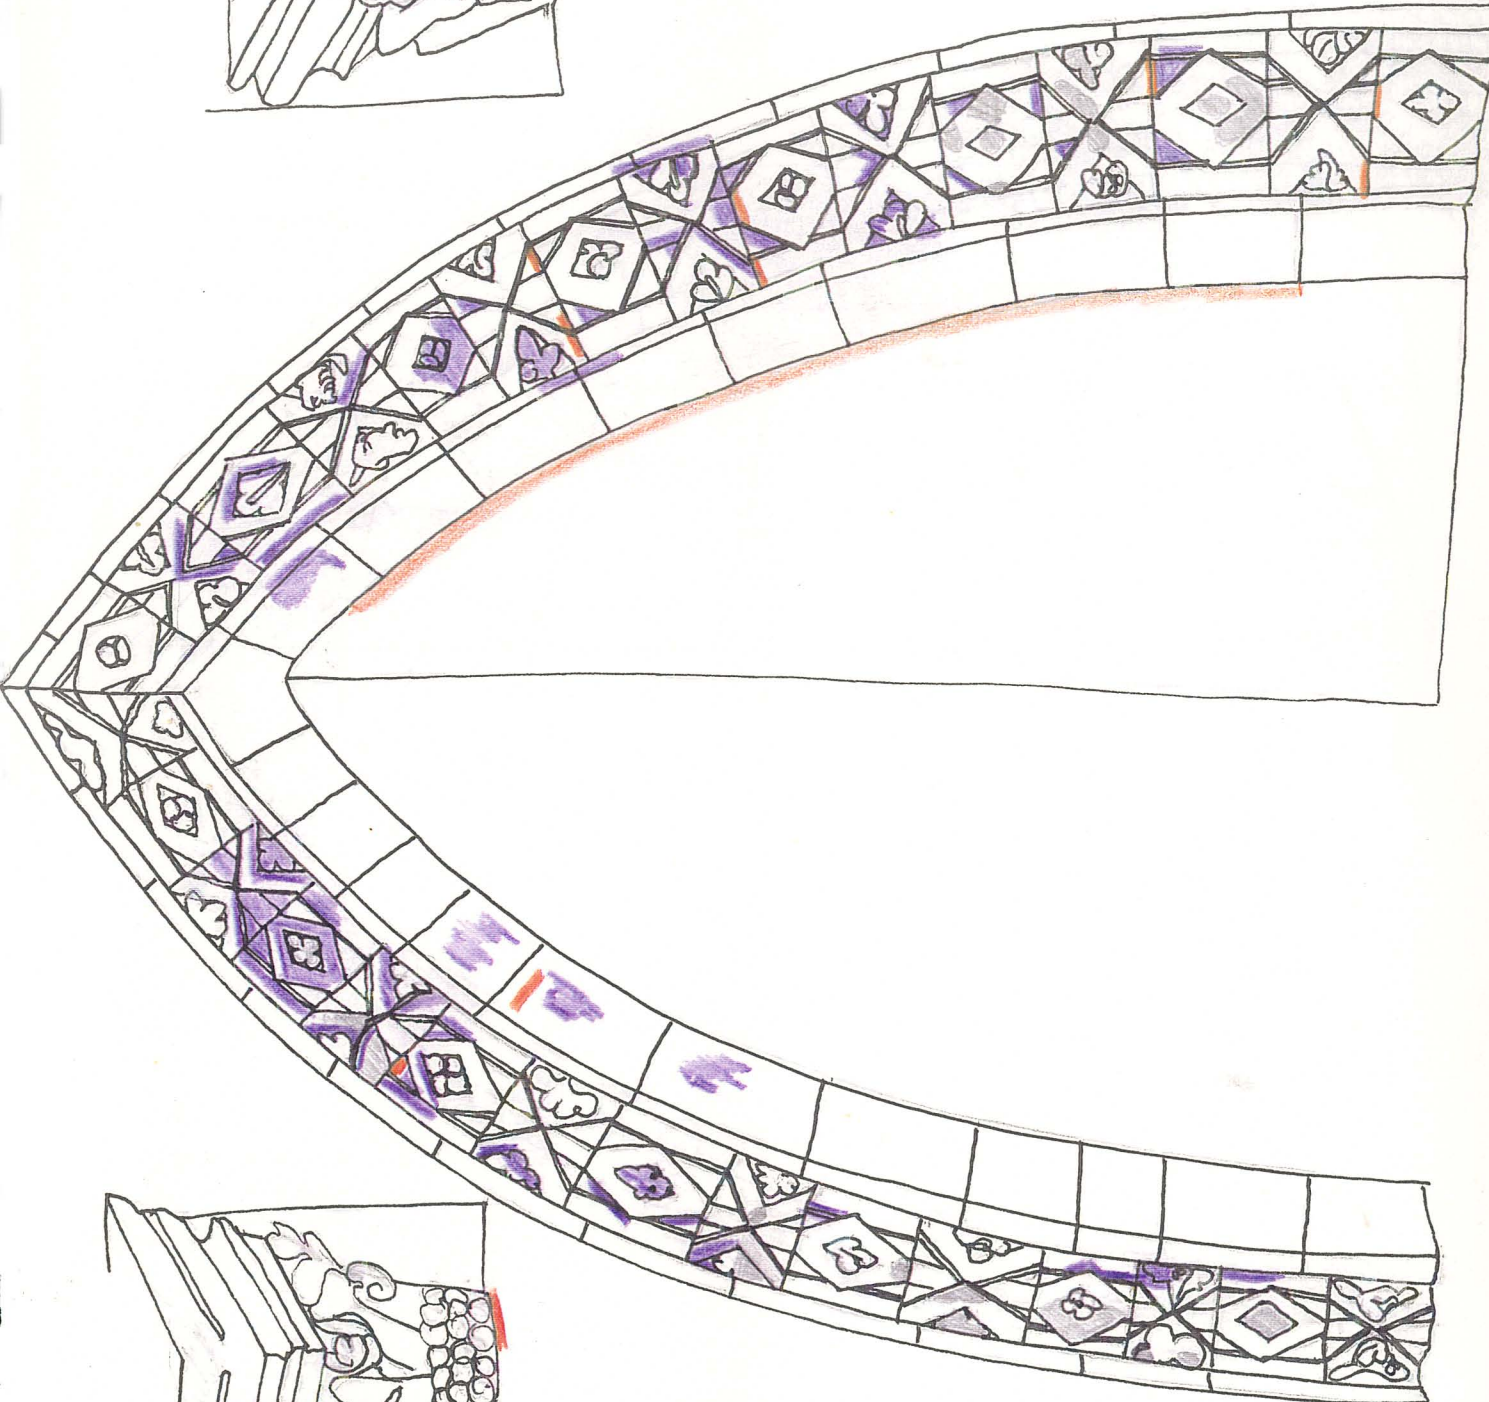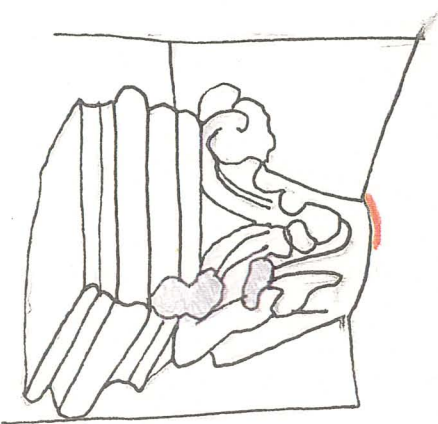

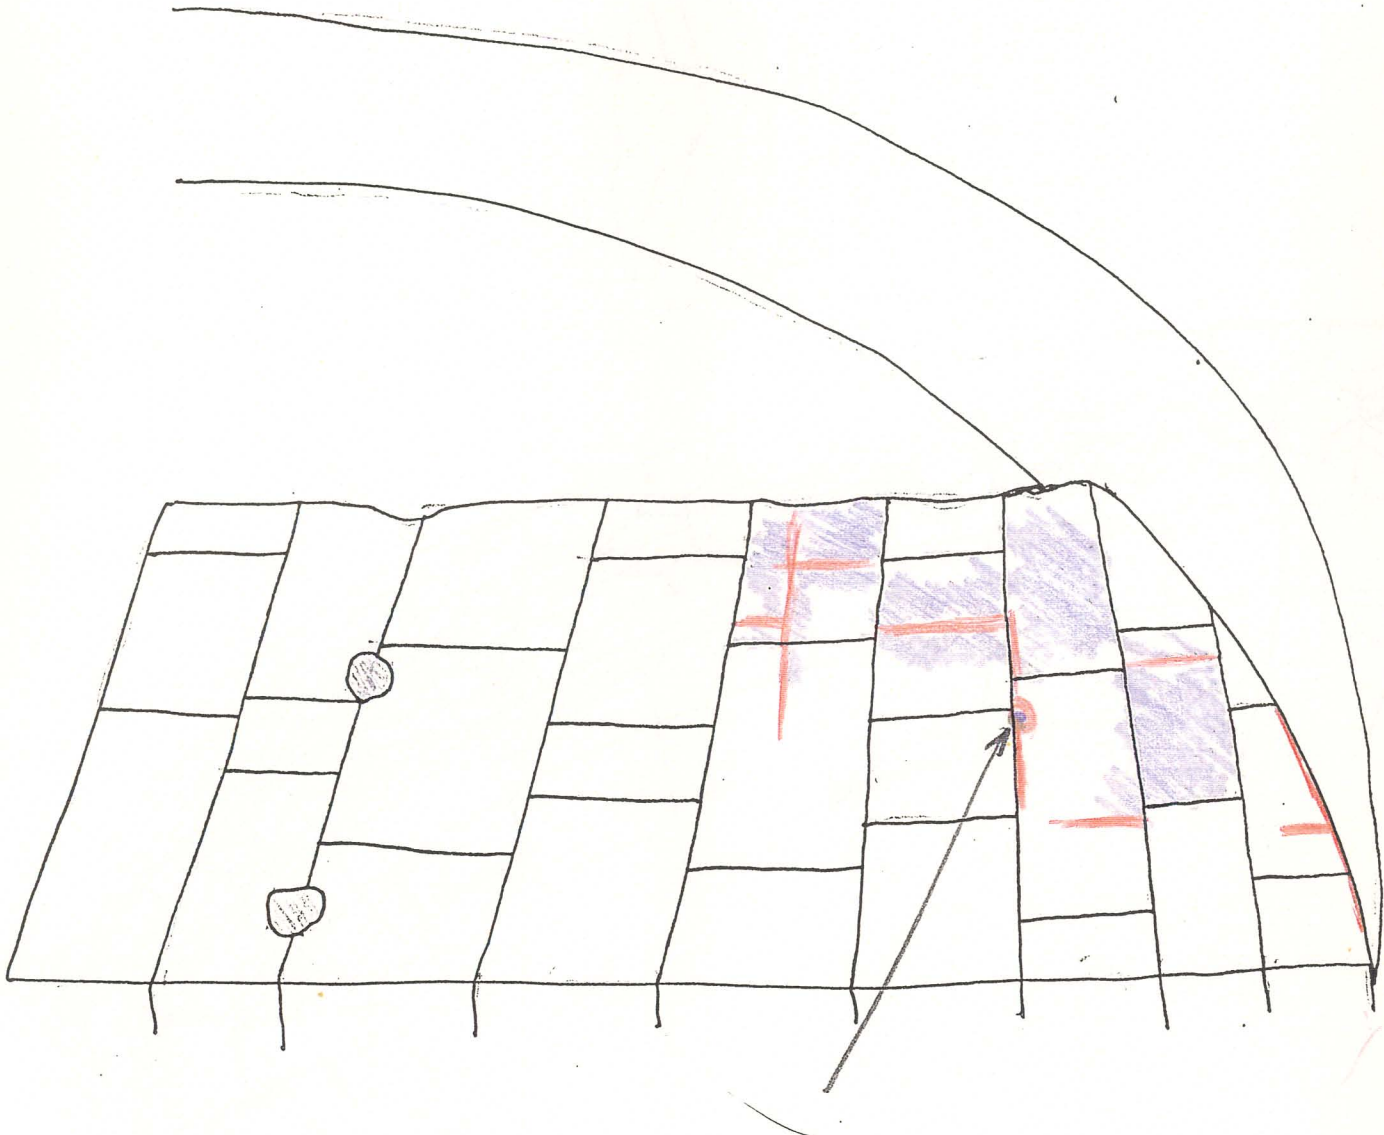

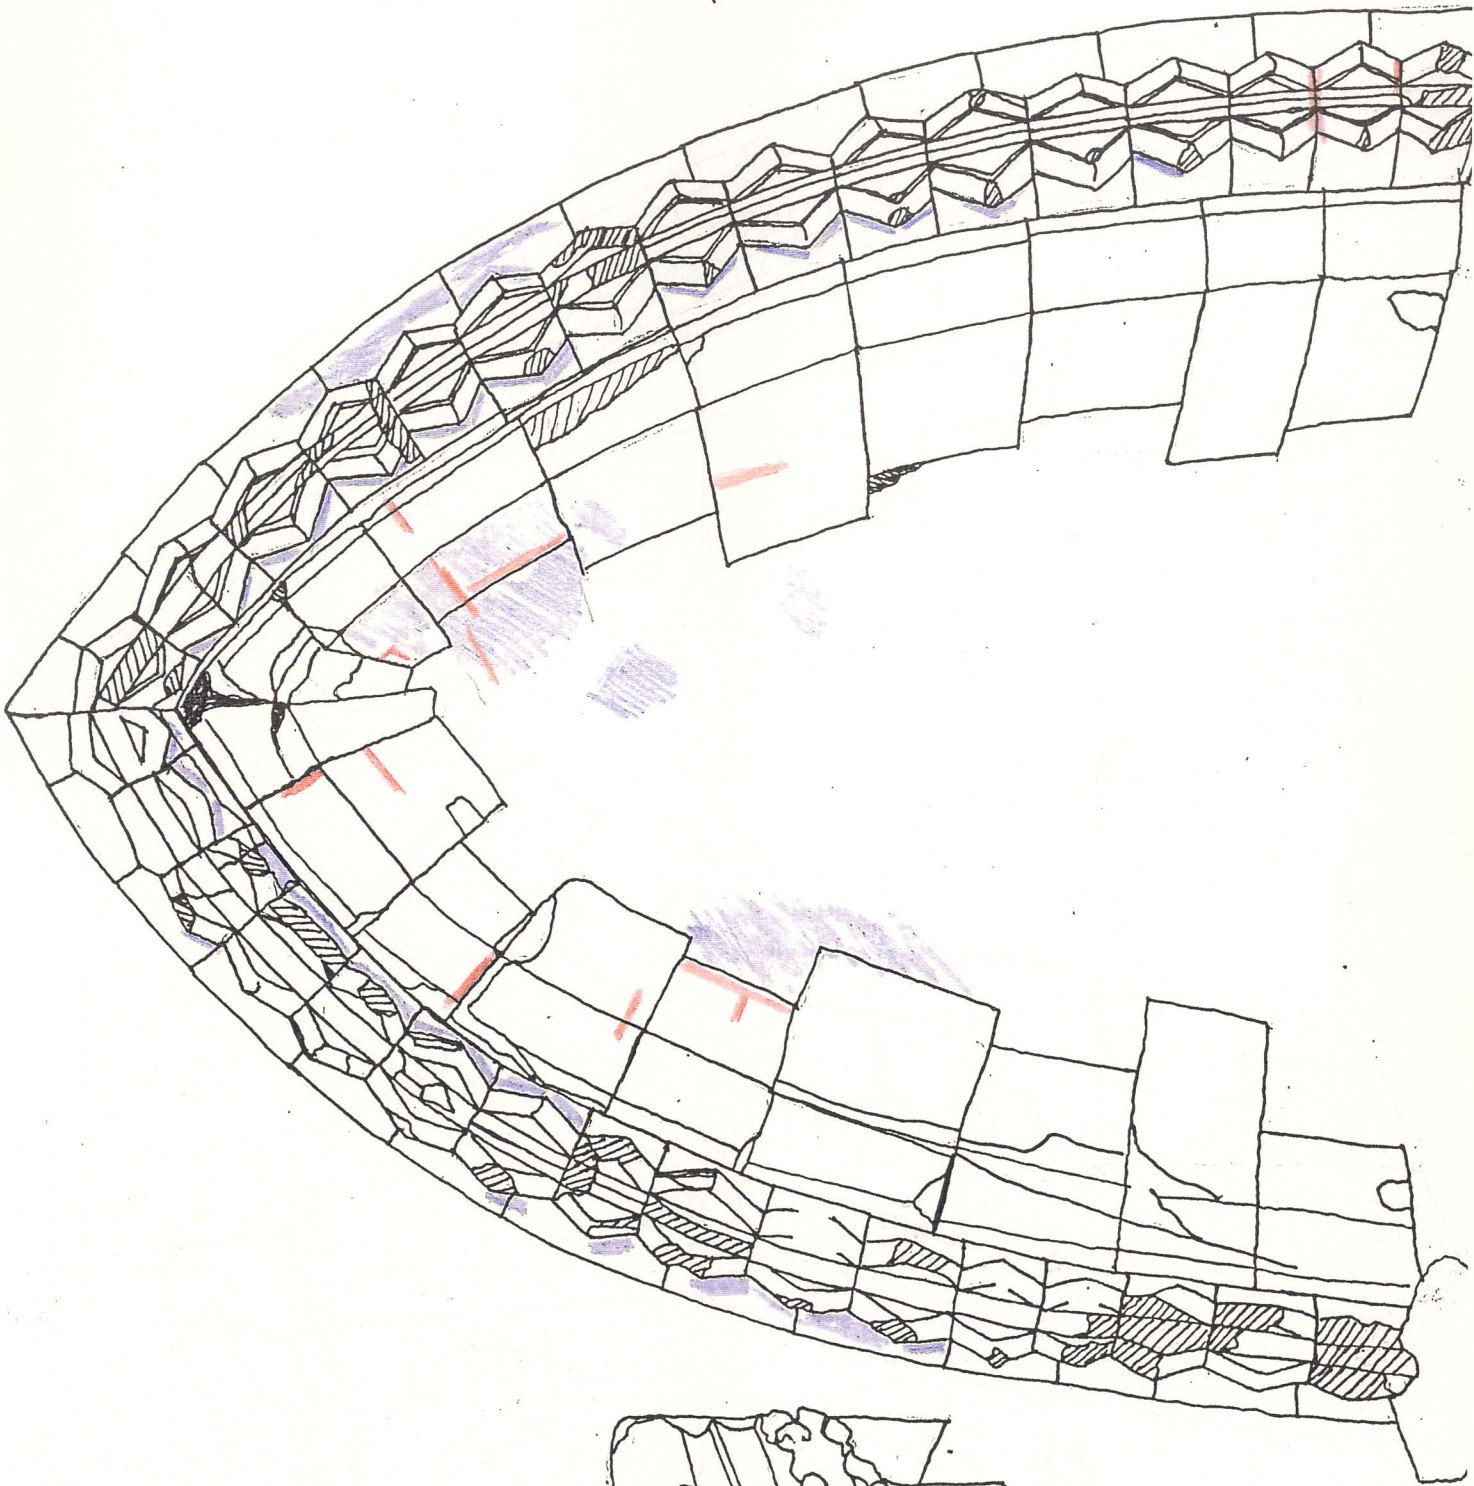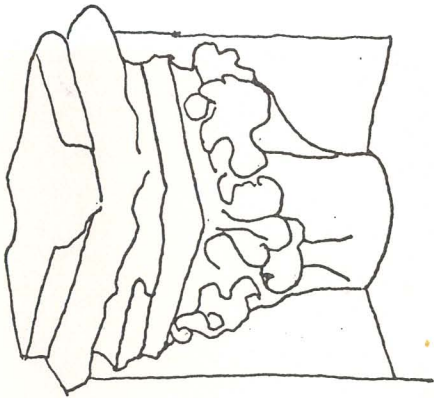

SKETCH

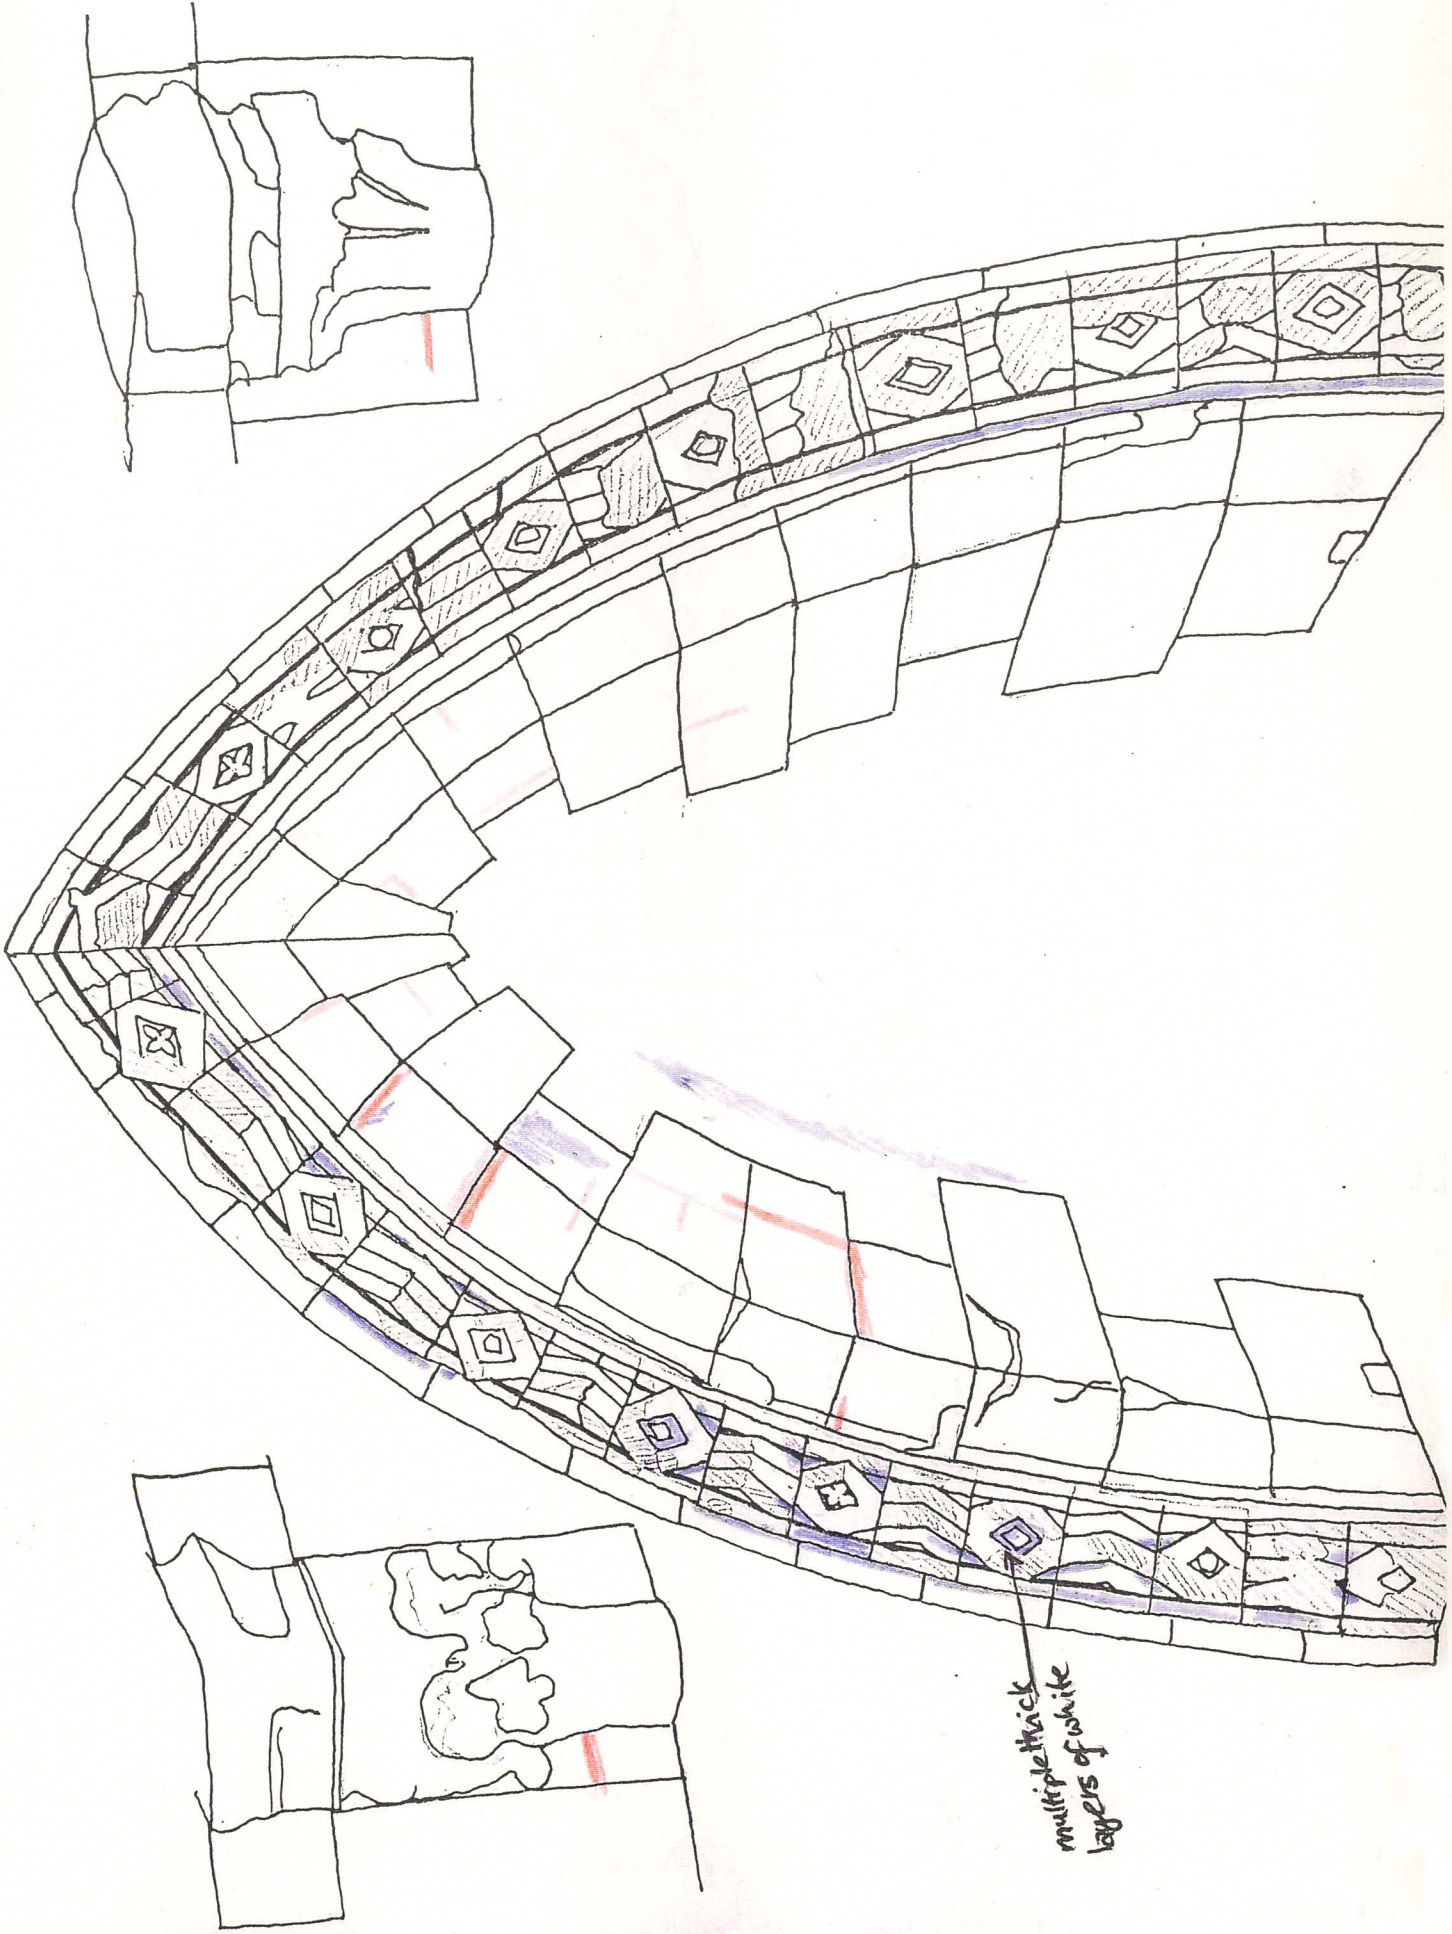


multiple thick  
layers of white





WINDOW 6, NORTH SIDE  
SKETCH.

white  
vermillion

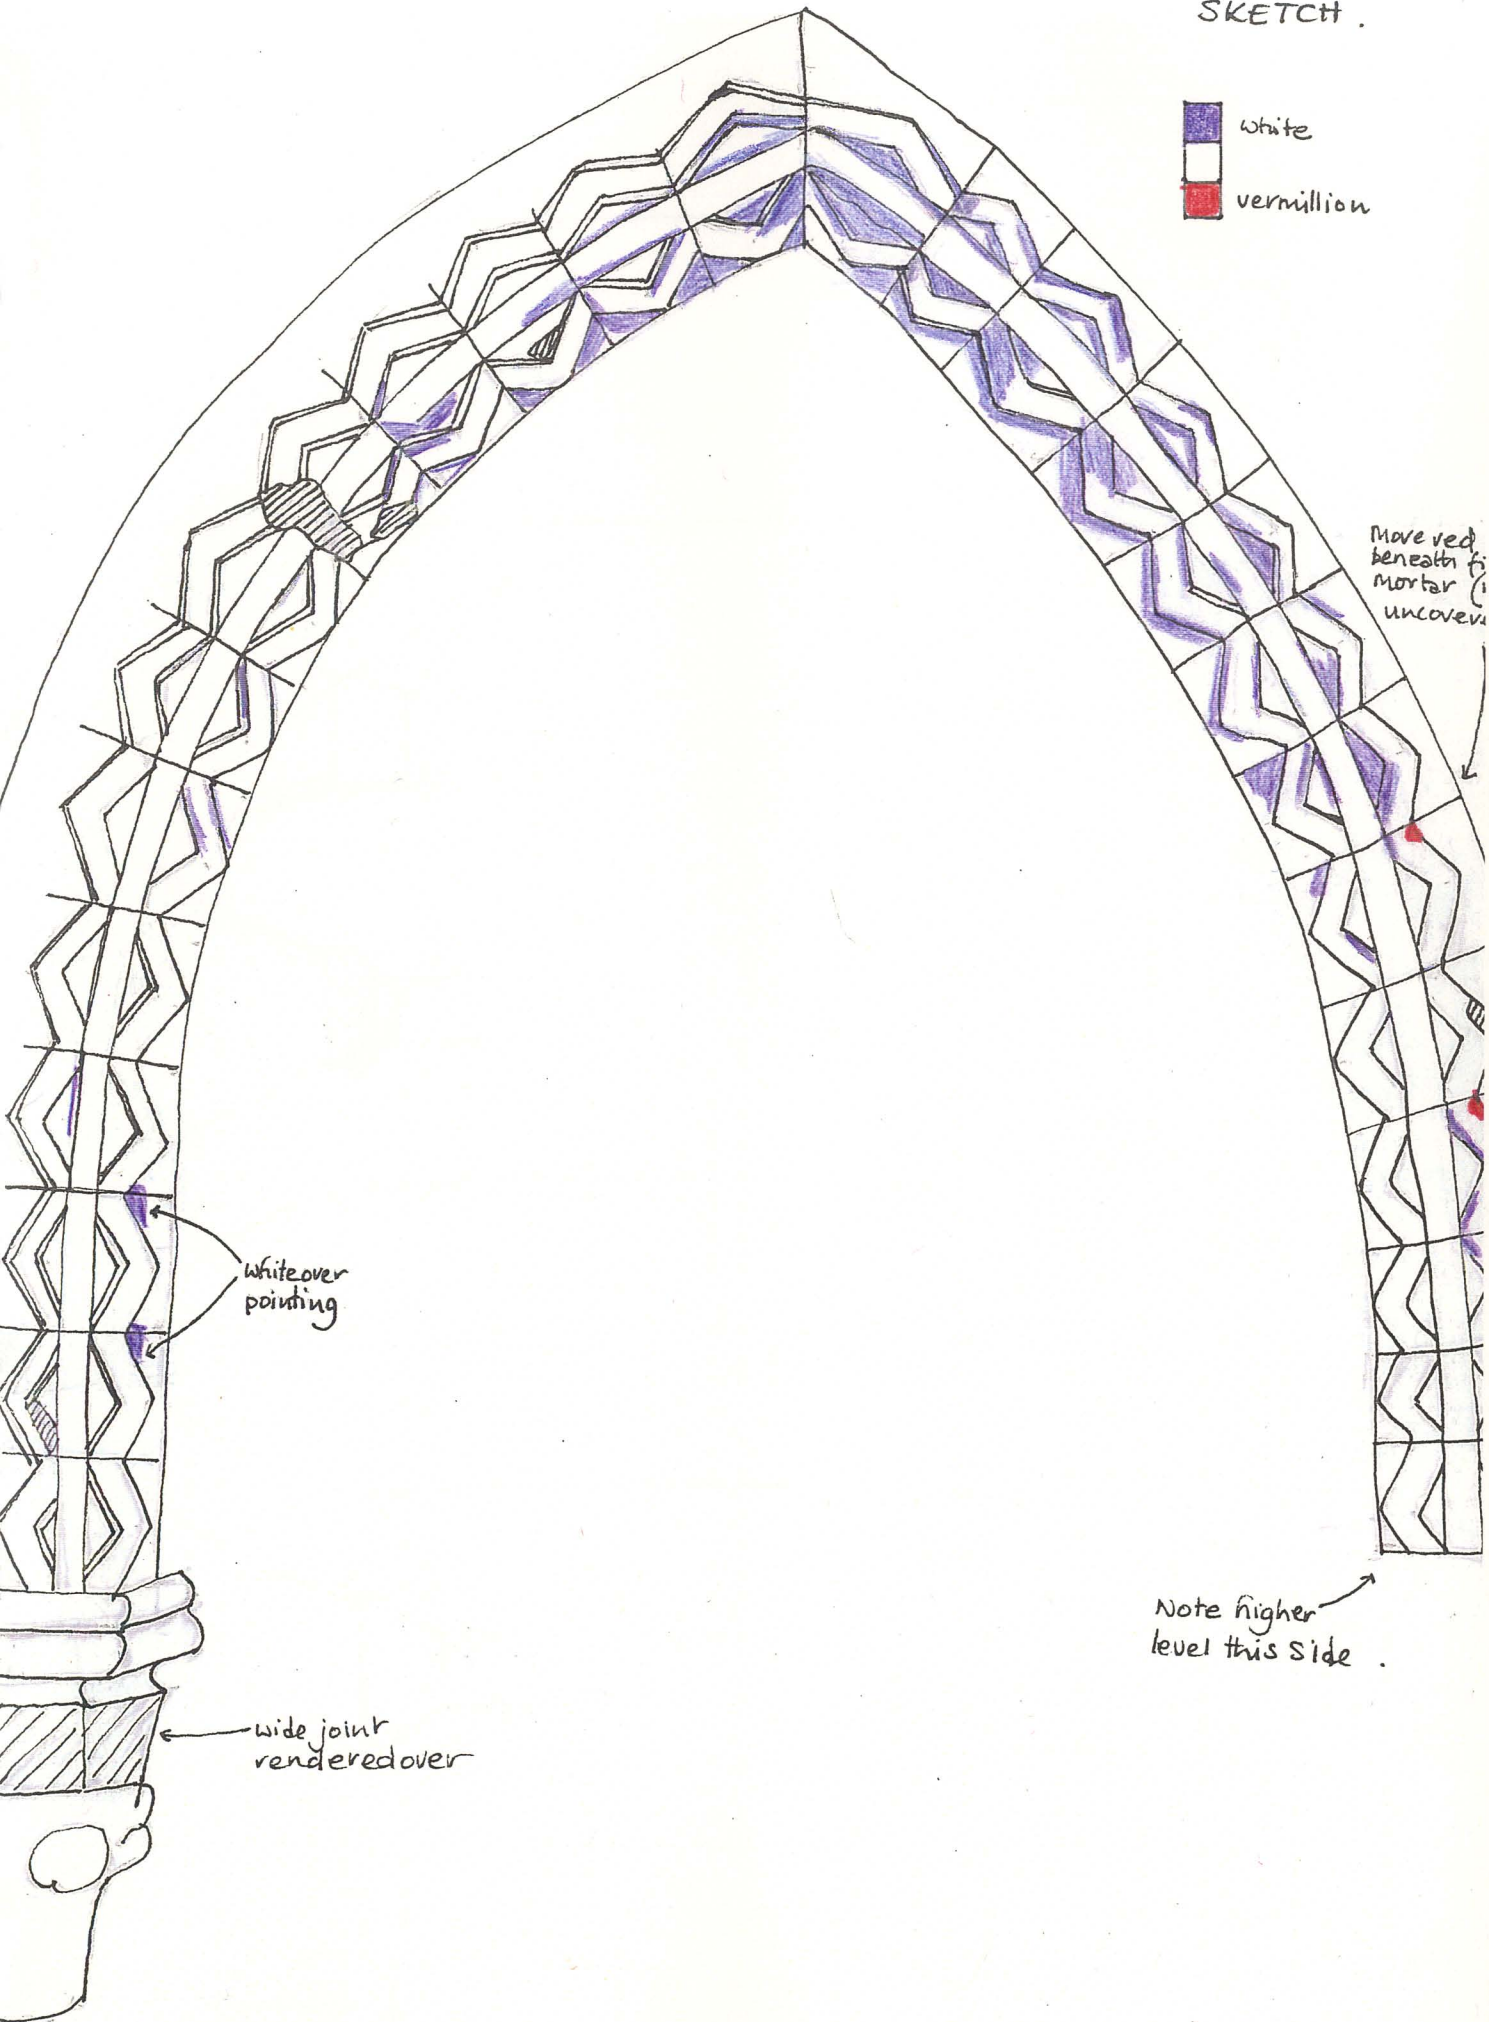


white over pointing

wide joint rendered over

Note higher level this side

Move red beneath mortar uncover



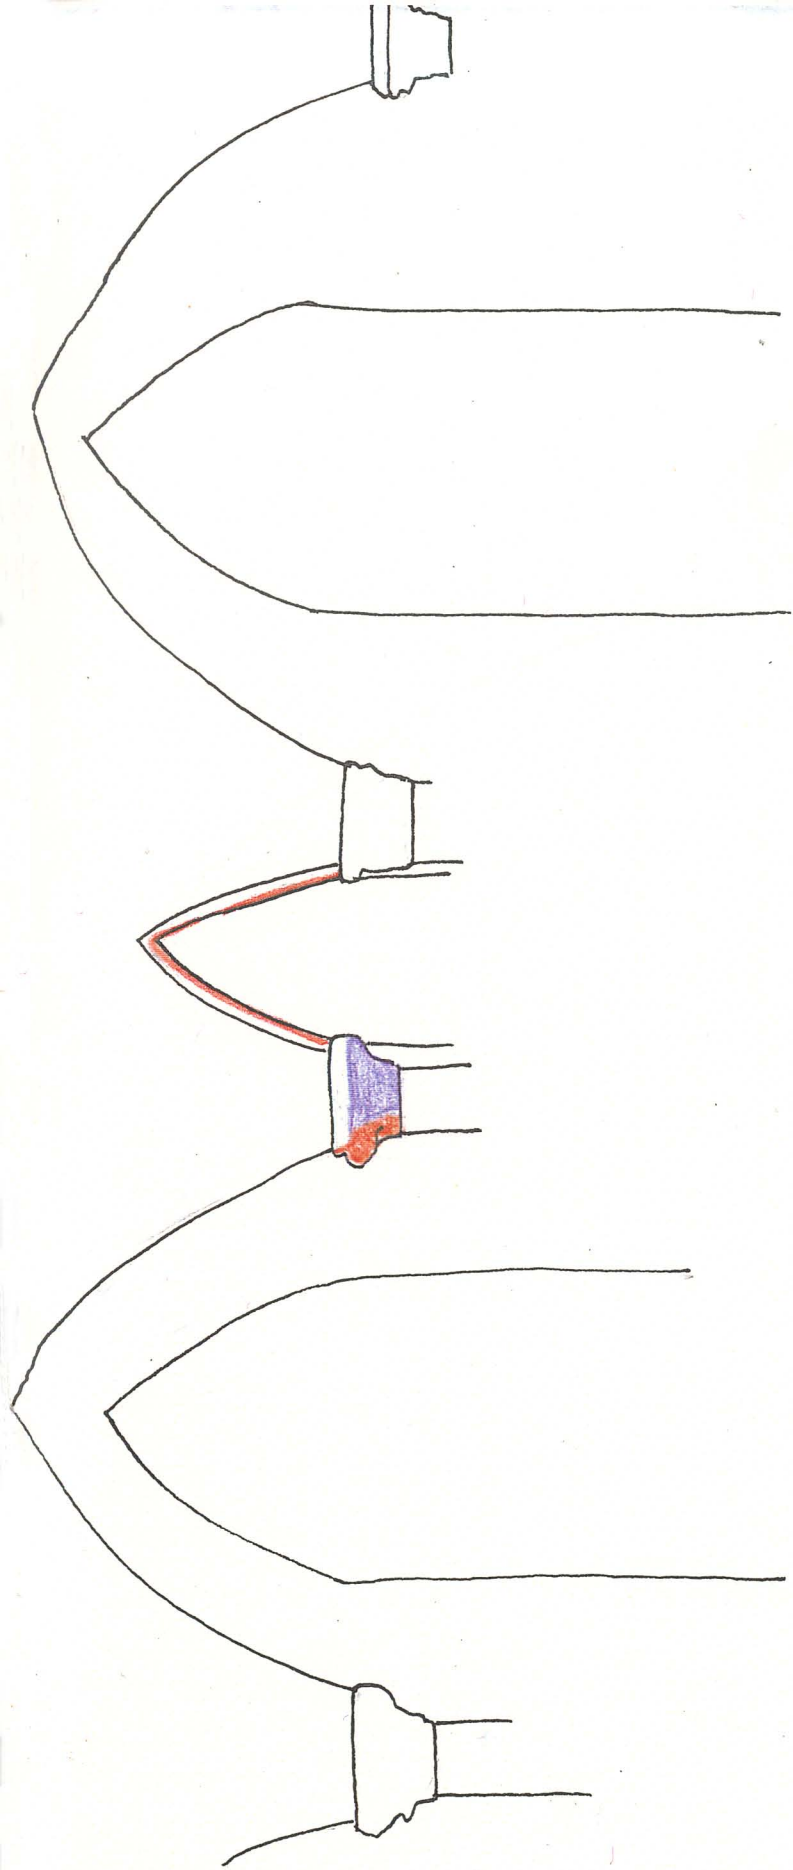

WINDOW 7 - SKETCH  
NORTH SIDE

■ white

