

Amendments		
Issue No.	Date	Description

Site centred on NGR SW 557 371

Reproduced from Ordnance Survey's 1:25 000 map of 1998 with the permission of the controller of Her Majesty's Stationery Office. Crown Copyright reserved. Licence No: A1 50124. Licences: Stratascan Ltd, Vineyard House, Upper Hook Road, Upton Upon Severn, WR8 0SA. OS 100km square = SW


KEY	
	400MHz GPR traverse
	200MHz GPR traverse
	Radiodetection survey area

Job No.	2081	Survey Date	NOV 2005
Client	PELL FRISCHMANN		
Project Title	HARVEY'S FOUNDRY HAYLE, CORNWALL		
Subject	SITE LOCATION AND PLOT OF SURVEYED AREAS		

**STRATASCAN™**  
 GEOPHYSICS FOR ARCHAEOLOGY  
 AND ENGINEERING  
 VINEYARD HOUSE  
 UPPER HOOK ROAD  
 UPTON UPON SEVERN  
 UK  
 WR8 0SA  
 T: +44 (0)1684 592266  
 F: +44 (0)1684 594142  
 E: info@stratascan.co.uk  
 www.stratascan.co.uk


Scale	0m 4 8 12 16 20m		
1:400			
Plot	A1	Checked by	PPB
Date	NOV 2005	Issue No.	01
		Drawn by	HH
		Figure No.	01



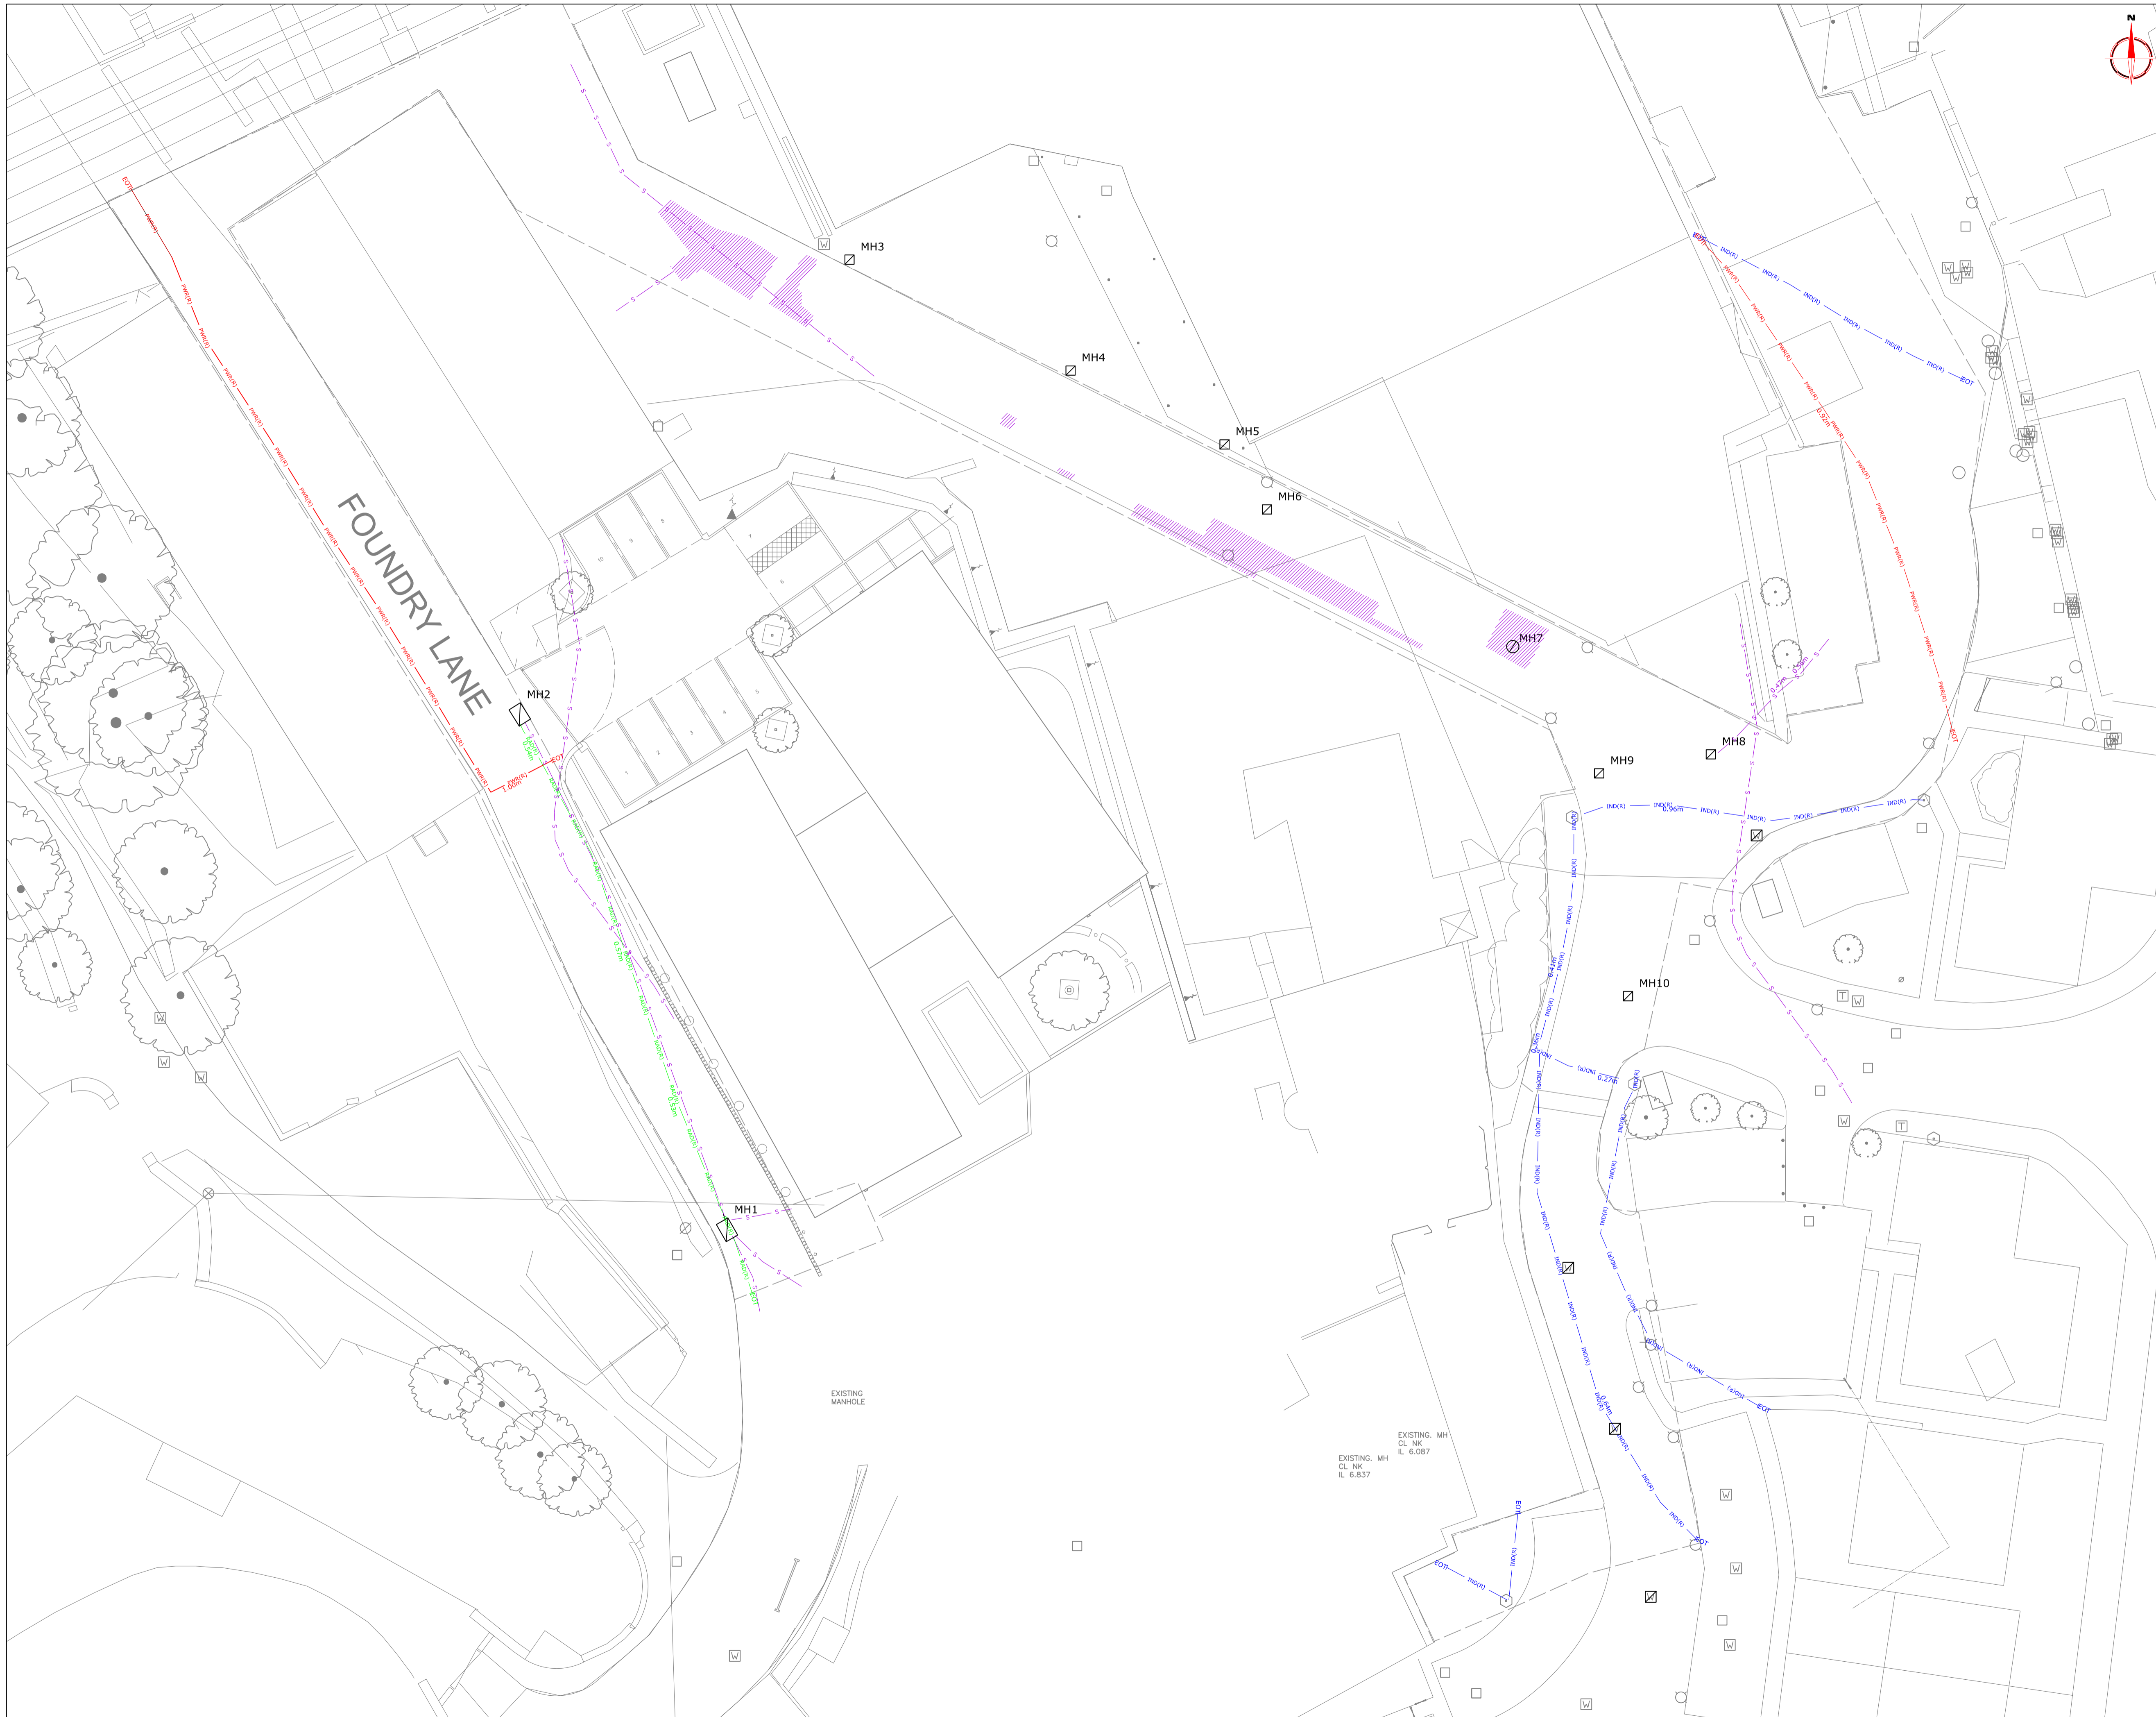


Amendments		
Issue No.	Date	Description
-	-	-
<b>RADIODETECTION-RD433</b> Two methods: <b>ACTIVE:</b> Artificially generated signals from an external source detect metallic services including water and BT. External signals can be applied by either; <b>INDUCTION:</b> of a radiating signal from the internal antenna to any conductors nearby. This method is used when inspection chambers are not accessible for all services, or <b>DIRECT CONNECTION:</b> of a 9/33/65 kHz signal via valves/inspection chambers. Rodding a sonde is an alternative method used to detect pipes where inspection chambers are present. Sometimes the directly applied signal can jump to adjacent services, allowing them to be detected.  <b>PASSIVE:</b> Naturally occurring signals on a conductor provide information of services present. Two modes used are either <b>RADIO:</b> which detects re-radiated radio energy from conductors, or <b>POWER:</b> Current running through a metallic service causes an electromagnetic field that can be detected. This is usually in the frequency range of 50 to 60 Hz. If no current flows through the service no electromagnetic field is created and this method cannot be used to trace the service. Radio mode depends on naturally occurring radio waves through the survey area. If the site is particularly quiet no signal may be re-radiated by the services.		
All depths are measured to the centre of the service, or to the centre of the Sonde if this is being used. The signals detected by Radio mode do not allow a depth estimate to be calculated.		
KEY		
LINETYPES AND ABBREVIATIONS		
	RAD(R)	SERVICE IDENTIFIED IN RADIO MODE
	PWR(R)	SERVICE IDENTIFIED IN POWER MODE
	IND(R)	SERVICE IDENTIFIED IN INDUCED MODE
	S	SERVICE SCAR
		RADIODETECTION SURVEY EXTENT
	EOT	END OF TRACE
	0.26m	APPROXIMATE DEPTH OF COVER (m)
<small>N.B. THE UTILITY SURVEY INFORMATION ON THIS PLAN HAS BEEN PRODUCED USING GPR AND ELECTRO-MAGNETIC LOCATING TECHNIQUES. ALTHOUGH BEING THE MOST ACCURATE AVAILABLE, SIGNALS ARE SUSCEPTIBLE TO DISTORTION ON THE SURFACE ESPECIALLY IN CONGESTED AREAS. THERE MAY ALSO BE NON-METALLIC SERVICES AND METALLIC SERVICES PRODUCING INSUFFICIENT SIGNALS FOR ACCURATE LOCATION USING ELECTRO-MAGNETIC TECHNIQUES. WHILEST GPR SHOULD DETECT BOTH METALLIC AND NON-METALLIC SERVICES, INDIVIDUAL SERVICES WITHIN CONGESTED AND COMPLEX AREAS MAY BE OBTUSCED. WHILEST EVERY EFFORT HAS BEEN MADE TO PRODUCE AN ACCURATE PLAN OF THE BURIED SERVICES WITHIN THE SURVEY AREA, CRUCIAL DIMENSIONS AND DEPTHS SHOULD BE CHECKED. EXTREME CAUTION SHOULD BE TAKEN WHEN ANY EXCAVATION IS UNDERTAKEN - THE INFORMATION CONTAINED WITHIN THIS PLAN MAY NOT REPRESENT THE TOTAL NUMBER OF SERVICES CONTAINED WITHIN THE SURVEY AREA. HEALTH AND SAFETY GUIDELINES SHOULD BE FOLLOWED PRIOR TO EXCAVATION.</small>		
Job No.	2081	Survey Date NOV 2005
Client	PELL FRISCHMANN	
Project Title	HARVEY'S FOUNDRY HAYLE, CORNWALL	
Subject	RADIODETECTION SOUTH	
<b>STRATASCAN™</b> GEOPHYSICS FOR ARCHAEOLOGY AND ENGINEERING VINEYARD HOUSE UPPER HOOK ROAD UPTON UPON SEVERN UK WR8 0SA T: +44 (0)1684 592266 F: +44 (0)1684 594142 E: info@stratascan.co.uk www.stratascan.co.uk		
Scale	0m 2 4 6 8 10m	
1:200		
Plot	Checked by	Issue No.
A1	PPB	01
Date	Drawn by	Figure No.
NOV 2005	HH	02



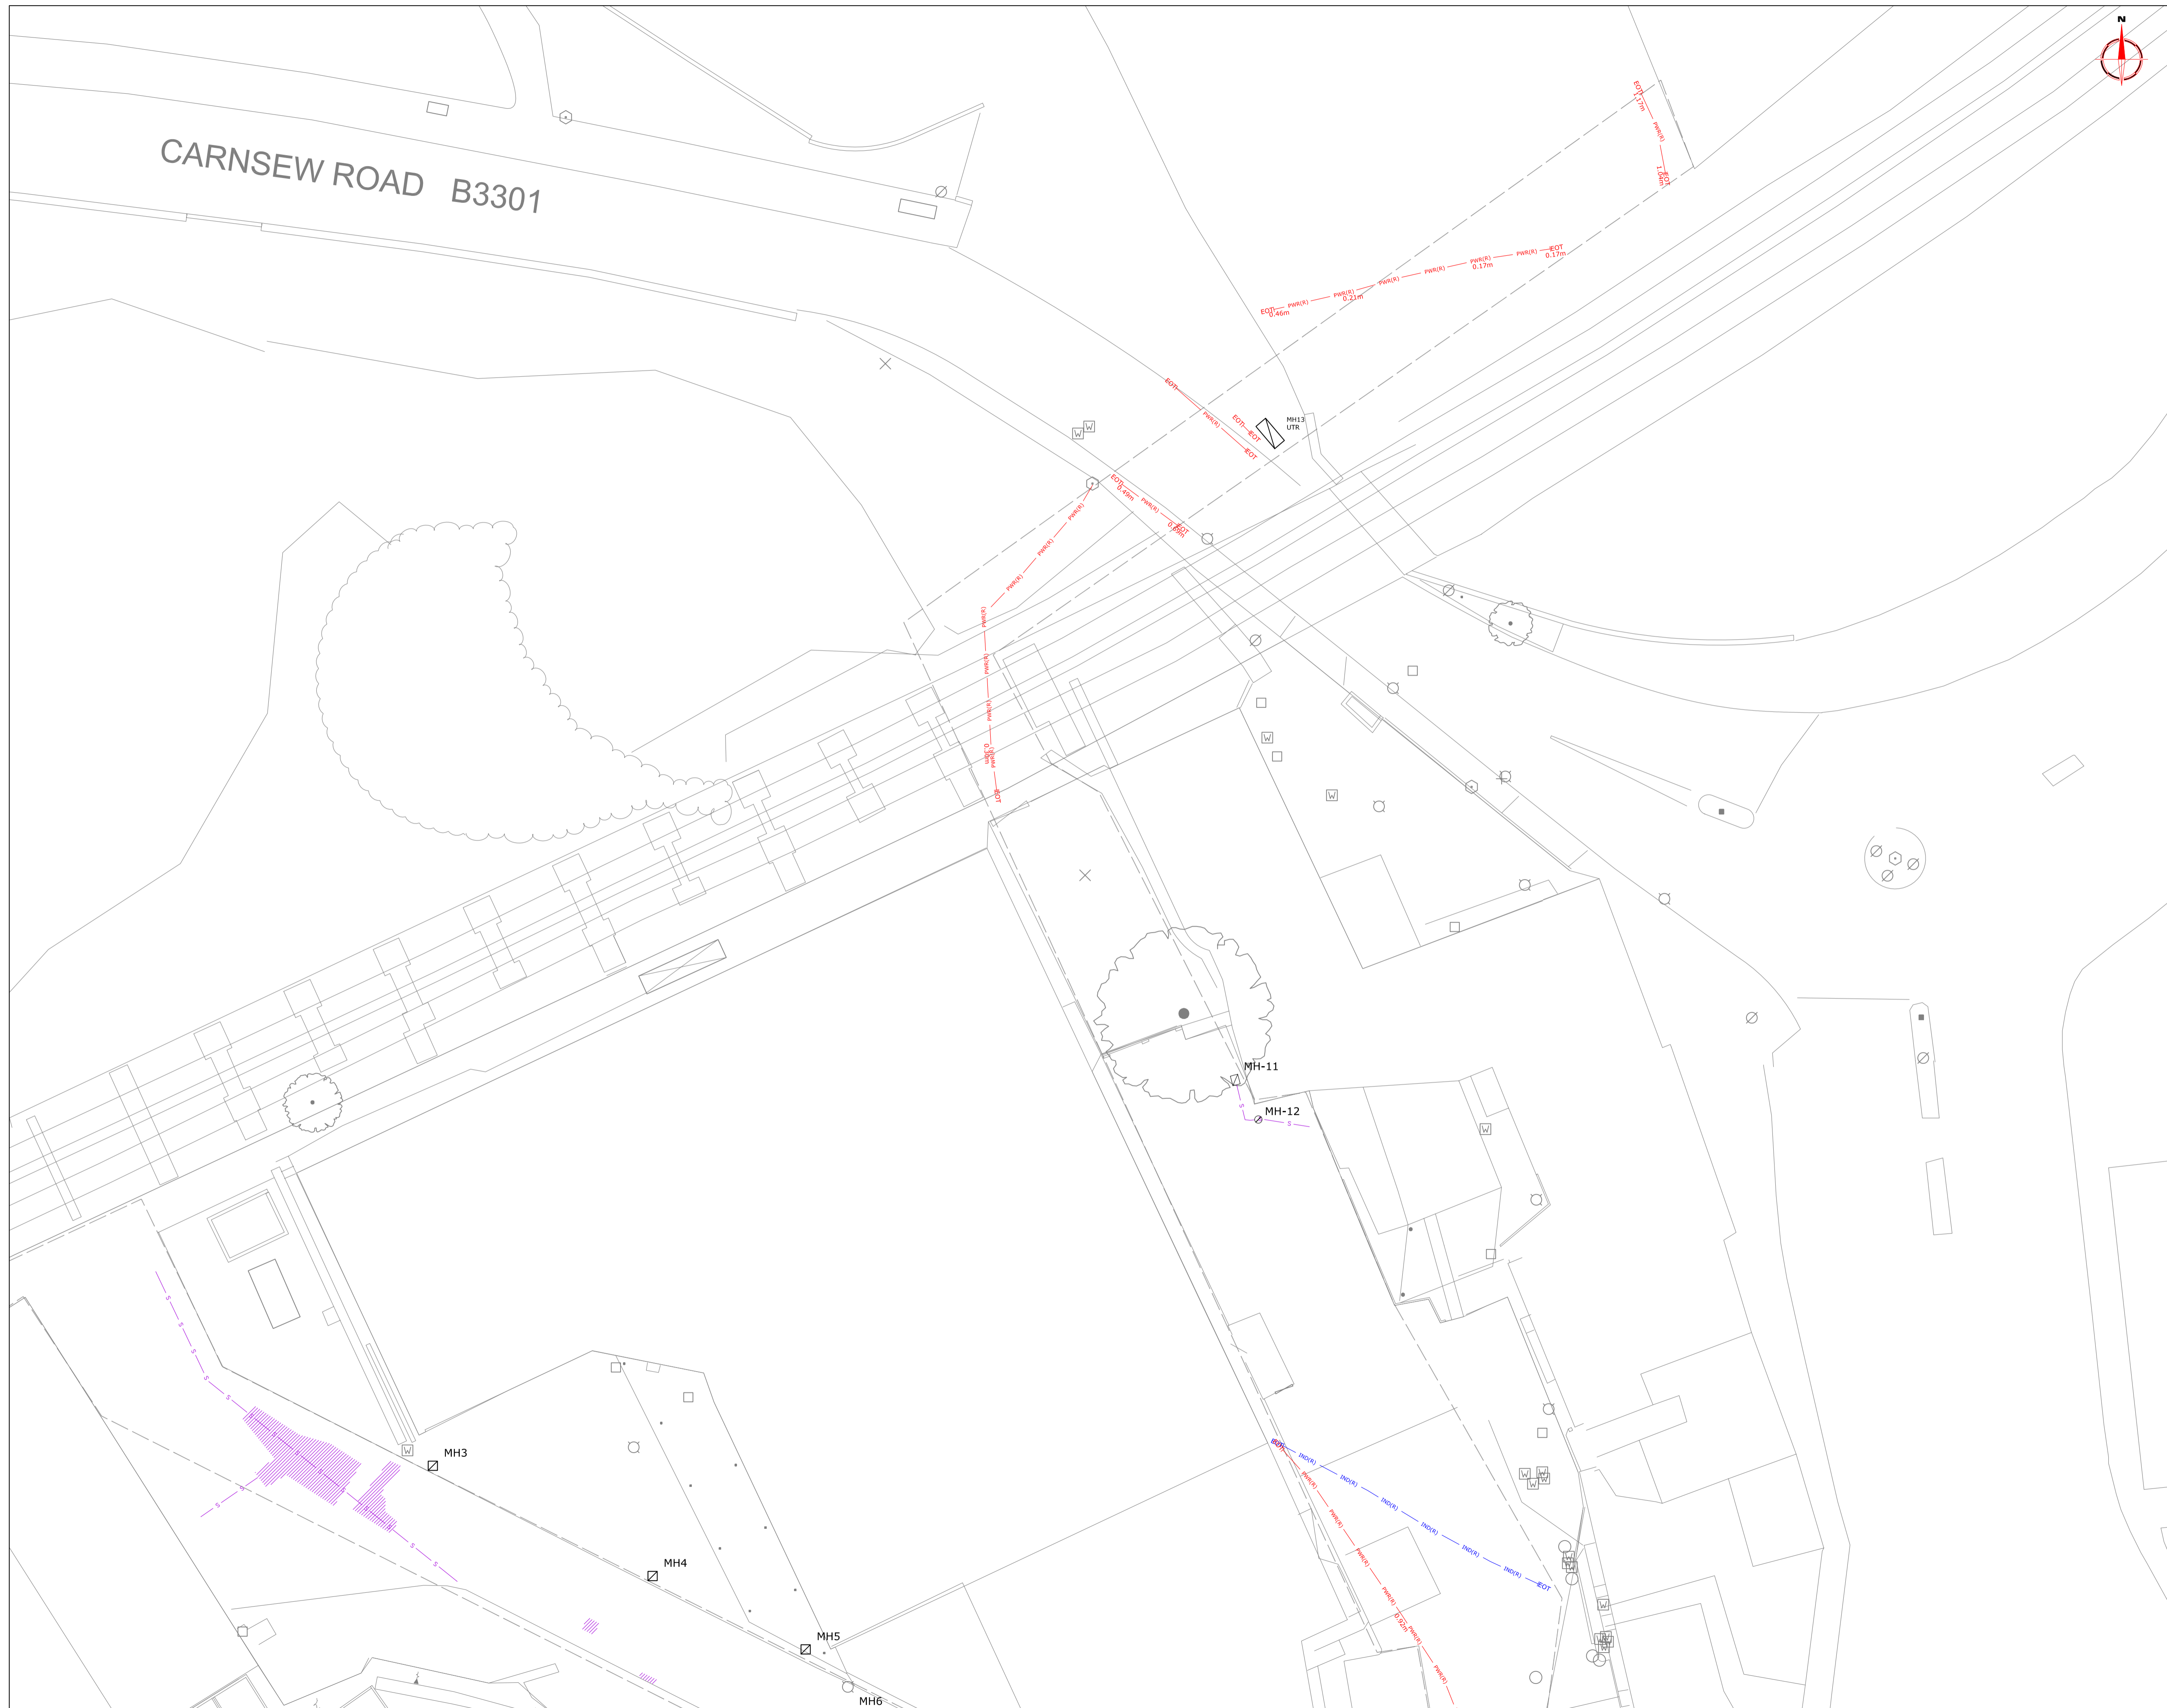

Amendments		
Issue No.	Date	Description
-	-	-
<b>RADIODETECTION-RD433</b> Two methods: <b>ACTIVE:</b> Artificially generated signals from an external source detect metallic services including water and BT. External signals can be applied by either; <b>INDUCTION:</b> of a radiating signal from the internal antenna to any conductors nearby. This method is used when inspection chambers are not accessible for all services, or <b>DIRECT CONNECTION:</b> of a 8/33/65 kHz signal via valves/inspection chambers. Rodding a sonde is an alternative method used to detect pipes where inspection chambers are present. Sometimes the directly applied signal can jump to adjacent services, allowing them to be detected.  <b>PASSIVE:</b> Naturally occurring signals on a conductor provide information of services present. Two modes used are either <b>RADIO:</b> which detects re-radiated radio energy from conductors, or <b>POWER:</b> Current running through a metallic service causes an electromagnetic field that can be detected. This is usually in the frequency range of 50 to 60 Hz. If no current flows through the service no electromagnetic field is created and this method cannot be used to trace the service. Radio mode depends on naturally occurring radiowaves through the survey area. If the site is particularly quiet no signal may be re-radiated by the services.  All depths are measured to the centre of the service, or to the centre of the Sonde if this is being used. The signals detected by Radio mode do not allow a depth estimate to be calculated.		
KEY		
LINETYPES AND ABBREVIATIONS		
	<b>RAD(R)</b>	SERVICE IDENTIFIED IN RADIO MODE
	<b>PWR(R)</b>	SERVICE IDENTIFIED IN POWER MODE
	<b>IND(R)</b>	SERVICE IDENTIFIED IN INDUCED MODE
	<b>S</b>	SERVICE SCAR
		RADIODETECTION SURVEY EXTENT
	<b>EOT</b>	END OF TRACE
	<b>0.26m</b>	APPROXIMATE DEPTH OF COVER (m)
<small>N.B. THE UTILITY SURVEY INFORMATION ON THIS PLAN HAS BEEN PRODUCED USING GPR AND ELECTRO-MAGNETIC LOCATING TECHNIQUES. ALTHOUGH BEING THE MOST ACCURATE AVAILABLE, SIGNALS ARE SUSCEPTIBLE TO DISTORTION ON THE SURFACE ESPECIALLY IN CONGESTED AREAS. THERE MAY ALSO BE NON-METALLIC SERVICES AND METALLIC SERVICES PRODUCING INSUFFICIENT SIGNALS FOR ACCURATE LOCATION USING ELECTRO-MAGNETIC TECHNIQUES. WHILEST GPR SHOULD DETECT BOTH METALLIC AND NON-METALLIC SERVICES, INDIVIDUAL SERVICES WITHIN CONGESTED AND COMPLEX AREAS MAY BE OBTUSCURED. WHILEST EVERY EFFORT HAS BEEN MADE TO PRODUCE AN ACCURATE PLAN OF THE BURIED SERVICES WITHIN THE SURVEY AREA, CRUCIAL DIMENSIONS AND DEPTHS SHOULD BE CHECKED. EXTREME CAUTION SHOULD BE TAKEN WHEN ANY EXCAVATION IS UNDERTAKEN - THE INFORMATION CONTAINED WITHIN THIS PLAN MAY NOT REPRESENT THE TOTAL NUMBER OF SERVICES CONTAINED WITHIN THE SURVEY AREA, HEALTH AND SAFETY GUIDELINES SHOULD BE FOLLOWED PRIOR TO EXCAVATION.</small>		
Job No.	2081	Survey Date NOV 2005
Client	PELL FRISCHMANN	
Project Title	HARVEY'S FOUNDRY HAYLE, CORNWALL	
Subject	RADIODETECTION NORTH	
<b>STRATASCAN™</b> GEOPHYSICS FOR ARCHAEOLOGY AND ENGINEERING VINEYARD HOUSE UPPER HOOK ROAD UPTON UPON SEVERN UK WR8 0SA T: +44 (0)1684 592266 F: +44 (0)1684 594142 E: info@stratascan.co.uk www.stratascan.co.uk		
Scale	0m 2 4 6 8 10m	
1:200		
Plot	Checked by PPB	Issue No. 01
Date NOV 2005	Drawn by HH	Figure No. 03



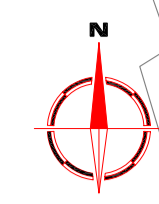

**Amendments**

Issue No.	Date	Description
-	-	-

**Radar Abstraction**

<span style="color: blue;">█</span>	Strong Discrete
<span style="color: lightblue;">█</span>	Weak Discrete
<span style="color: brown;">█</span>	Strong Complex
<span style="color: orange;">█</span>	Weak Complex
<span style="color: magenta;">█</span>	Point Diffraction
<span style="color: pink;">█</span>	Broad Crested
<span style="color: green;">█</span>	Strong Planar
<span style="color: lightgreen;">█</span>	Weak Planar
<span style="color: yellow;">█</span>	Conductive Surface
<span style="color: black;">→</span>	Inclined Event

0.25 Depth to top of feature (m)  
 Job No. **2081** Survey Date **NOV 2005**

Client  
**PELL FRISCHMANN**

Project Title  
**HARVEY'S FOUNDRY  
 HAYLE, CORNWALL**

Subject  
**GPR ABSTRACTION  
 400MHz SOUTH**

**STRATASCAN™**  
 GEOPHYSICS FOR ARCHAEOLOGY  
 AND ENGINEERING  
 VINEYARD HOUSE  
 UPPER HOOK ROAD  
 UPTON UPON SEVERN  
 UK  
 WR8 0SA  
 T: +44 (0)1684 592266  
 F: +44 (0)1684 594142  
 E: info@stratascan.co.uk  
 www.stratascan.co.uk




Scale  
**1:200**  
 0m 2 4 6 8 10m

Plot <b>A1</b>	Checked by <b>PPB</b>	Issue No. <b>01</b>
Date <b>NOV 2005</b>	Drawn by <b>HH</b>	Figure No. <b>04</b>





CARNSEW ROAD B3301

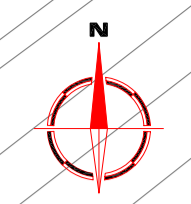

**Amendments**

Issue No.	Date	Description
-	-	-

**Radar Abstraction**

<span style="color: blue;">█</span>	Strong Discrete
<span style="color: lightblue;">█</span>	Weak Discrete
<span style="color: brown;">█</span>	Strong Complex
<span style="color: orange;">█</span>	Weak Complex
<span style="color: magenta;">●</span>	Point Diffraction
<span style="color: pink;">█</span>	Broad Crested
<span style="color: green;">█</span>	Strong Planar
<span style="color: lightgreen;">█</span>	Weak Planar
<span style="color: yellow;">█</span>	Conductive Surface
<span style="color: black;">→</span>	Inclined Event
0.25 Depth to top of feature (m)	

Job No. **2081** Survey Date **NOV 2005**

Client  
**PELL FRISCHMANN**

Project Title  
**HARVEY'S FOUNDRY  
HAYLE, CORNWALL**


Subject  
**GPR ABSTRACTION  
400MHz NORTH**

**STRATASCAN™**  
 GEOPHYSICS FOR ARCHAEOLOGY  
 AND ENGINEERING  
 VINEYARD HOUSE  
 UPPER HOOK ROAD  
 UPTON UPON SEVERN  
 UK  
 WR8 0SA  
 T: +44 (0)1684 592266  
 F: +44 (0)1684 594142  
 E: info@stratascan.co.uk  
 www.stratascan.co.uk

Scale  
**1:200**

Plot <b>A1</b>	Checked by <b>PPB</b>	Issue No. <b>01</b>
Date <b>NOV 2005</b>	Drawn by <b>HH</b>	Figure No. <b>05</b>



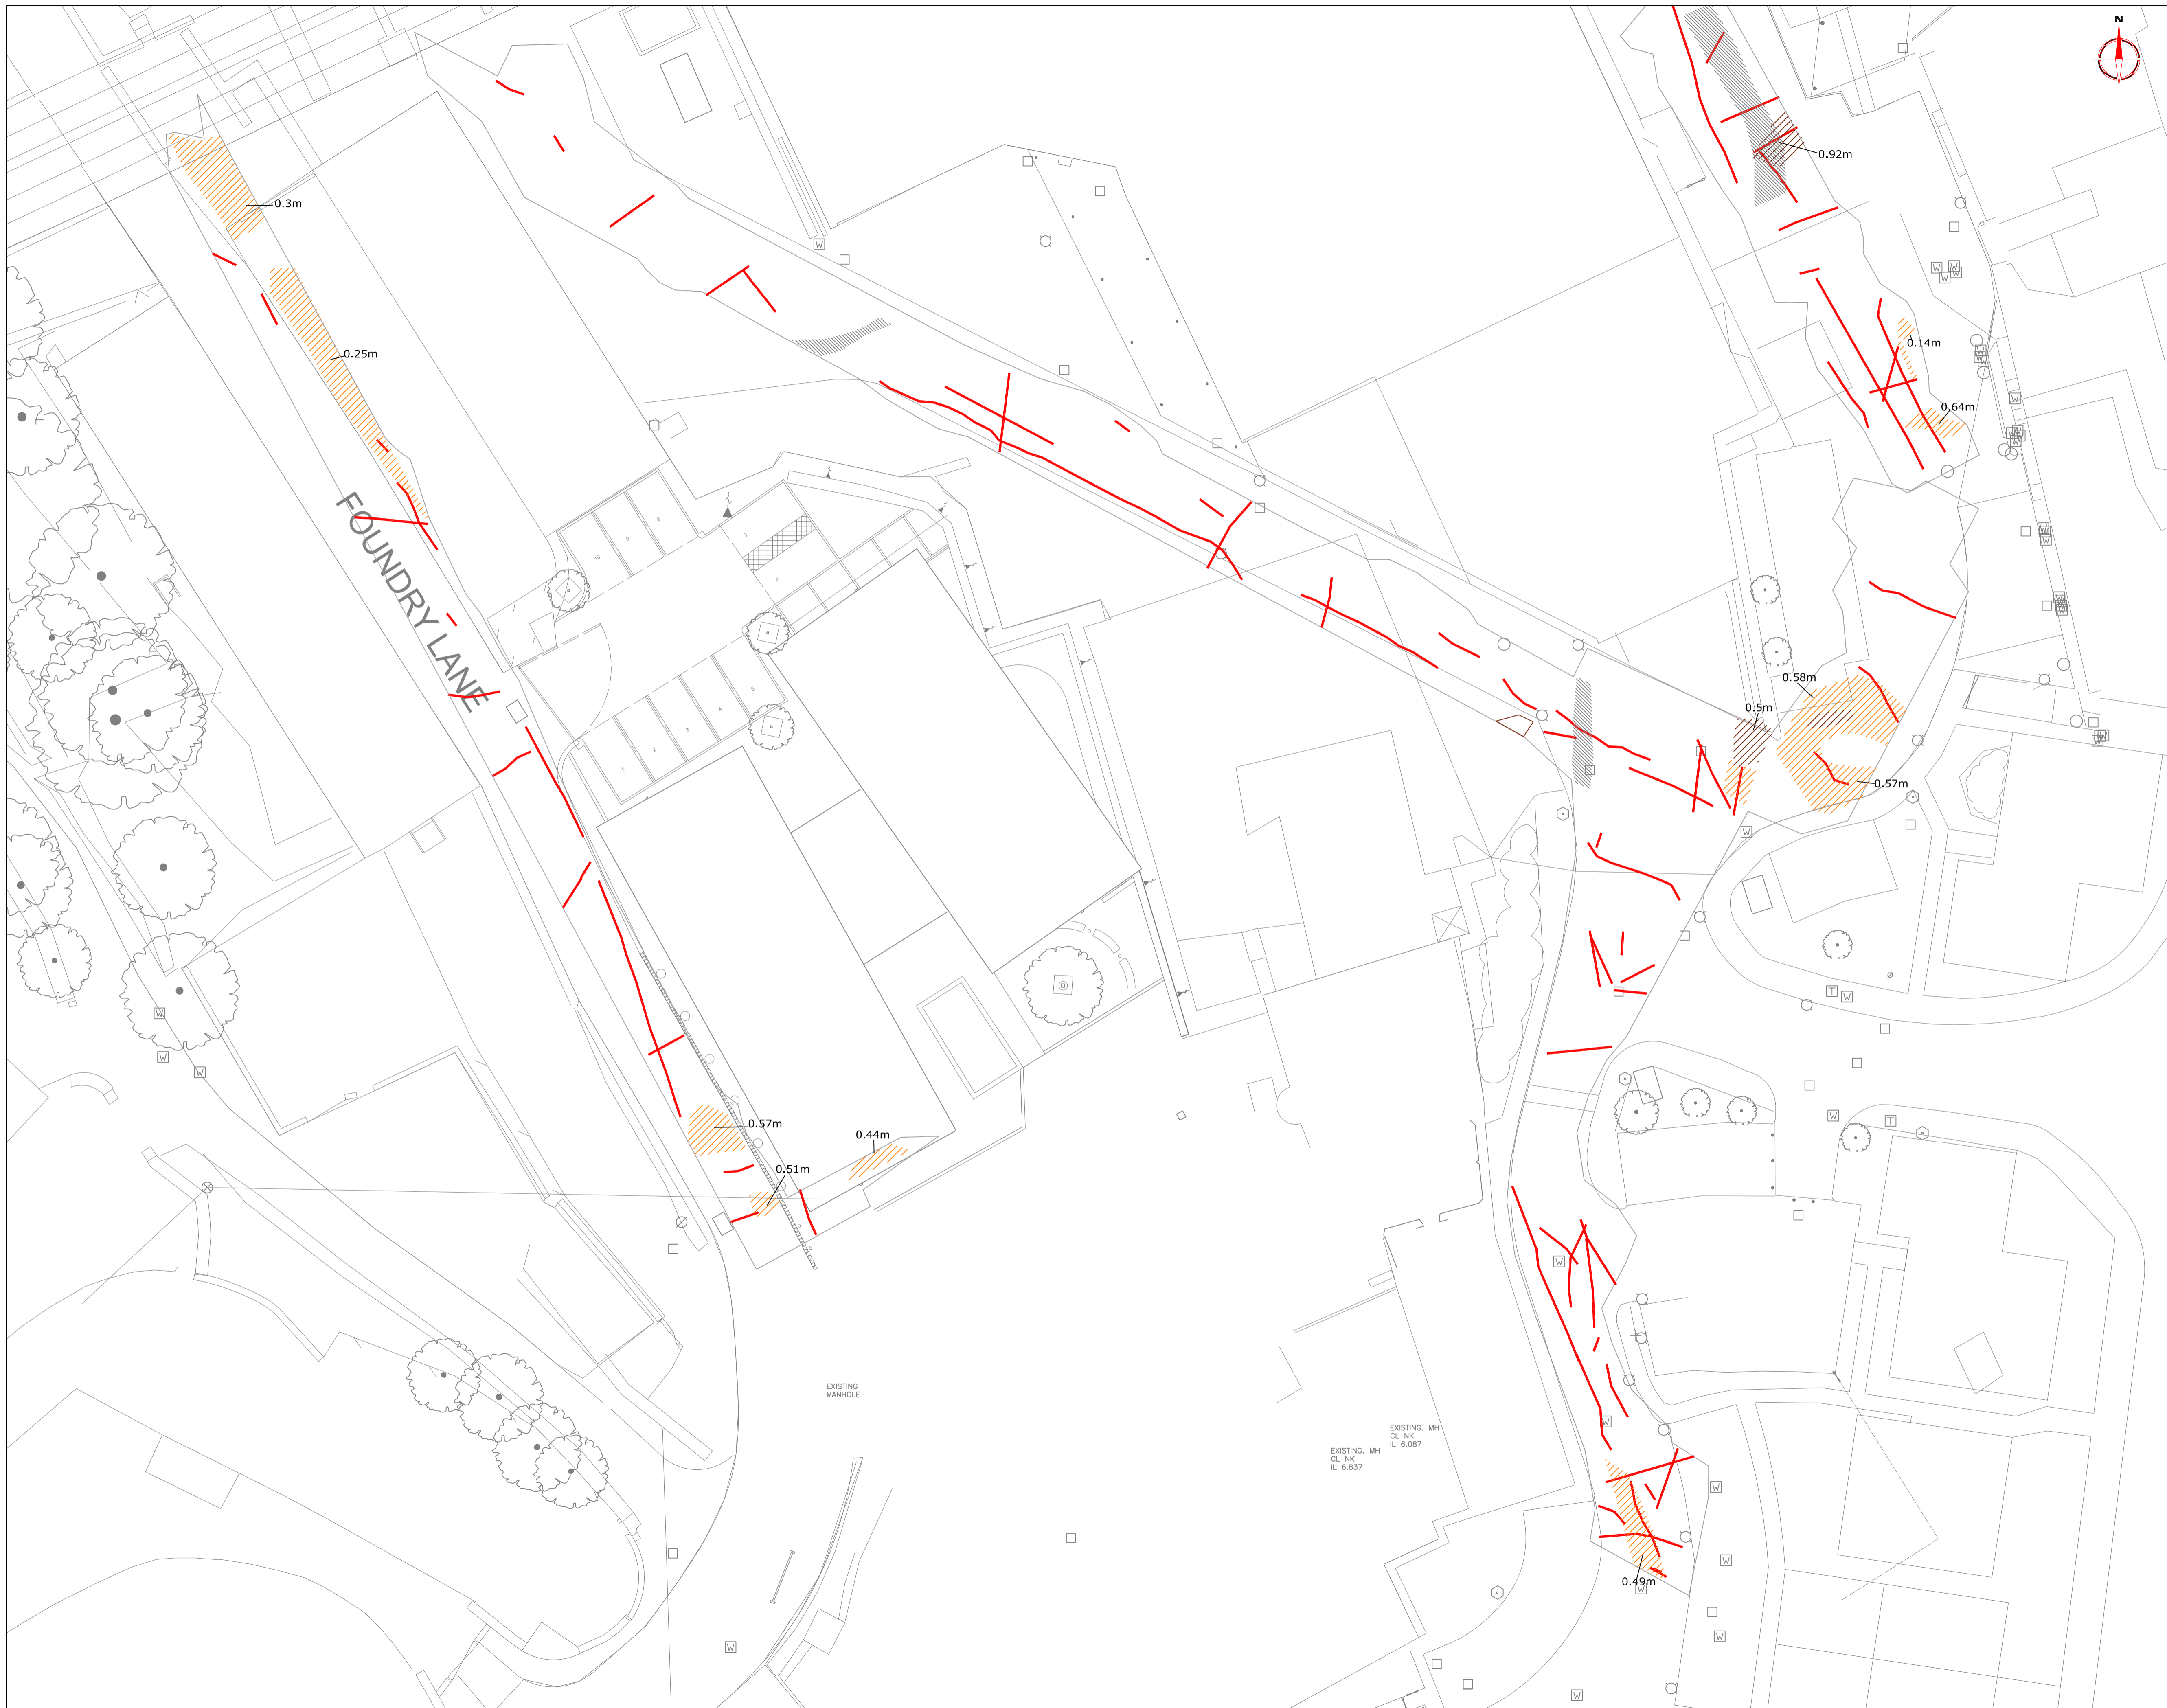

Amendments		
Issue No.	Date	Description

Radar Interpretation	
	Possible service
	Possible service trench
	Strong complex anomaly - possible structural debris of archaeological origin
	Weak complex response - area of ground disturbance of modern or archaeological origin
	Inclined event - area of ground disturbance of modern or archaeological origin
0.36m	Approximate depth to top of anomaly (m)

Job No.	2081	Survey Date	NOV 2005
Client	PELL FRISCHMANN		
Project Title	HARVEY'S FOUNDRY HAYLE, CORNWALL		
Subject	GPR INTERPRETATION 400MHZ SOUTH		

**STRATASCAN™**  
 GEOPHYSICS FOR ARCHAEOLOGY  
 AND ENGINEERING  
 VINEYARD HOUSE  
 UPPER HOOK ROAD  
 UPTON UPON SEVERN  
 UK  
 WR8 0SA  
 T: +44 (0)1684 592266  
 F: +44 (0)1684 594142  
 E: info@stratascan.co.uk  
 www.stratascan.co.uk


Scale  
**1:200**  
 0m 2 4 6 8 10m

Plot	A1	Checked by	PPB	Issue No.	01
Date	NOV 2005	Drawn by	HH/NG	Figure No.	06





CARNSEW ROAD B3301

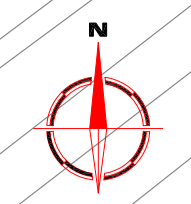

Amendments

Issue No.	Date	Description
-	-	-

Radar Interpretation

- Possible service
- Possible service trench
- Strong complex anomaly - possible structural debris of archaeological origin
- Weak complex response - area of ground disturbance of modern or archaeological origin
- Inclined event - area of ground disturbance of modern or archaeological origin
- Strong discrete anomaly- possible structural remains

0.36m Approximate depth to top of anomaly (m)

Job No.	2081	Survey Date	NOV 2005
---------	------	-------------	----------

Client  
**PELL FRISCHMANN**

Project Title  
**HARVEY'S FOUNDRY  
HAYLE, CORNWALL**


Subject  
**GPR INTERPRETATION 400MHZ  
NORTH**

**STRATASCAN™**  
 GEOPHYSICS FOR ARCHAEOLOGY  
 AND ENGINEERING  
 VINEYARD HOUSE  
 UPPER HOOK ROAD  
 UPTON UPON SEVERN  
 UK  
 WR8 0SA  
 T: +44 (0)1684 592266  
 F: +44 (0)1684 594142  
 E: info@stratascan.co.uk  
 www.stratascan.co.uk

Scale  
**1:200**

Plot	A1	Checked by	PPB	Issue No.	01
Date	NOV 2005	Drawn by	HH/NG	Figure No.	07



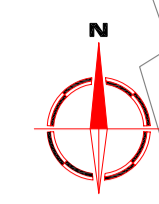

**Amendments**

Issue No.	Date	Description
-	-	-

**Radar Abstraction**

<span style="color: blue;">█</span>	Strong Discrete
<span style="color: lightblue;">█</span>	Weak Discrete
<span style="color: brown;">█</span>	Strong Complex
<span style="color: orange;">█</span>	Weak Complex
<span style="color: magenta;">●</span>	Point Diffraction
<span style="color: pink;">█</span>	Broad Crested
<span style="color: green;">█</span>	Strong Planar
<span style="color: lightgreen;">█</span>	Weak Planar
<span style="color: yellow;">█</span>	Conductive Surface
<span style="color: black;">→</span>	Inclined Event

0.25 Depth to top of feature (m)

Job No.	2081	Survey Date	NOV 2005
---------	------	-------------	----------

Client  
**PELL FRISCHMANN**

Project Title  
**HARVEY'S FOUNDRY  
HAYLE, CORNWALL**

Subject  
**GPR ABSTRACTION  
200MHz SOUTH**

**STRATASCAN™**  
 GEOPHYSICS FOR ARCHAEOLOGY  
 AND ENGINEERING  
 VINEYARD HOUSE  
 UPPER HOOK ROAD  
 UPTON UPON SEVERN  
 UK  
 WR8 0SA  
 T: +44 (0)1684 592266  
 F: +44 (0)1684 594142  
 E: info@stratascan.co.uk  
 www.stratascan.co.uk

Scale  
**1:200**

Plot	A1	Checked by	PPB	Issue No.	01
Date	NOV 2005	Drawn by	NG	Figure No.	08





Amendments		
Issue No.	Date	Description
-	-	-
-	-	-
-	-	-

Radar Abstraction	
<span style="color: blue;">█</span>	Strong Discrete
<span style="color: lightblue;">█</span>	Weak Discrete
<span style="color: brown;">█</span>	Strong Complex
<span style="color: orange;">█</span>	Weak Complex
<span style="color: magenta;">█</span>	Point Diffraction
<span style="color: pink;">█</span>	Broad Crested
<span style="color: green;">█</span>	Strong Planar
<span style="color: lightgreen;">█</span>	Weak Planar
<span style="color: yellow;">█</span>	Conductive Surface
<span style="color: black;">→</span>	Inclined Event
0.25 Depth to top of feature (m)	
Job No.	Survey Date
2081	NOV 2005
Client	
PELL FRISCHMANN	
Project Title	
HARVEY'S FOUNDRY HAYLE, CORNWALL	
Subject	
GPR ABSTRACTION 200MHz NORTH	
<b>STRATASCAN™</b> GEOPHYSICS FOR ARCHAEOLOGY AND ENGINEERING VINEYARD HOUSE UPPER HOOK ROAD UPTON UPON SEVERN UK WR8 0SA T: +44 (0)1684 592266 F: +44 (0)1684 594142 E: info@stratascan.co.uk www.stratascan.co.uk	
Scale	
1:200	
0m 2 4 6 8 10m	
Plot	Checked by
A1	PPB
Date	Issue No.
NOV 2005	01
Drawn by	Figure No.
NG	09





Amendments		
Issue No.	Date	Description
<p align="center"><b>Radar Interpretation</b></p> <ul style="list-style-type: none"> <li> Possible service</li> <li> Possible service trench</li> <li> Strong complex anomaly - possible structural debris of archaeological origin</li> <li> Weak complex response - area of ground disturbance of modern or archaeological origin</li> <li> Inclined event - area of ground disturbance of modern or archaeological origin</li> <li>0.36m Approximate depth to top of anomaly (m)</li> </ul>		
Job No.	2081	Survey Date
Client	PELL FRISCHMANN	
Project Title	HARVEY'S FOUNDRY HAYLE, CORNWALL	
Subject	GPR INTERPRETATION 200MHZ SOUTH	
<p align="center"> <b>STRATASCAN™</b>          GEOPHYSICS FOR ARCHAEOLOGY          AND ENGINEERING          VINEYARD HOUSE          UPPER HOOK ROAD          UPTON UPON SEVERN          UK          WR8 0SA          T: +44 (0)1684 592266          F: +44 (0)1684 594142          E: info@stratascan.co.uk          www.stratascan.co.uk       </p>		
Scale	1:200	
Plot	A1	Issue No.
Date	NOV 2005	Figure No.
Checked by	PPB	
Drawn by	HH/NG	





Amendments		
Issue No.	Date	Description
-	-	-
-	-	-
-	-	-

Radar Interpretation	
	Possible service
	Possible service trench
	Strong complex anomaly - possible structural debris of archaeological origin
	Weak complex response - area of ground disturbance of modern or archaeological origin
	Inclined event - area of ground disturbance of modern or archaeological origin
0.36m	Approximate depth to top of anomaly (m)

Job No.	2081	Survey Date	NOV 2005
Client	PELL FRISCHMANN		
Project Title	HARVEY'S FOUNDRY HAYLE, CORNWALL		
Subject	GPR INTERPRETATION 200MHZ NORTH		


  

**STRATASCAN™**  
 GEOPHYSICS FOR ARCHAEOLOGY  
 AND ENGINEERING  
 VINEYARD HOUSE  
 UPPER HOOK ROAD  
 UPTON UPON SEVERN  
 UK  
 WR8 0SA  
 T: +44 (0)1684 592266  
 F: +44 (0)1684 594142  
 E: info@stratascan.co.uk  
 www.stratascan.co.uk

Scale	0m 2 4 6 8 10m		
1:200			
Plot	A1	Checked by	PPB
Issue No.		Issue No.	01
Date	NOV 2005	Drawn by	HH/NG
Figure No.		Figure No.	11



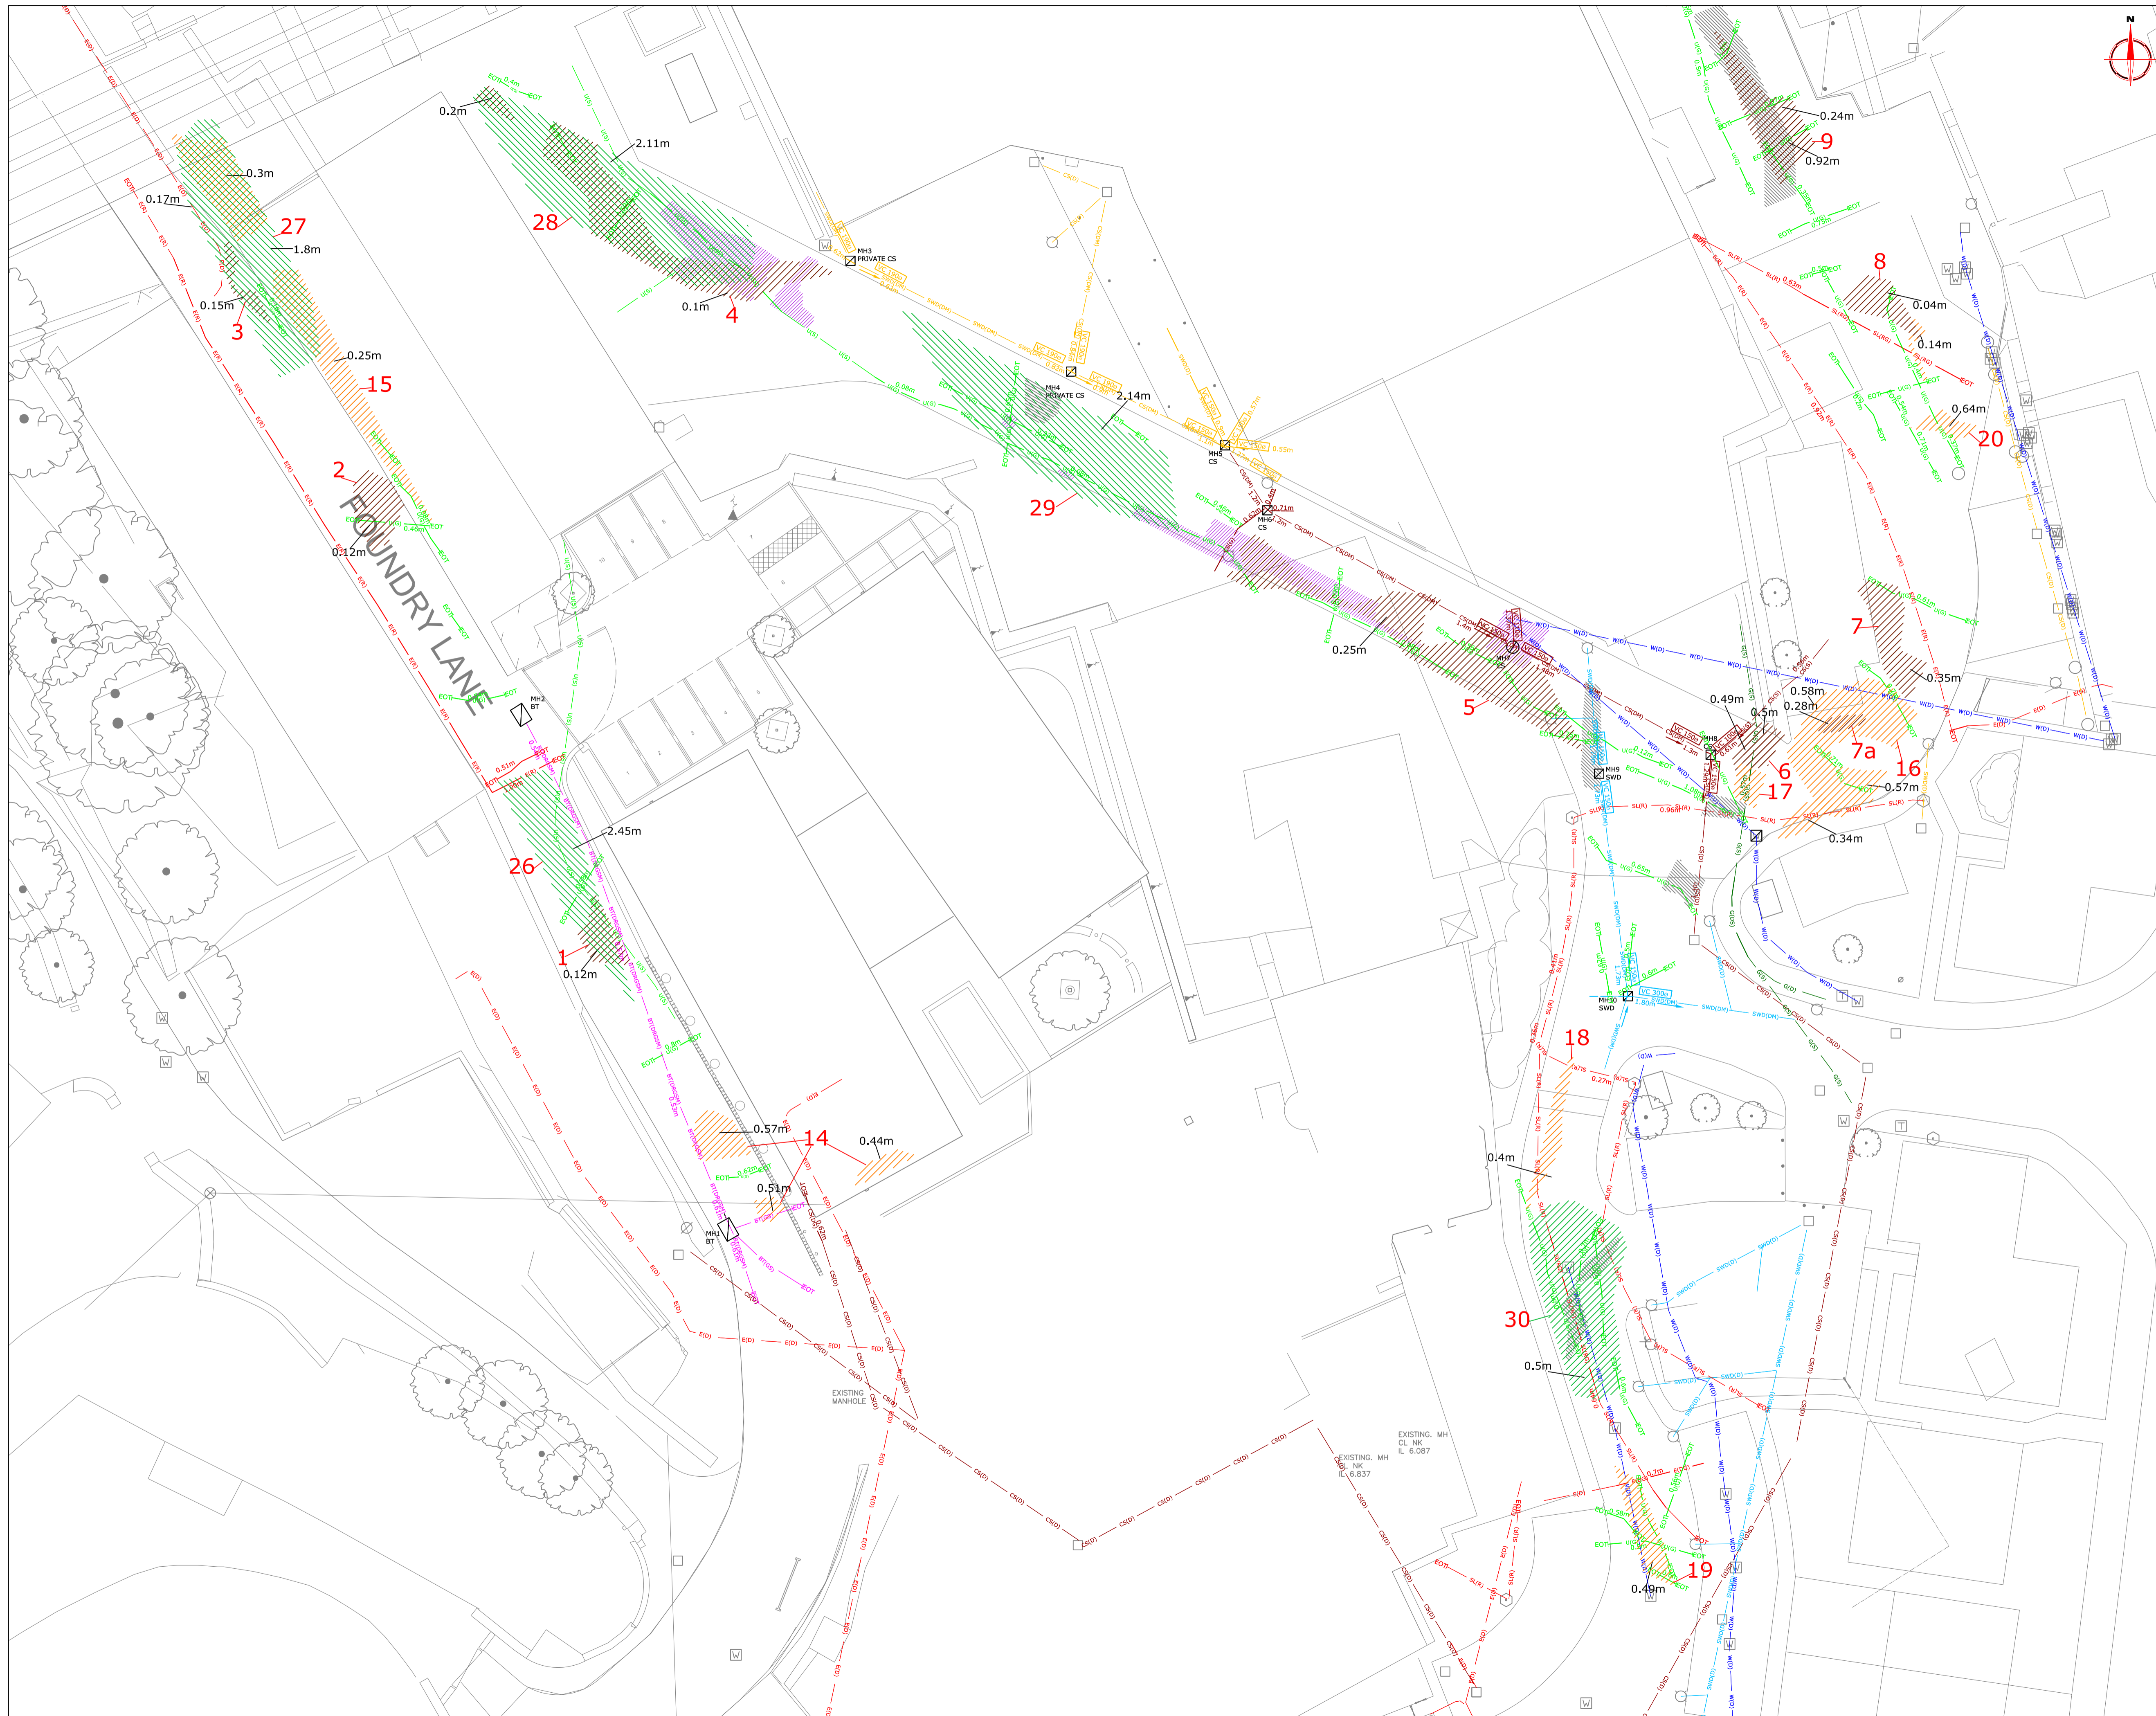

Amendments		
Issue No.	Date	Description
-	-	-
-	-	-

KEY		
LINETYPES AND ABBREVIATIONS		
BT	BT	TELECOMMUNICATIONS (BT)
CATV	CATV	TELECOMMUNICATIONS (CATV)
FO	FO	TELECOMMUNICATIONS (FIBRE OPTIC)
G	G	GAS
E	E	ELECTRIC
SL	SL	STREET LIGHTING
W	W	WATER
FH	FH	FIRE HYDRANT
SWD	SWD	SURFACE WATER DRAINAGE
SWD	SWD	SURFACE WATER DRAINAGE (PRIVATE)
FWD	FWD	FOUL SEWER
FWD	FWD	FOUL SEWER (PRIVATE)
CS	CS	COMBINED SEWER (PRIVATE)
CS	CS	COMBINED SEWER (RISING MAIN)
DUCT	DUCT	DUCT (UNOCCUPIED)
U	U	UNKNOWN
SCAR	SCAR	SERVICE SCAR
RSUR	RSUR	RADIODETECTION SURVEY EXTENT
ST	ST	POSSIBLE SERVICE TRENCH
STRONG	STRONG	Strong complex anomaly - possible structural debris of modern or archaeological origin
WEAK	WEAK	Weak complex anomaly - areas of ground disturbance of modern or archaeological origin
INCLINED	INCLINED	Inclined event - areas of ground disturbance of modern or archaeological origin
STRONG DISCRETE	STRONG DISCRETE	Strong discrete anomaly - possible structural remains
17	17	GPR anomaly
EDT	EDT	DIRECTION OF FLOW
UTR	UTR	END OF TRACE
UNRAISE	UNRAISE	UNABLE TO RAISE
RE	RE	RECORDING EYE/ INSPECTION CHAMBER/ MANHOLE

DATA SOURCE	MATERIAL TYPE
D RECORD DRAWING	ST STEEL
R RADIODETECTION	DI DUCTILE IRON
G GPR DATA	CON CONCRETE
S SCAR	PE POLYETHYLENE
M MANHOLE/VALVE POSITION	VC VITRIFIED CLAY
	DU DUCTS (P) PLASTIC DUCT
	DU DUCTS (VC) VITRIFIED CLAY DUCT

INTERPRETED LINE INFORMATION (EXAMPLE)		
Data sources used in interpretation of line	Utility type	
G(DRG) - G(DRG) - PE (DRG)	Gas	0.36m
Estimated depth of cover (m)	Material	Diameter (mm)

N.B. THE UTILITY SURVEY INFORMATION ON THIS PLAN HAS BEEN PRODUCED USING GPR AND ELECTRO-MAGNETIC LOCATING TECHNIQUES. ALTHOUGH BEING THE MOST ACCURATE AVAILABLE, SIGNALS ARE SUSCEPTIBLE TO DISTORTION ON THE SURFACE ESPECIALLY IN CONGESTED AREAS. THERE MAY ALSO BE NON-METALLIC SERVICES AND METALLIC SERVICES PRODUCING INSUFFICIENT SIGNALS FOR ACCURATE LOCATION USING ELECTRO-MAGNETIC TECHNIQUES. WHILE GPR SHOULD DETECT BOTH METALLIC AND NON-METALLIC SERVICES, INDIVIDUAL SERVICES WITHIN CONGESTED AND COMPLEX AREAS MAY BE OBTUSCURED. WHILE EVERY EFFORT HAS BEEN MADE TO PRODUCE AN ACCURATE PLAN OF THE BURIED SERVICES WITHIN THE SURVEY AREA, CRUCIAL DIMENSIONS AND DEPTHS SHOULD BE CHECKED. EXTREME CAUTION SHOULD BE TAKEN WHEN ANY EXCAVATION IS UNDERTAKEN. THE INFORMATION CONTAINED WITHIN THIS PLAN MAY NOT REPRESENT THE TOTAL NUMBER OF SERVICES CONTAINED WITHIN THE SURVEY AREA. HEALTH AND SAFETY GUIDELINES SHOULD BE FOLLOWED PRIOR TO EXCAVATION.


Job No.	2081	Survey Date	NOV 2005
Client	PELL FRISCHMANN		
Project Title	HARVEY'S FOUNDRY HAYLE, CORNWALL		
Subject	FINAL INTERPRETATION (GPR AND RADIODETECTION) SOUTH		

**STRATASCAN™**  
 GEOPHYSICS FOR ARCHAEOLOGY  
 AND ENGINEERING  
 VINEYARD HOUSE  
 UPPER HOOK ROAD  
 UPPER UPON SEVERN  
 UK  
 WR8 0SA  
 T: +44 (0)1684 592266  
 F: +44 (0)1684 594142  
 E: info@stratascan.co.uk  
 www.stratascan.co.uk

Scale	1:200			
Plot	A1	Checked by	PPB	Issue No.
Date	NOV 2005	Drawn by	HH	Figure No.
				12



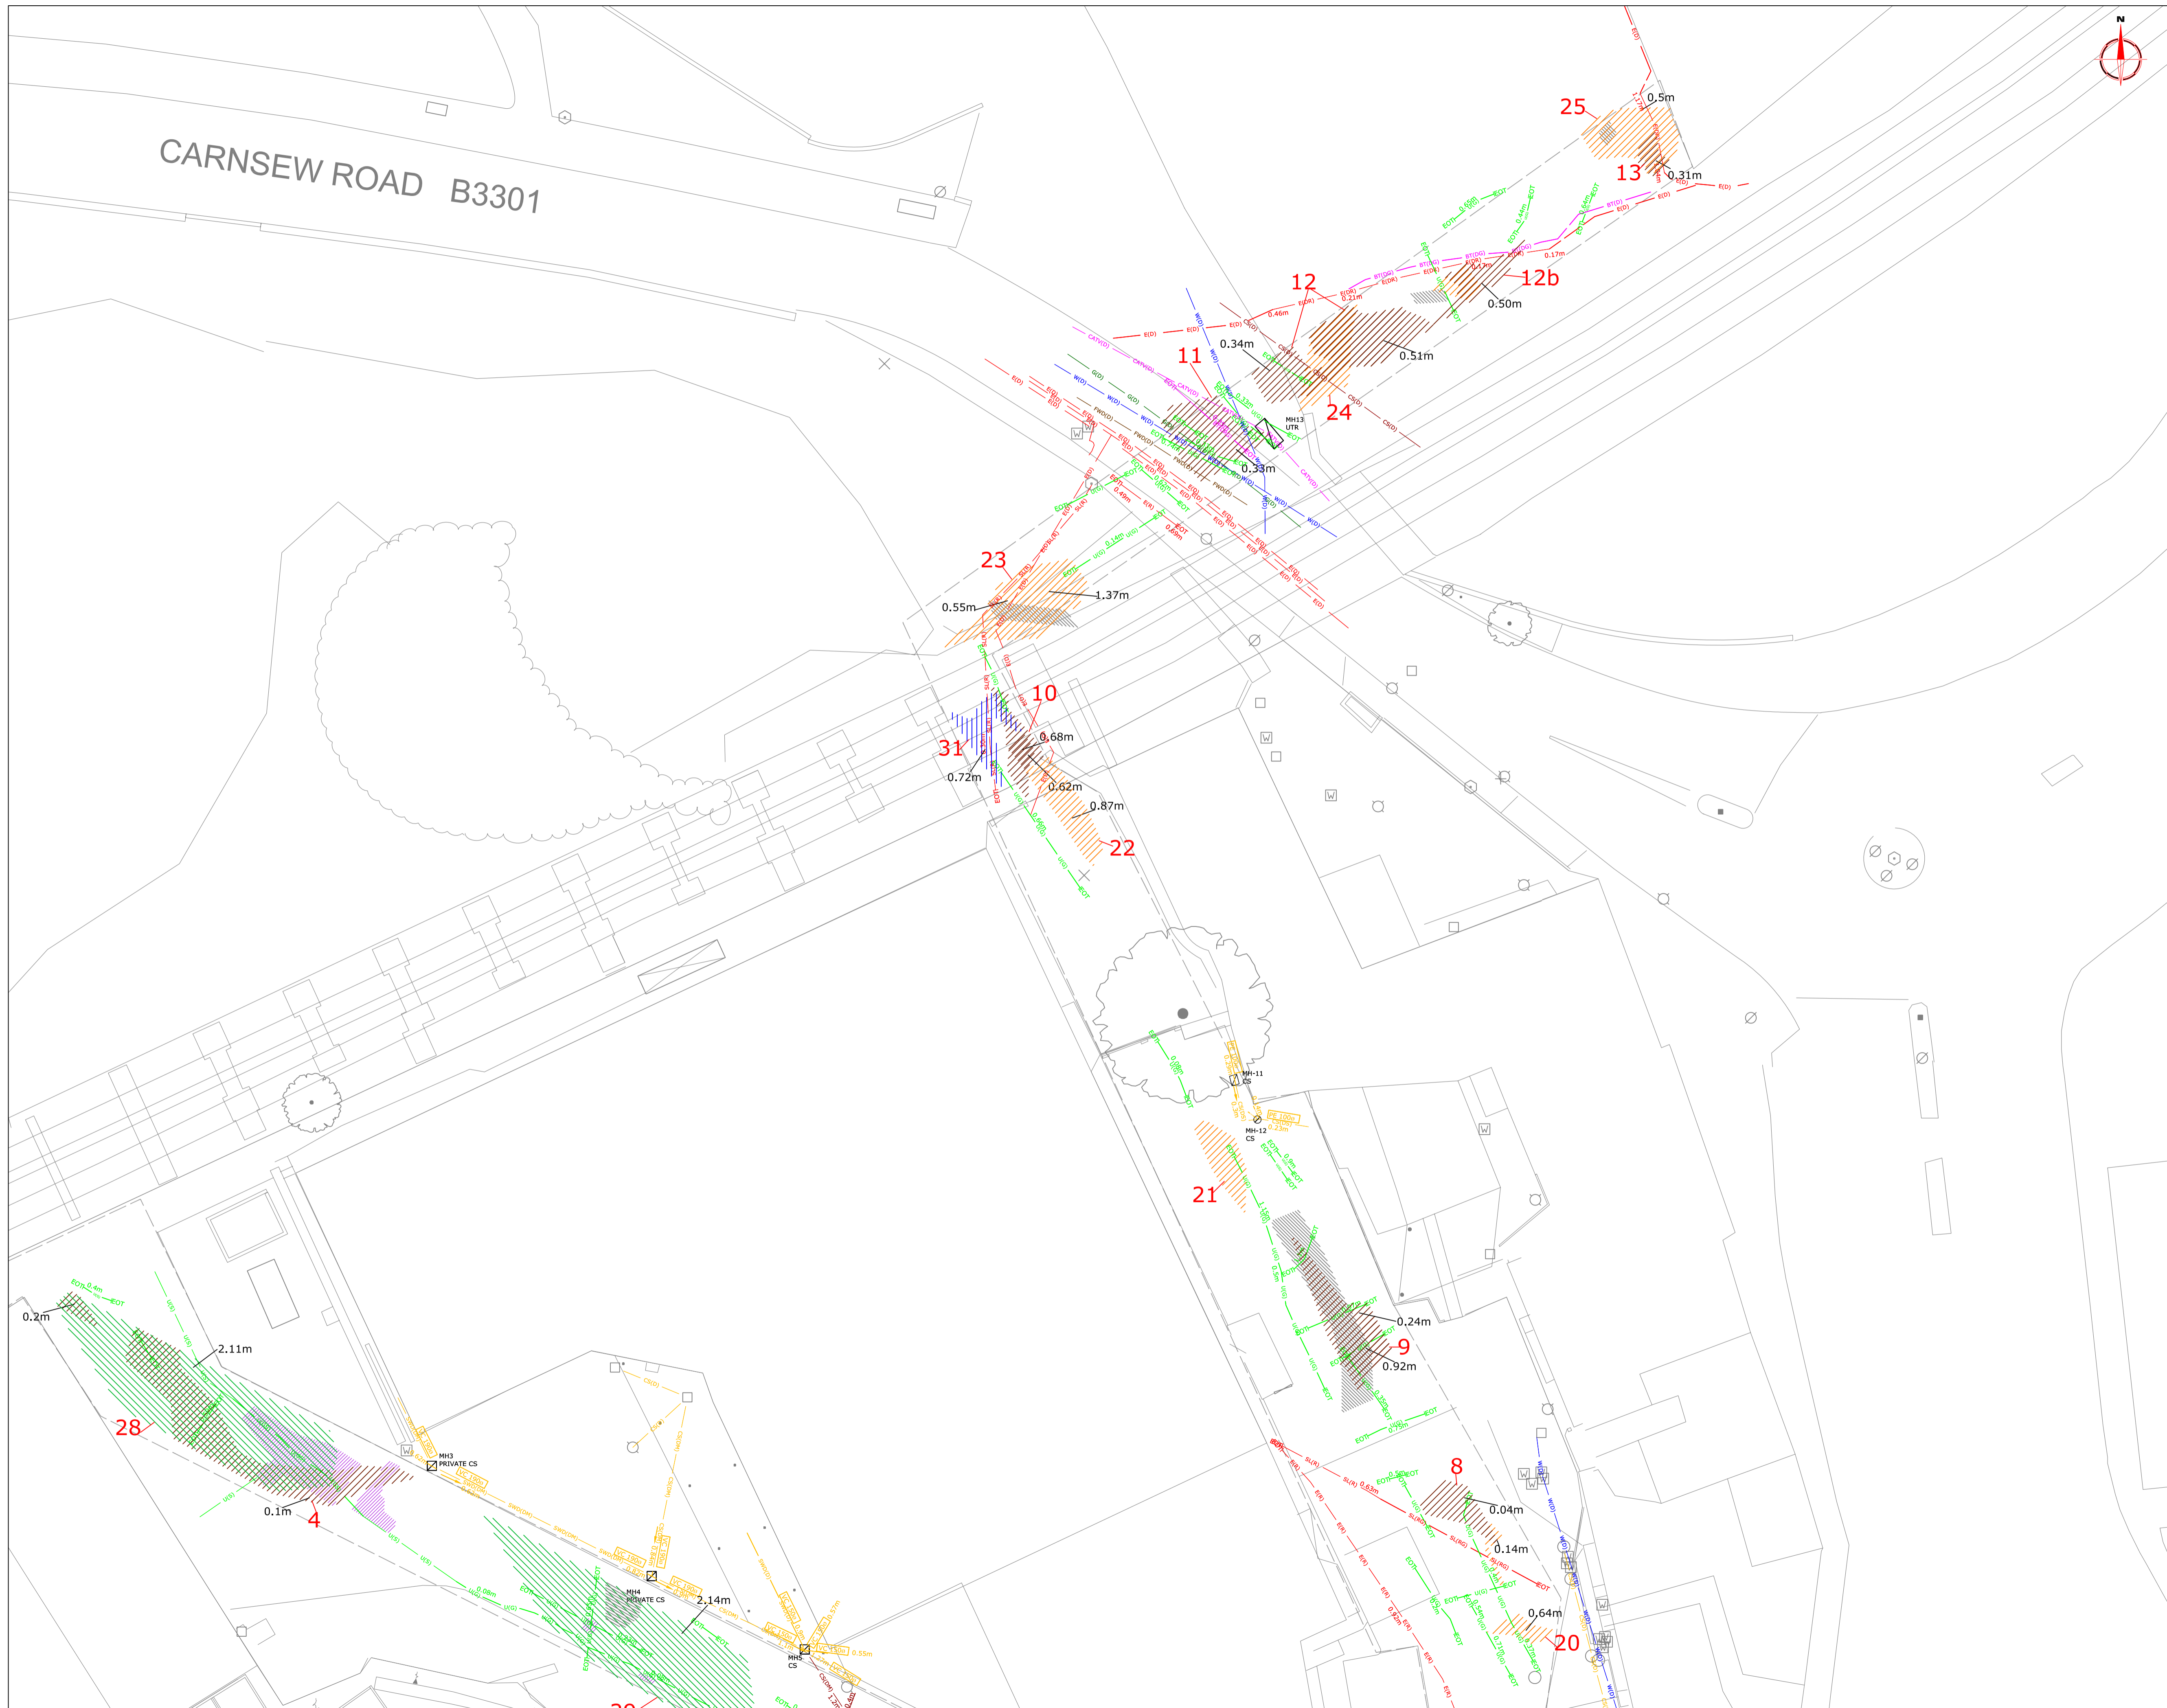

Amendments		
Issue No.	Date	Description
-	-	-
-	-	-

KEY		
LINETYPES AND ABBREVIATIONS		
BT	BT	TELECOMMUNICATIONS (BT)
CATV	CATV	TELECOMMUNICATIONS (CATV)
FO	FO	TELECOMMUNICATIONS (FIBRE OPTIC)
G	G	GAS
E	E	ELECTRIC
SL	SL	STREET LIGHTING
W	W	WATER
FH	FH	FIRE HYDRANT
SWD	SWD	SURFACE WATER DRAINAGE
FWD	FWD	FOUL SEWER (PRIVATE)
CS	CS	COMBINED SEWER (PRIVATE)
CS	CS	COMBINED SEWER (PUBLIC)
DUCT	DUCT	DUCT (UNOCCUPIED)
U	U	UNKNOWN
RE	RE	RADIODETECTION SURVEY EXTENT
POSSIBLE SERVICE TRENCH		
Strong complex anomaly - possible structural debris of modern or archaeological origin		
Weak complex anomaly - areas of ground disturbance of modern or archaeological origin		
Inclined event - areas of ground disturbance of modern or archaeological origin		
Strong discrete anomaly - possible structural remains		
17		GPR anomaly
DIRECTION OF FLOW		
EDT		END OF TRACE
UTR		UNABLE TO RAISE
RE		RODGING BITE/ INSPECTION CHAMBER/ MANHOLE

DATA SOURCE	MATERIAL TYPE
D RECORD DRAWING	ST STEEL
R RADIODETECTION	DI DUCTILE IRON
G GPR	CON CONCRETE
EM DATA	PE POLYETHYLENE
S SCAR	VC VITRIFIED CLAY
M MANHOLE/VALVE POSITION	VC DUCTS (P) PLASTIC DUCT
	VC DUCTS (VC) VITRIFIED CLAY DUCT

INTERPRETED LINE INFORMATION (EXAMPLE)		
Data sources used in interpretation of line	Utility type	
G(DRG) G(DRG) G(DRG)	PE (DRG)	
Estimated depth of cover (m)	Material*	Diameter (mm)
0.36m		

**N.B.** THE UTILITY SURVEY INFORMATION ON THIS PLAN HAS BEEN PRODUCED USING GPR AND ELECTRO-MAGNETIC LOCATING TECHNIQUES. ALTHOUGH BEING THE MOST ACCURATE AVAILABLE, SIGNALS ARE SUSCEPTIBLE TO DISTORTION ON THE SURFACE ESPECIALLY IN CONGESTED AREAS. THERE MAY ALSO BE NON-METALLIC SERVICES AND METALLIC SERVICES PRODUCING INSUFFICIENT SIGNALS FOR ACCURATE LOCATION USING ELECTRO-MAGNETIC TECHNIQUES. WHILE GPR SHOULD DETECT BOTH METALLIC AND NON-METALLIC SERVICES, INDIVIDUAL SERVICES WITHIN CONGESTED AND COMPLEX AREAS MAY BE OBTUSCURED. WHILE EVERY EFFORT HAS BEEN MADE TO PRODUCE AN ACCURATE PLAN OF THE BURIED SERVICES WITHIN THE SURVEY AREA, CRUCIAL DIMENSIONS AND DEPTHS SHOULD BE CHECKED. EXTREME CAUTION SHOULD BE TAKEN WHEN ANY EXCAVATION IS UNDERTAKEN. THE INFORMATION CONTAINED WITHIN THIS PLAN MAY NOT REPRESENT THE TOTAL NUMBER OF SERVICES CONTAINED WITHIN THE SURVEY AREA. HEALTH AND SAFETY GUIDELINES SHOULD BE FOLLOWED PRIOR TO EXCAVATION.

Job No.	2081	Survey Date	NOV 2005
Client	PELL FRISCHMANN		
Project Title	HARVEY'S FOUNDRY HAYLE, CORNWALL		
Subject	FINAL INTERPRETATION (GPR AND RADIODETECTION) NORTH		

**STRATASCAN™**  
 GEOPHYSICS FOR ARCHAEOLOGY  
 AND ENGINEERING  
 VINEYARD HOUSE  
 UPPER HOOK ROAD  
 UPTON UPON SEVERN  
 UK  
 WR8 0SA  
 T: +44 (0)1684 592266  
 F: +44 (0)1684 594142  
 E: info@stratascan.co.uk  
 www.stratascan.co.uk

Scale	0m 2 4 6 8 10m		
1:200			
Plot	A1	Checked by	PPB
Date	NOV 2005	Issue No.	01
	Drawn by	HH	Figure No.
			13