


**Amendments**

| Issue No. | Date | Description |
|-----------|------|-------------|
| -         | -    | -           |

Site centred on NGR **SO 512 398**

Reproduced from Ordnance Survey's 1:25 000 map of 1998 with the permission of the controller of Her Majesty's Stationery Office. Crown Copyright reserved. Licence No: AL 50125A. Licence: Stratascan Ltd, Vineyard House, Upper Hook Road, Upton Upon Severn, WR8 0SA. OS 100km square = SO

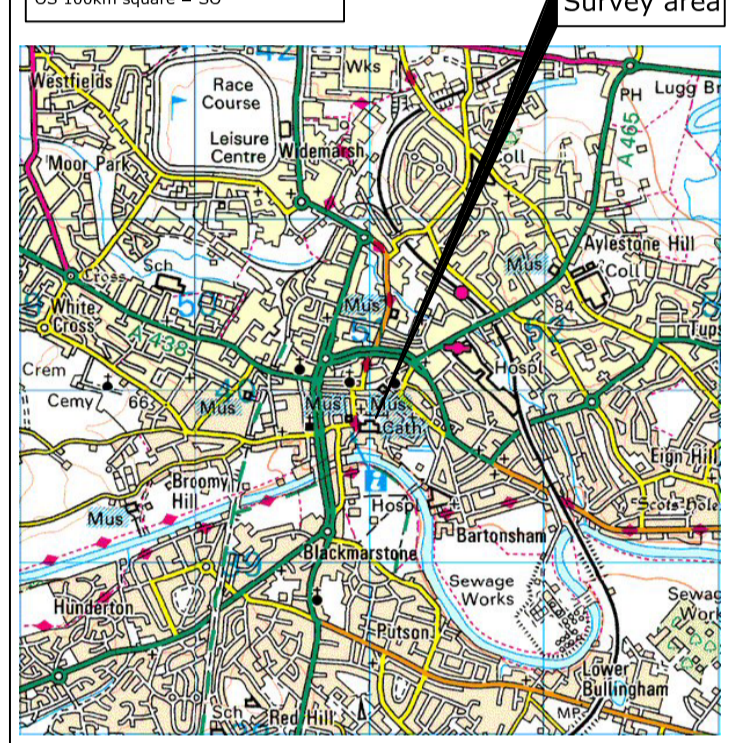

- Gradiometer and Resistivity grid
- 400MHz GPR Traverse
- 200MHz GPR Traverse


Job No. **2118** Survey Date **MARCH 06**

Client **HEREFORD CATHEDRAL**

Project Title **HEREFORD CATHEDRAL CLOSE**


Subject **SITE LOCATION AND SURVEY AREA**

**STRATASCAN™**  
 GEOPHYSICS FOR ARCHAEOLOGY  
 AND ENGINEERING  
 VINEYARD HOUSE  
 UPPER HOOK ROAD  
 UPTON UPON SEVERN  
 UK  
 WR8 0SA  
 T: +44 (0)1684 592266  
 F: +44 (0)1684 594142  
 E: info@stratascan.co.uk  
 www.stratascan.co.uk

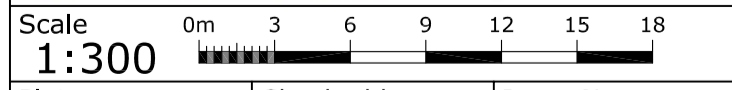

|        |            |            |
|--------|------------|------------|
| Plot   | Checked by | Issue No.  |
| A1     | PPB        | 01         |
| Date   | Drawn by   | Figure No. |
| MAY 06 | SH/HH      | 01         |



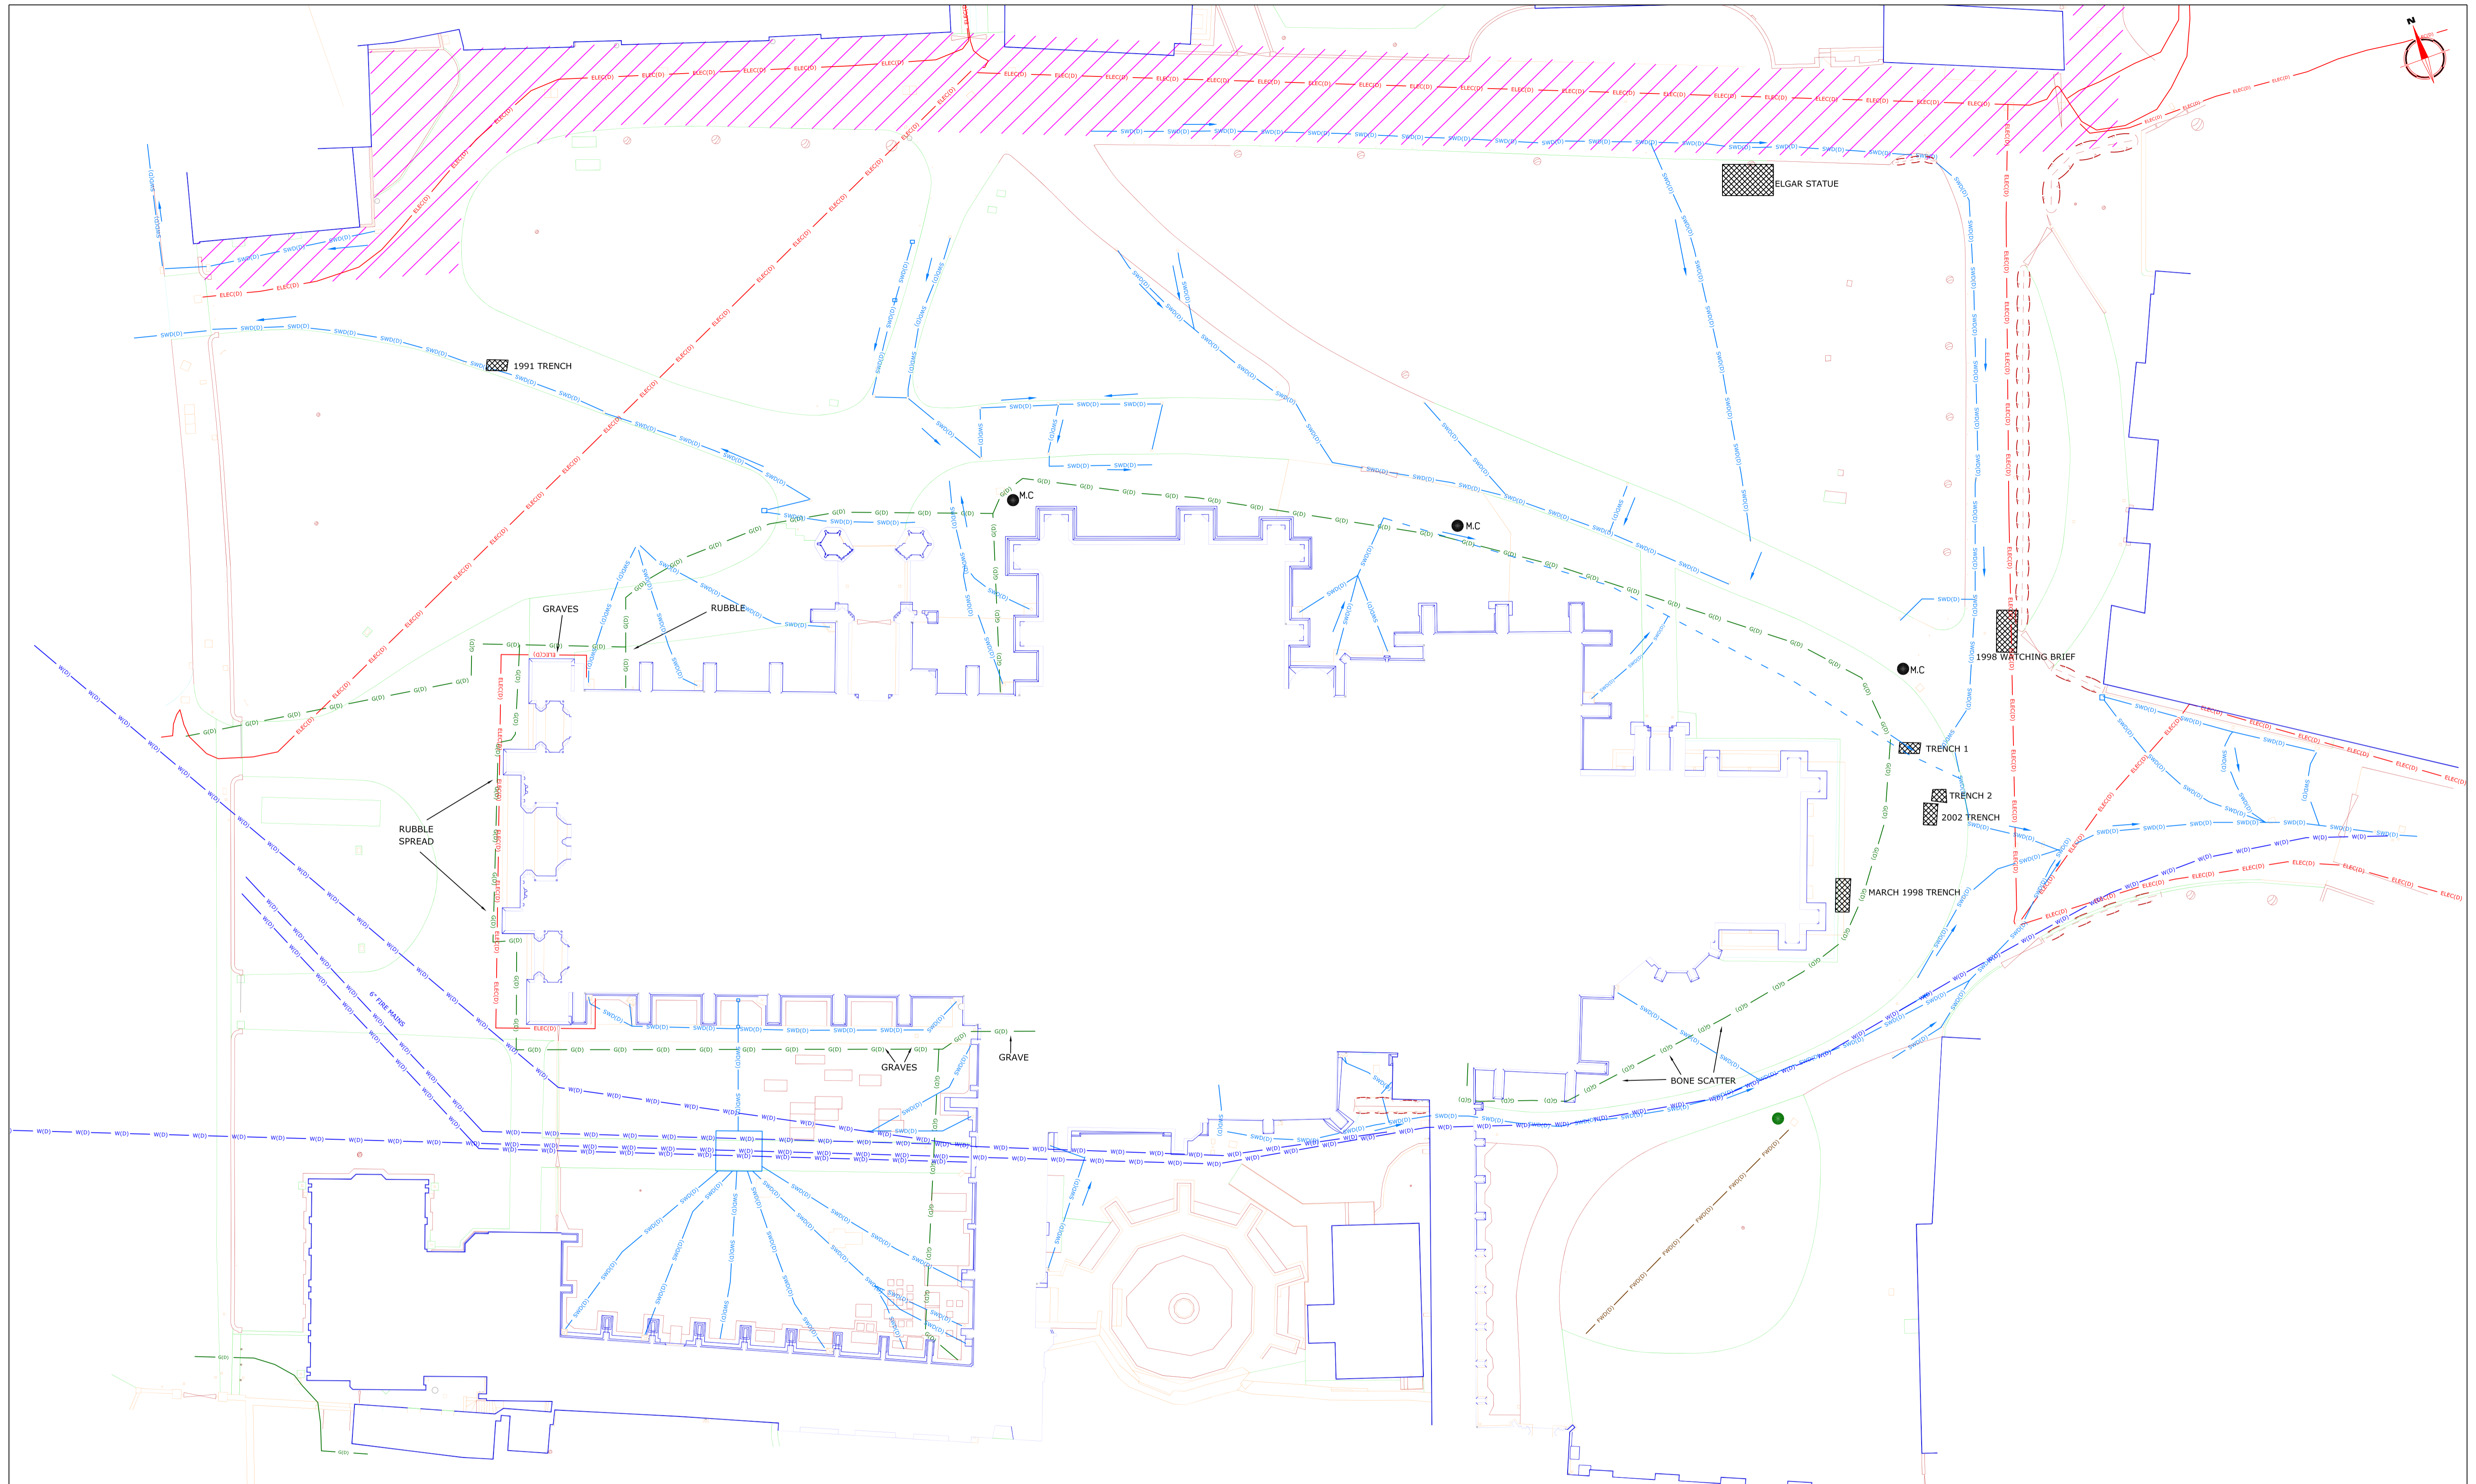

| Amendments |      |             |
|------------|------|-------------|
| Issue No.  | Date | Description |
| -          | -    | -           |
| -          | -    | -           |


| KEY |   |
|-----|---|
|     | TELECOMMUNICATIONS (BT) CORRIDOR        |
|     | G GAS                                   |
|     | ELEC ELECTRIC                           |
|     | W WATER                                 |
|     | SWD SURFACE WATER DRAINAGE              |
|     | FWD FOUL WATER DRAINAGE                 |
| (d) | Service identified from record drawings |
|     | M.C Manhole cover                       |

|               |  |
|---------------|--|
| Client        | HEREFORD CATHEDRAL                                     |
| Project Title | HEREFORD CATHEDRAL CLOSE                               |
| Supported by  | The National Lottery through the Heritage Lottery Fund |
|               |  |


**STRATASCAN**  
 GEOPHYSICS FOR ARCHAEOLOGY  
 AND ENGINEERING  
 VINEYARD HOUSE  
 UPPER HOOK ROAD  
 UPTON UPON SEVERN  
 UK  
 WR8 0SA  
 T: +44 (0)1684 592266  
 F: +44 (0)1684 594142  
 E: info@stratascan.co.uk  
 www.stratascan.co.uk

|         |  |             |               |
|---------|--|-------------|---------------|
| Job No. | 2118   | Survey Date | MARCH 06      |
| Subject | SERVICE RECORD DRAWINGS, EXCAVATIONS/WATCHING BRIEFS |             |               |
| Scale   | 1:250  |             |               |
| Plot    | A1   | Checked by  | PPB           |
| Date    | MAY 06   | Issue No.   | 01            |
|         | Drawn by   | HH          | Figure No. 02 |




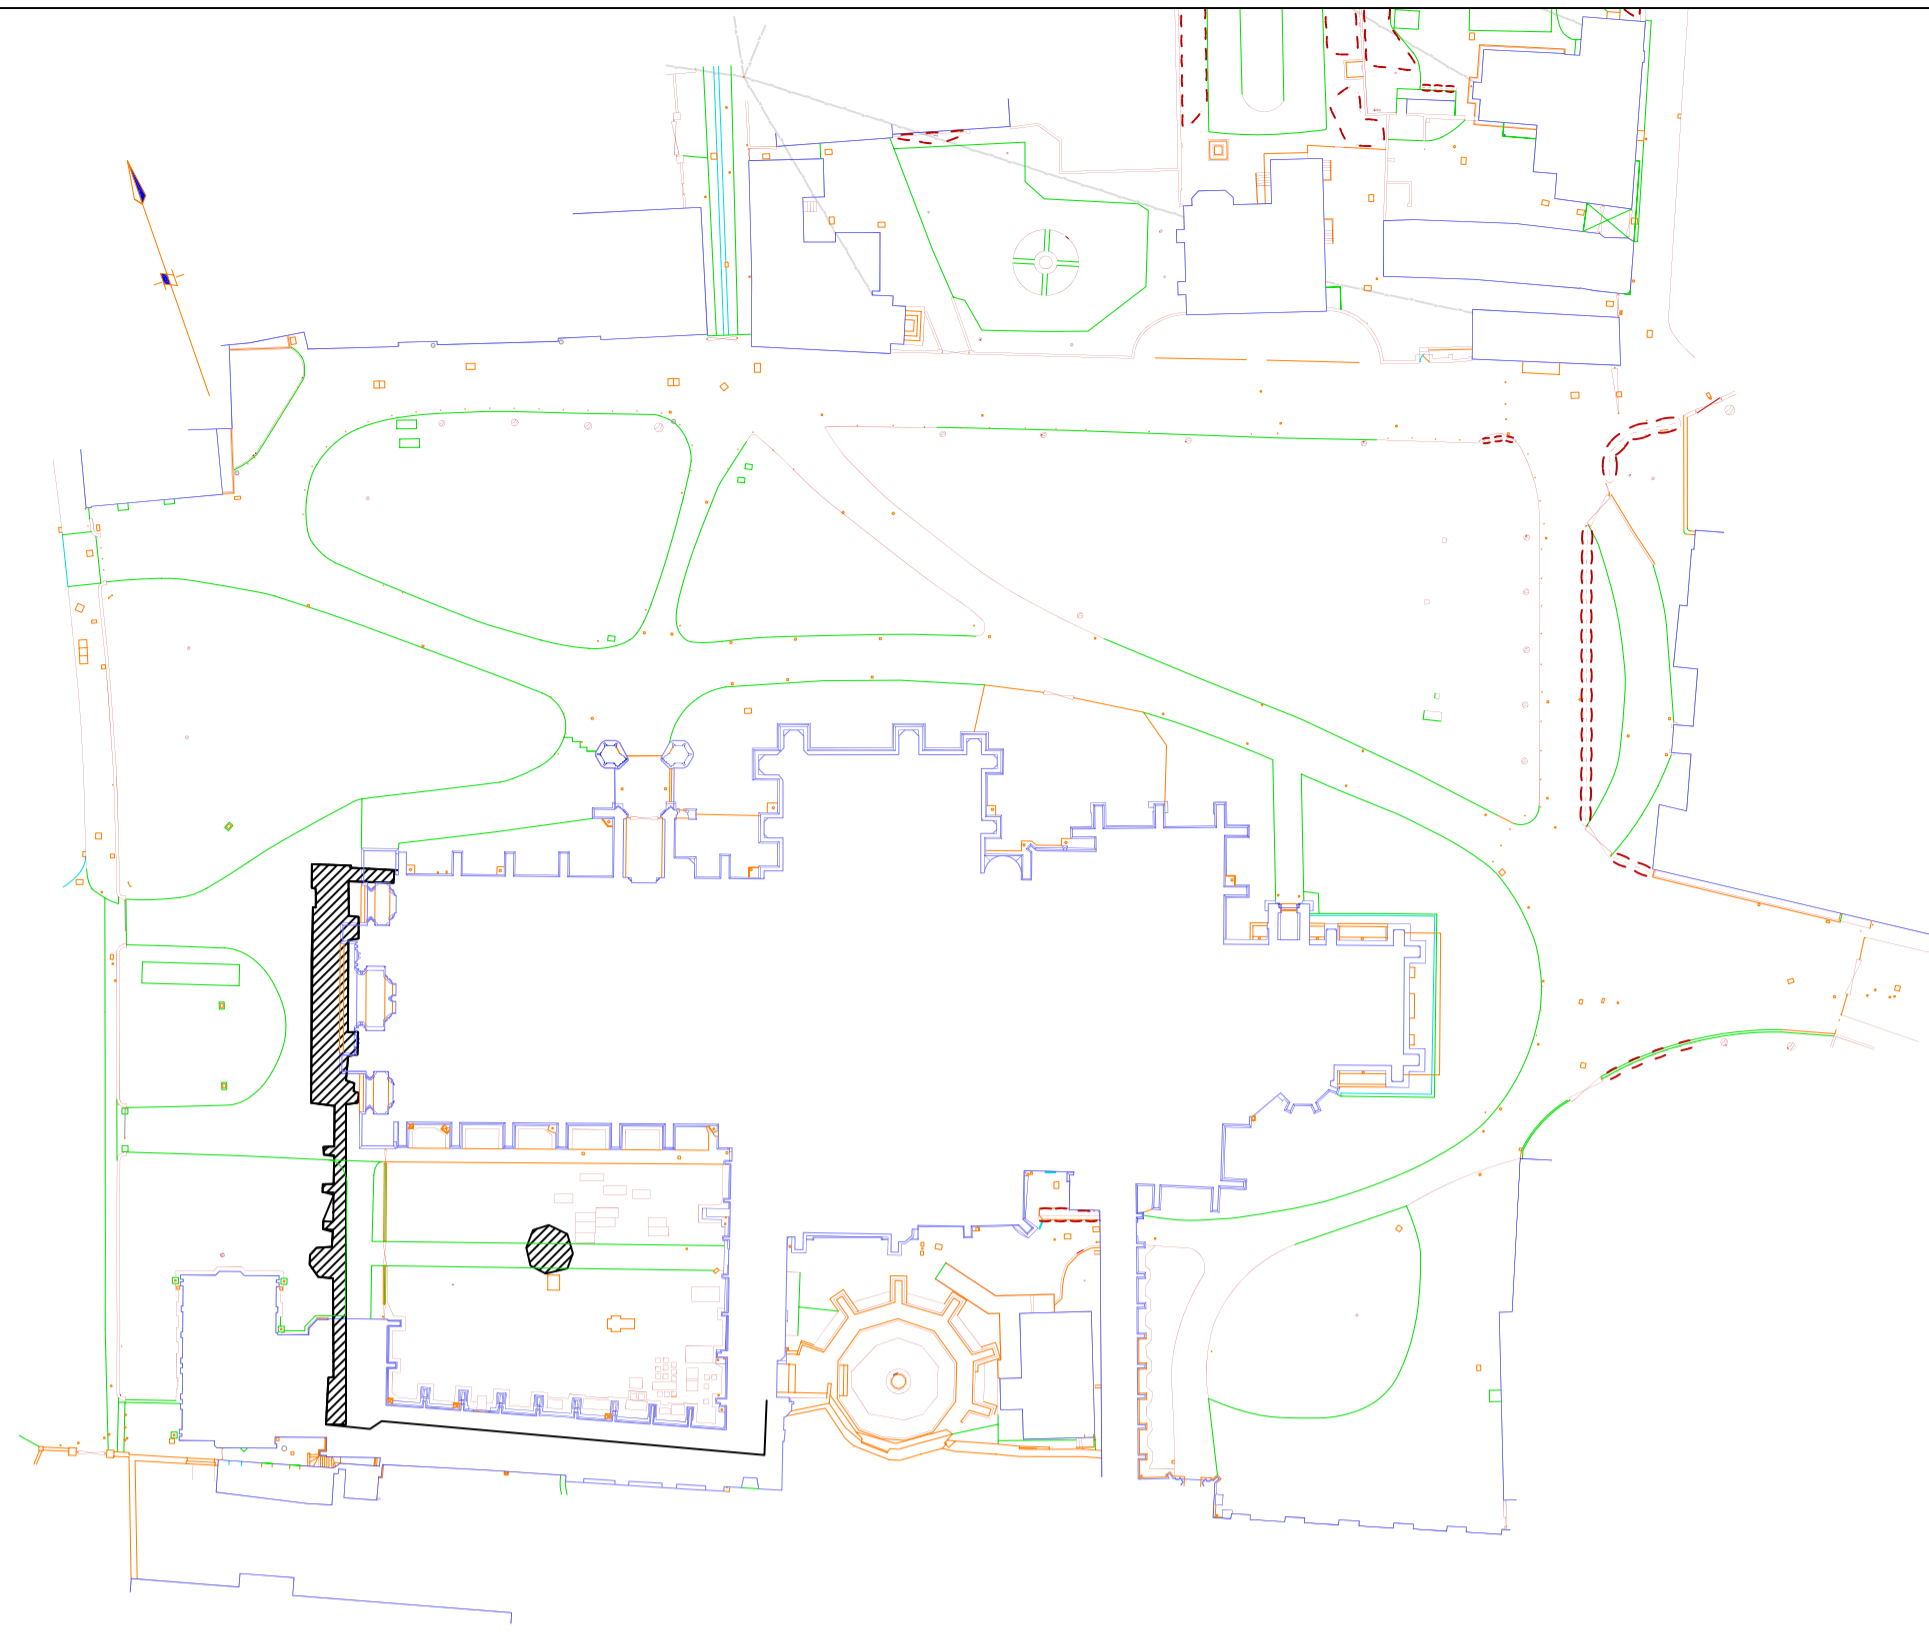


1735 CLOISTER WALL AND CATHEDRAL FRONTAGE

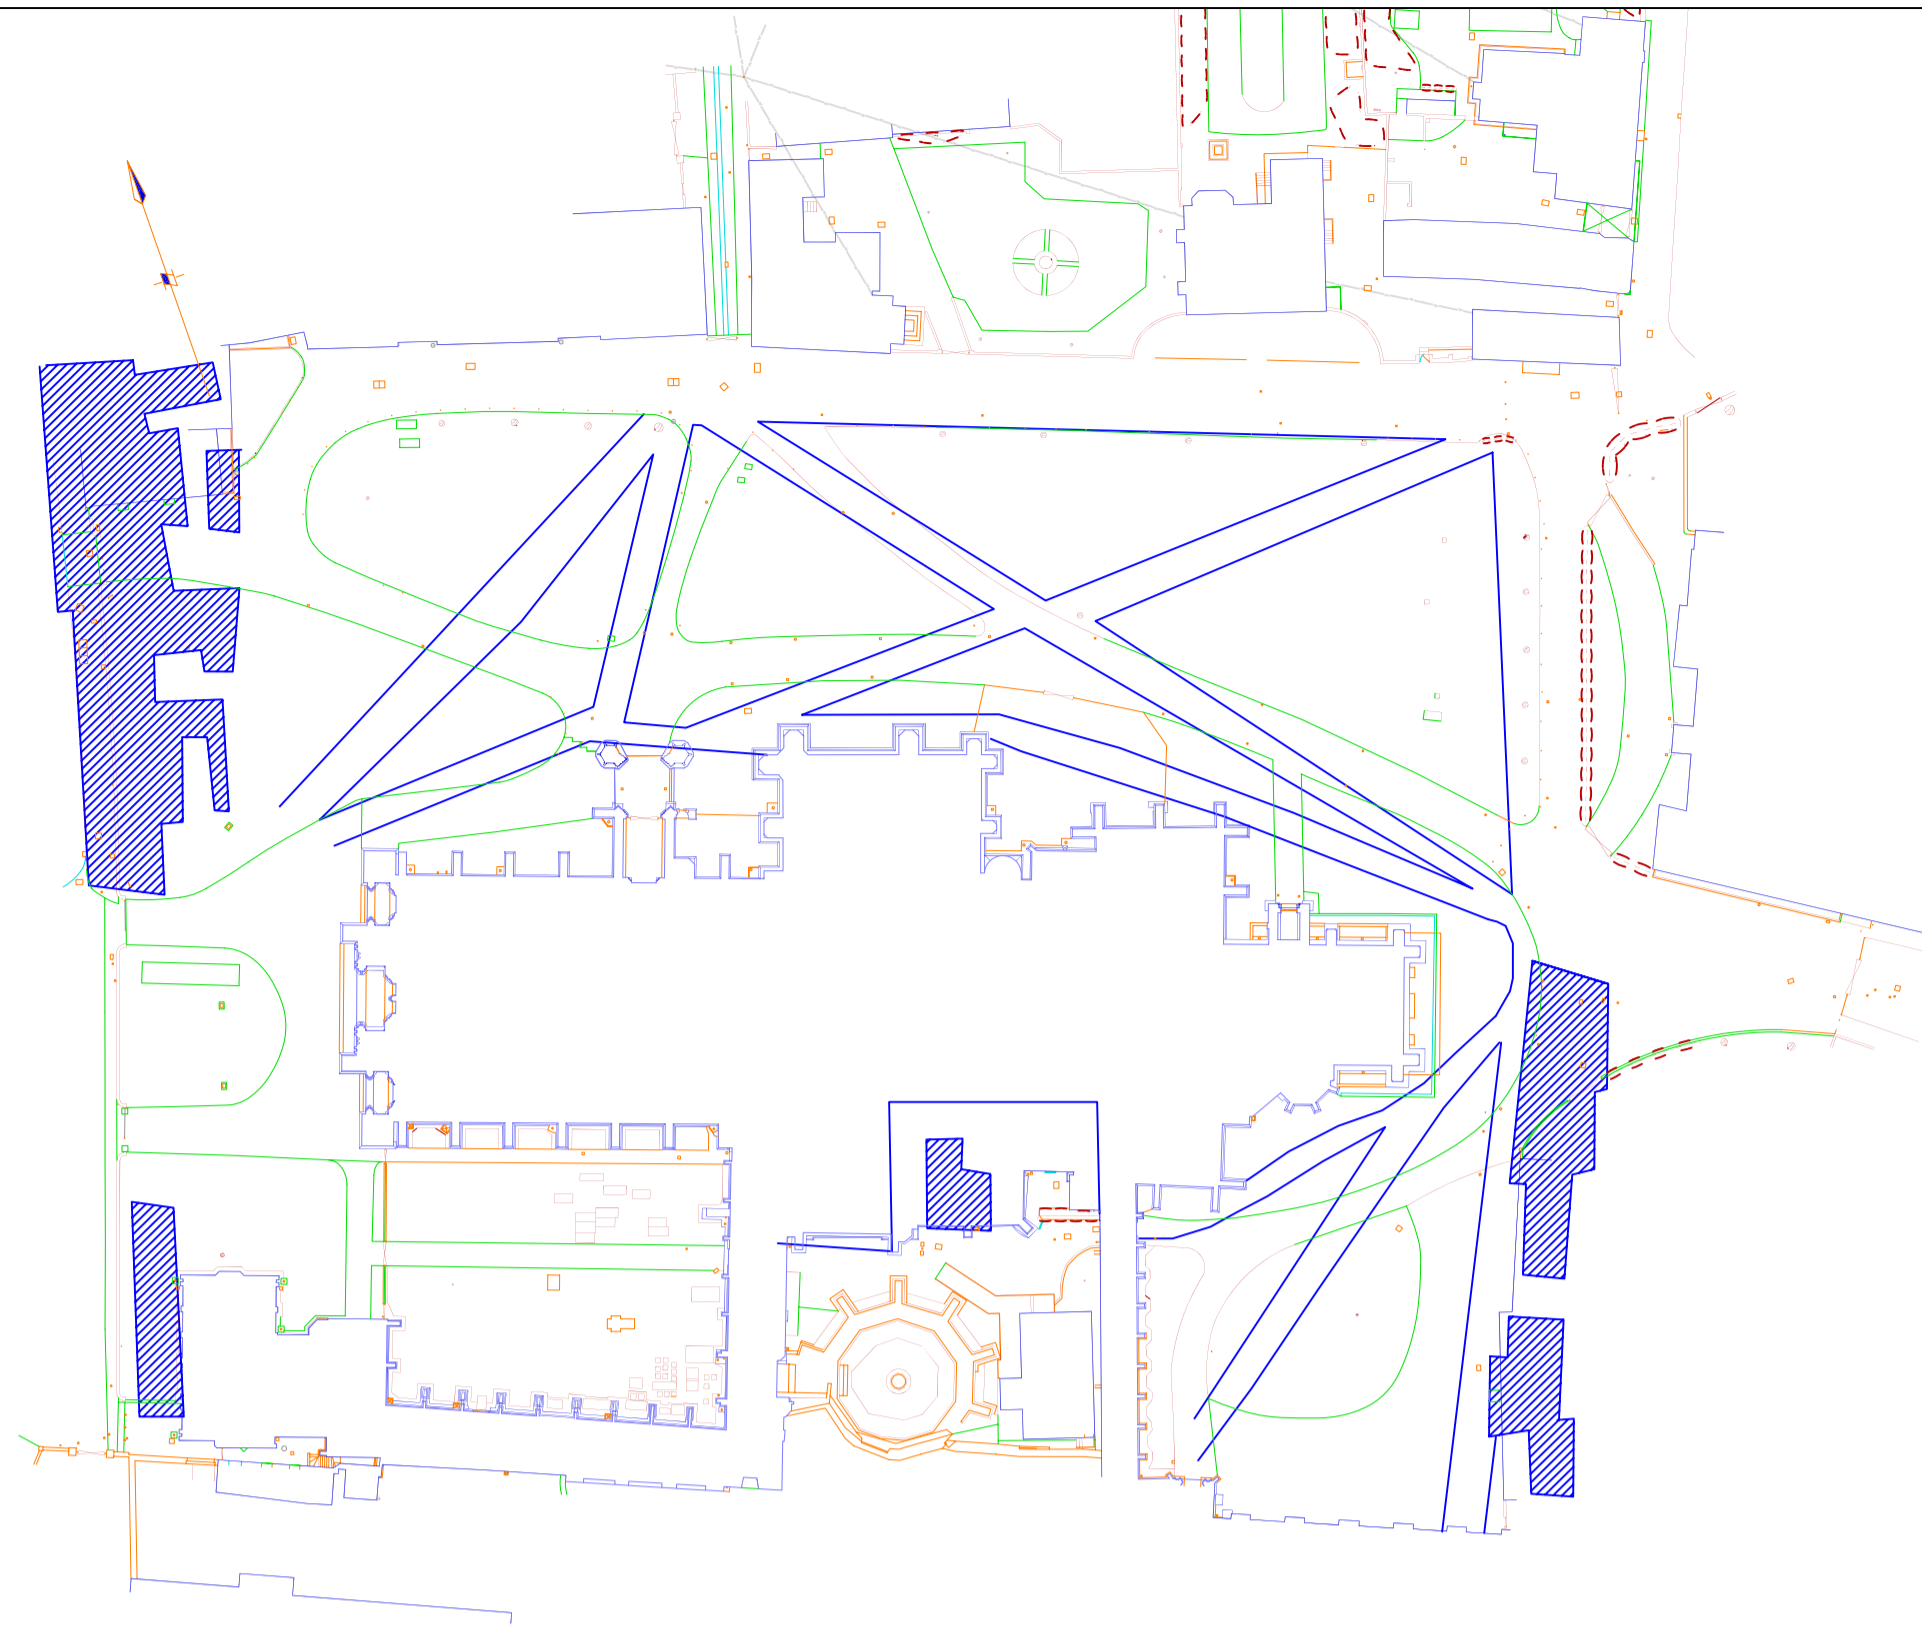





1757 BUILDINGS ALONG BROAD STREET CASTLE STREET AND PATHWAY POSITIONS

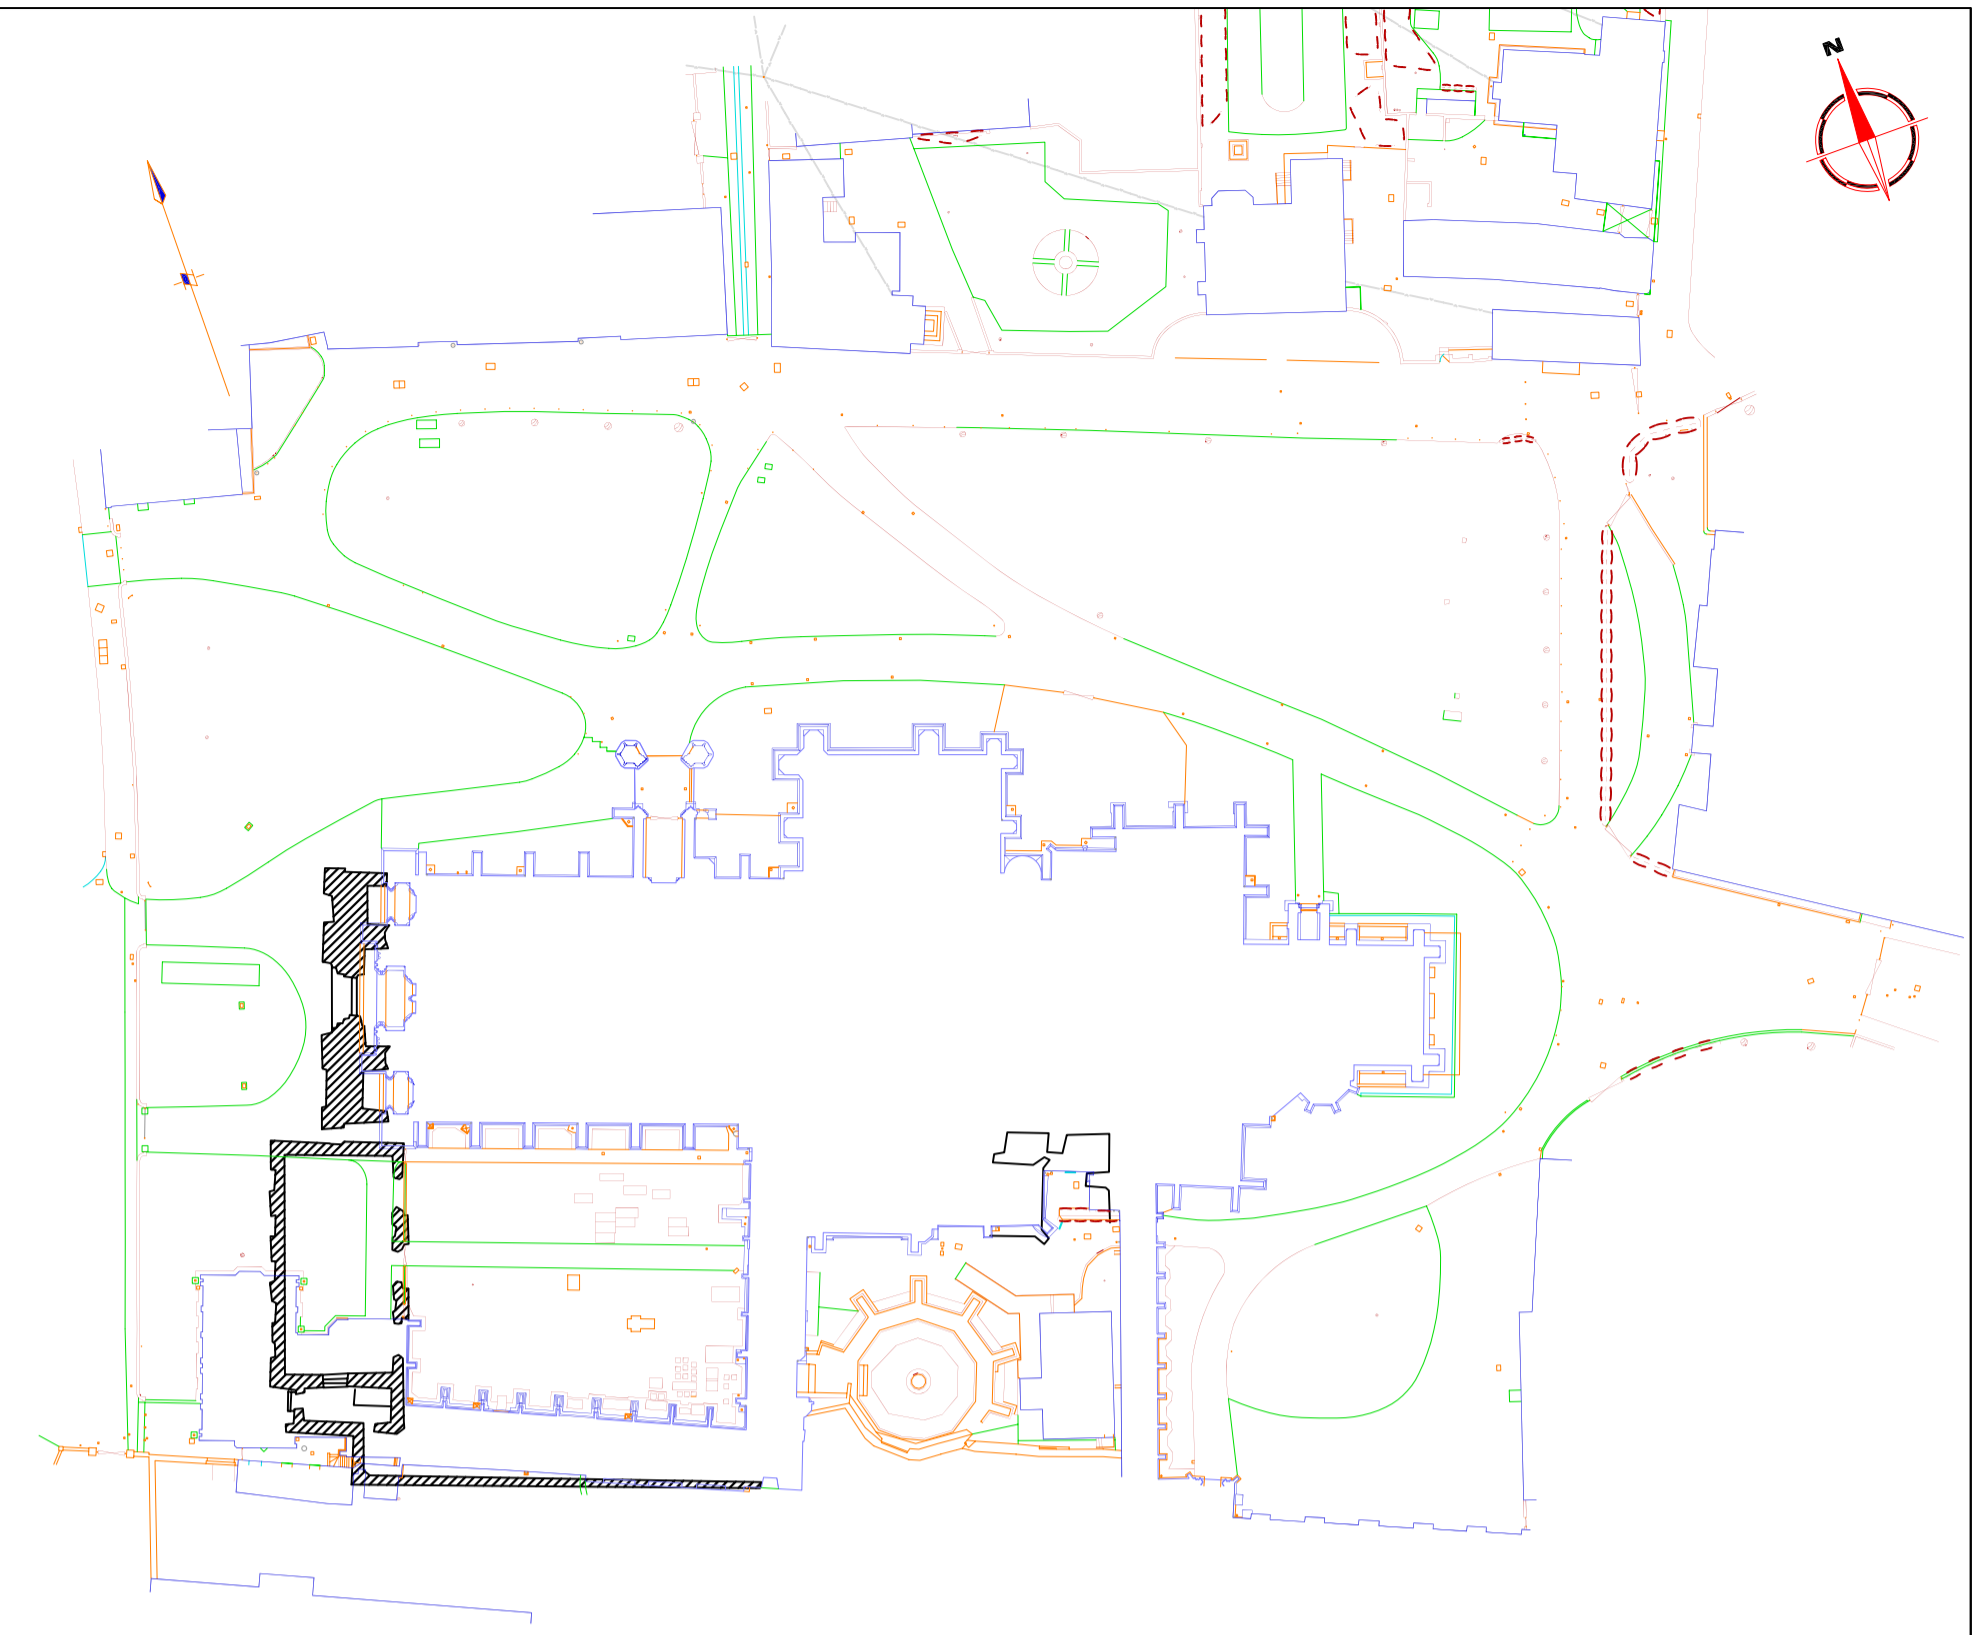

1795 CATHEDRAL FRONTAGE AND MUSIC HALL

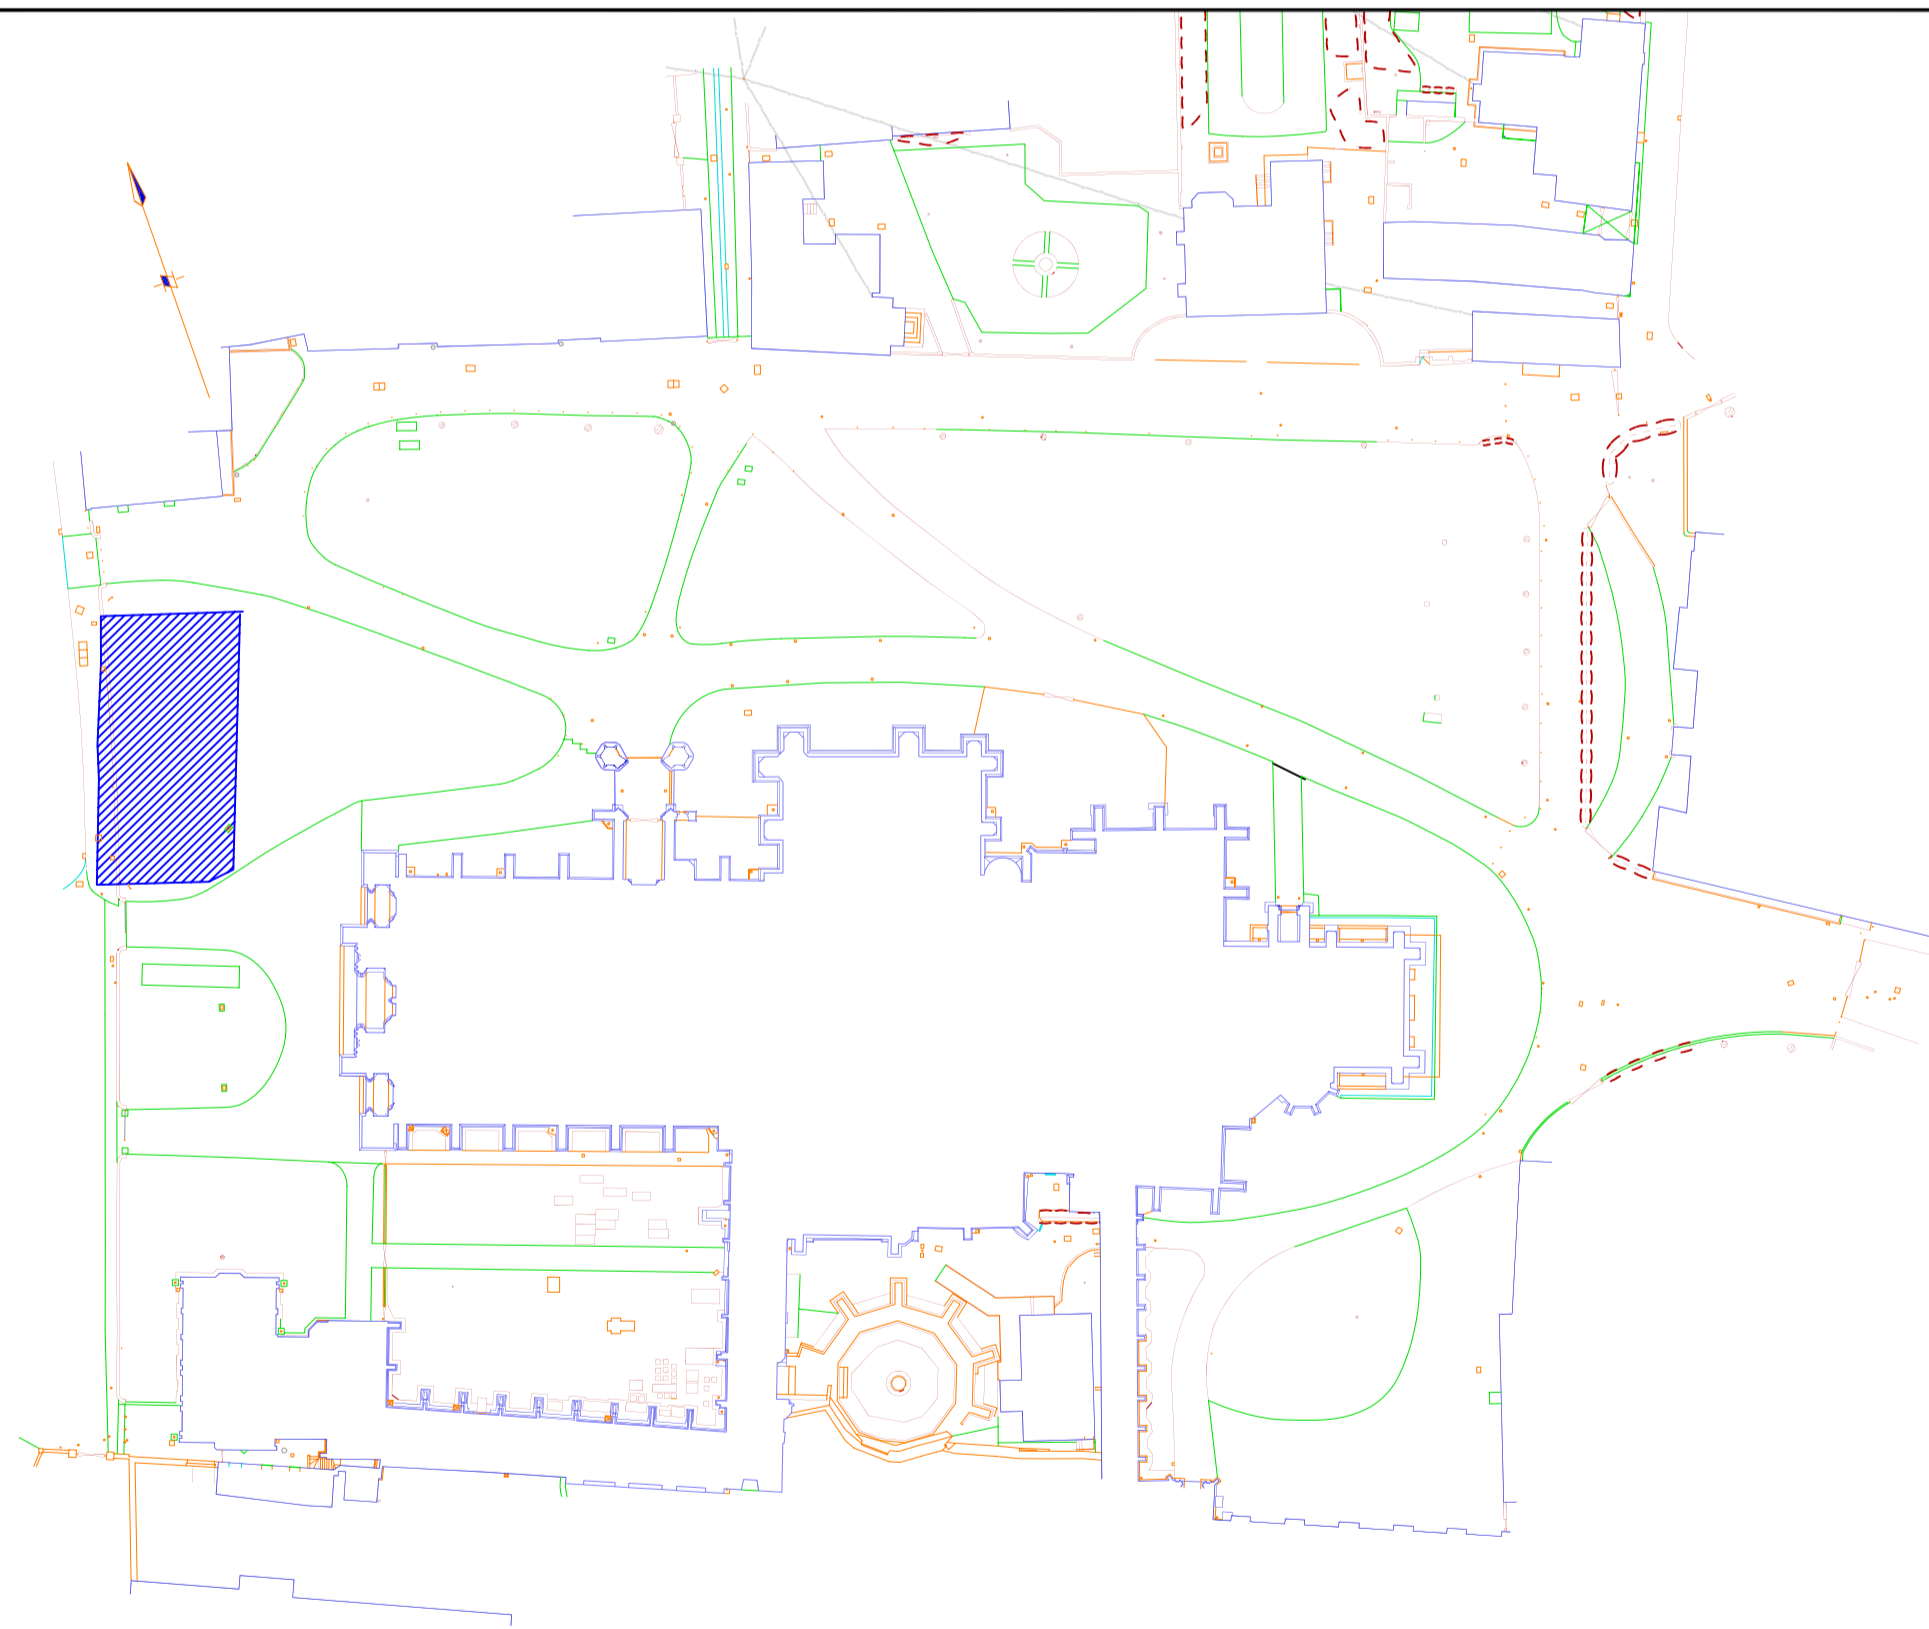

1886 BUILDINGS ALONG BROAD STREET

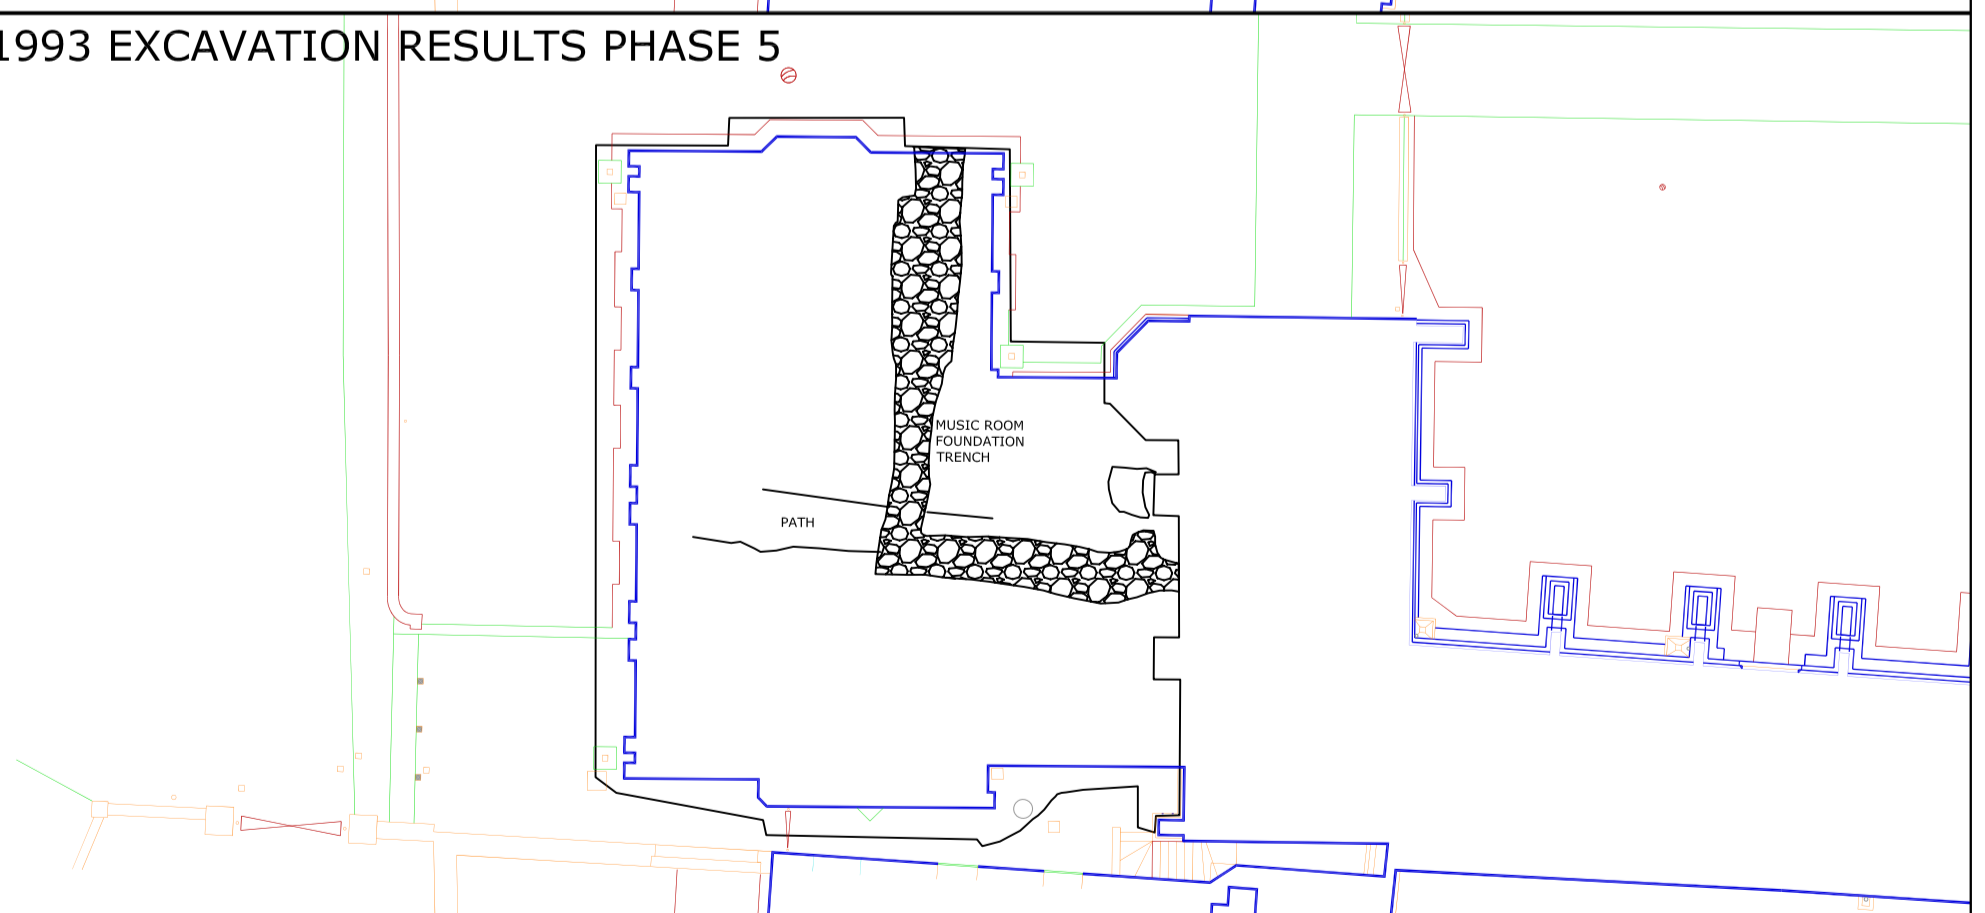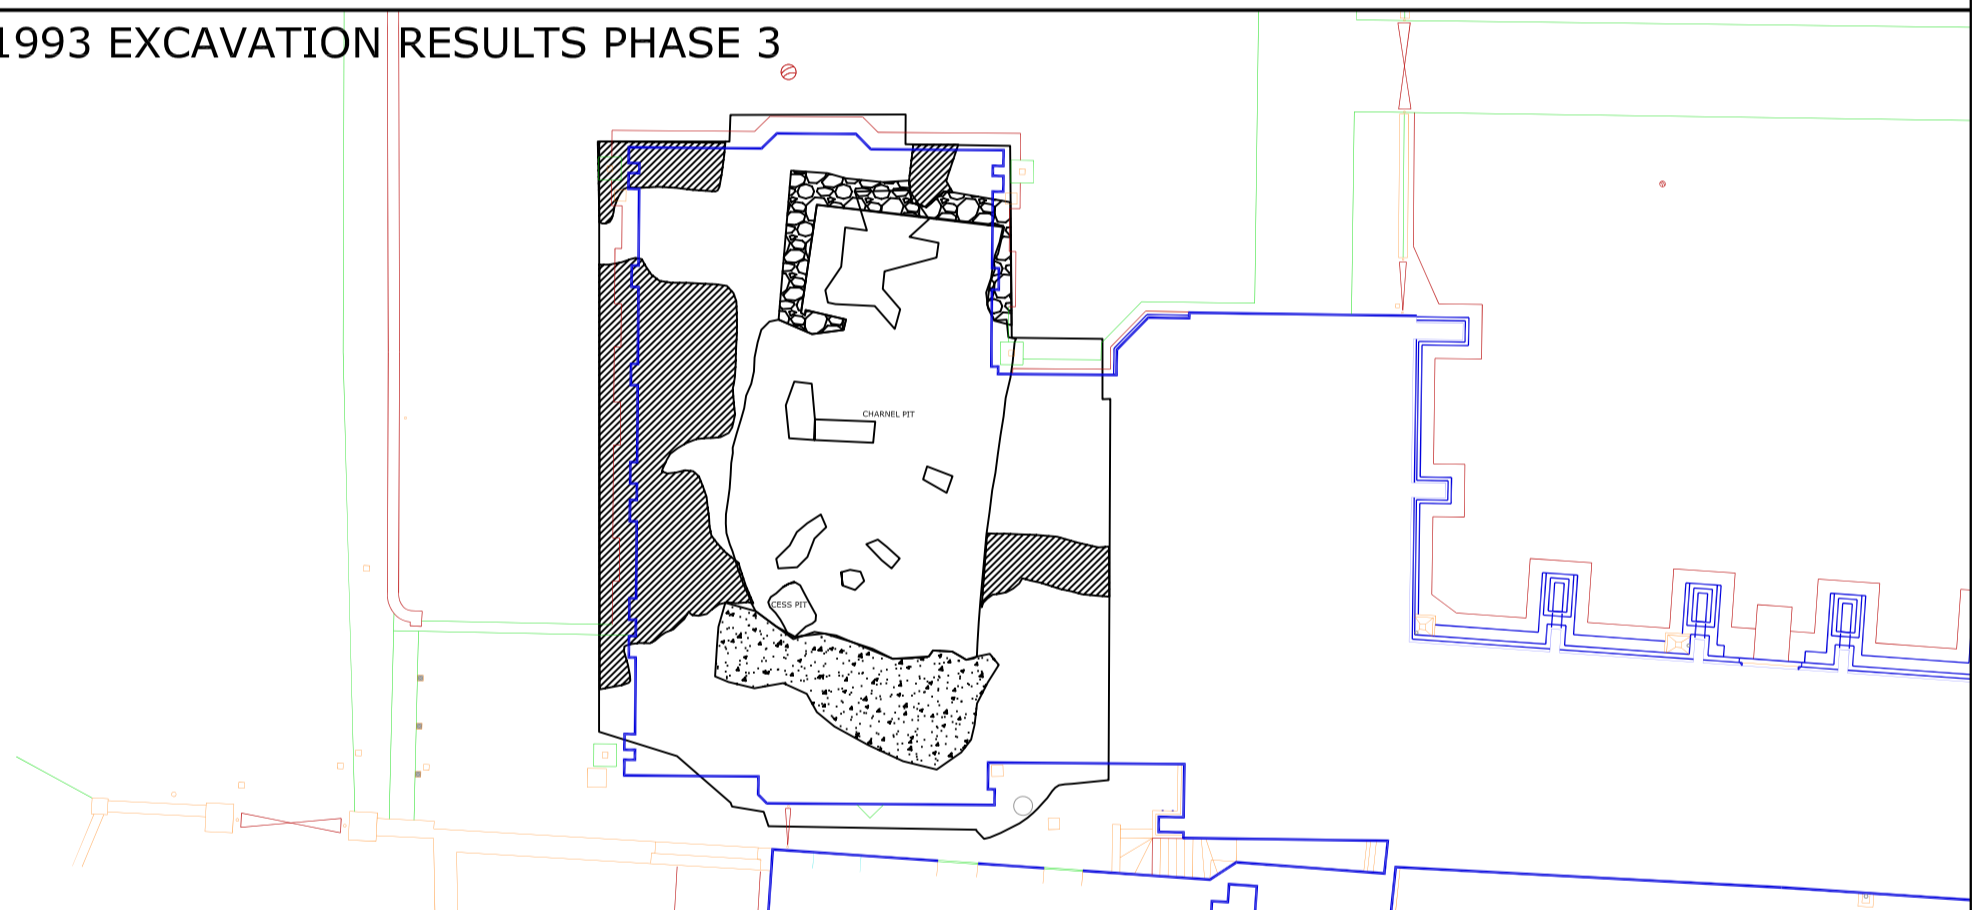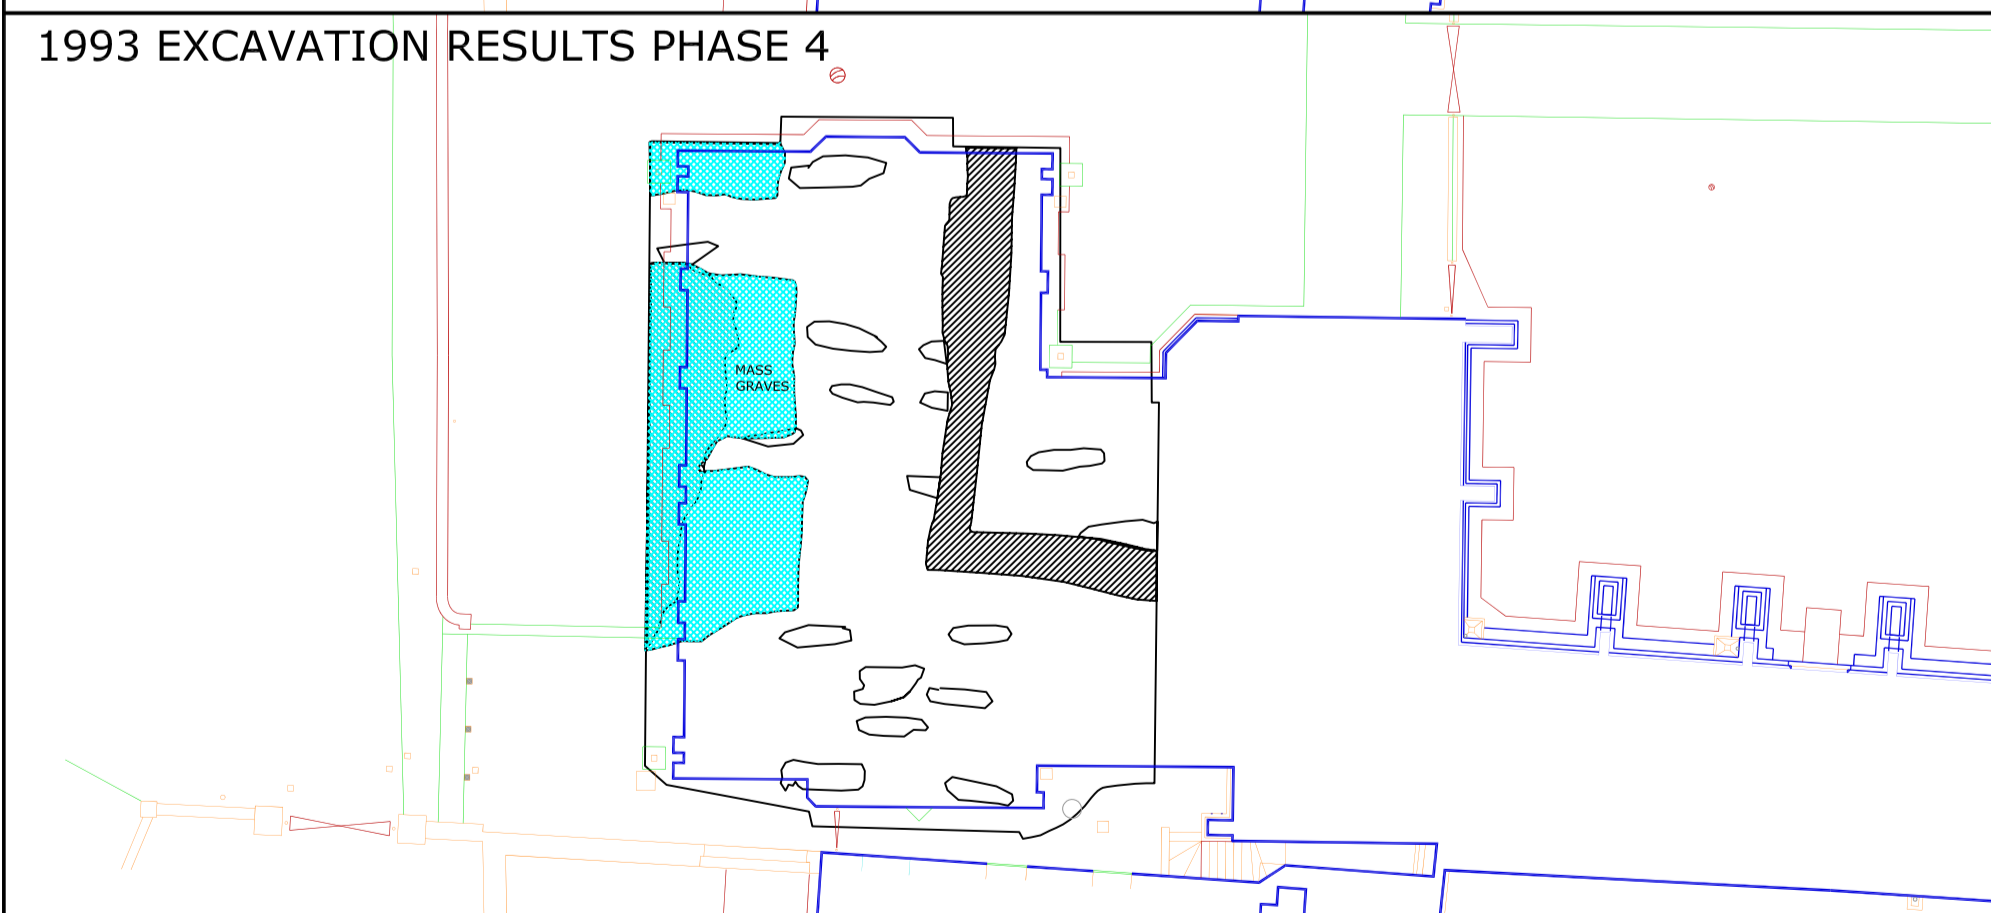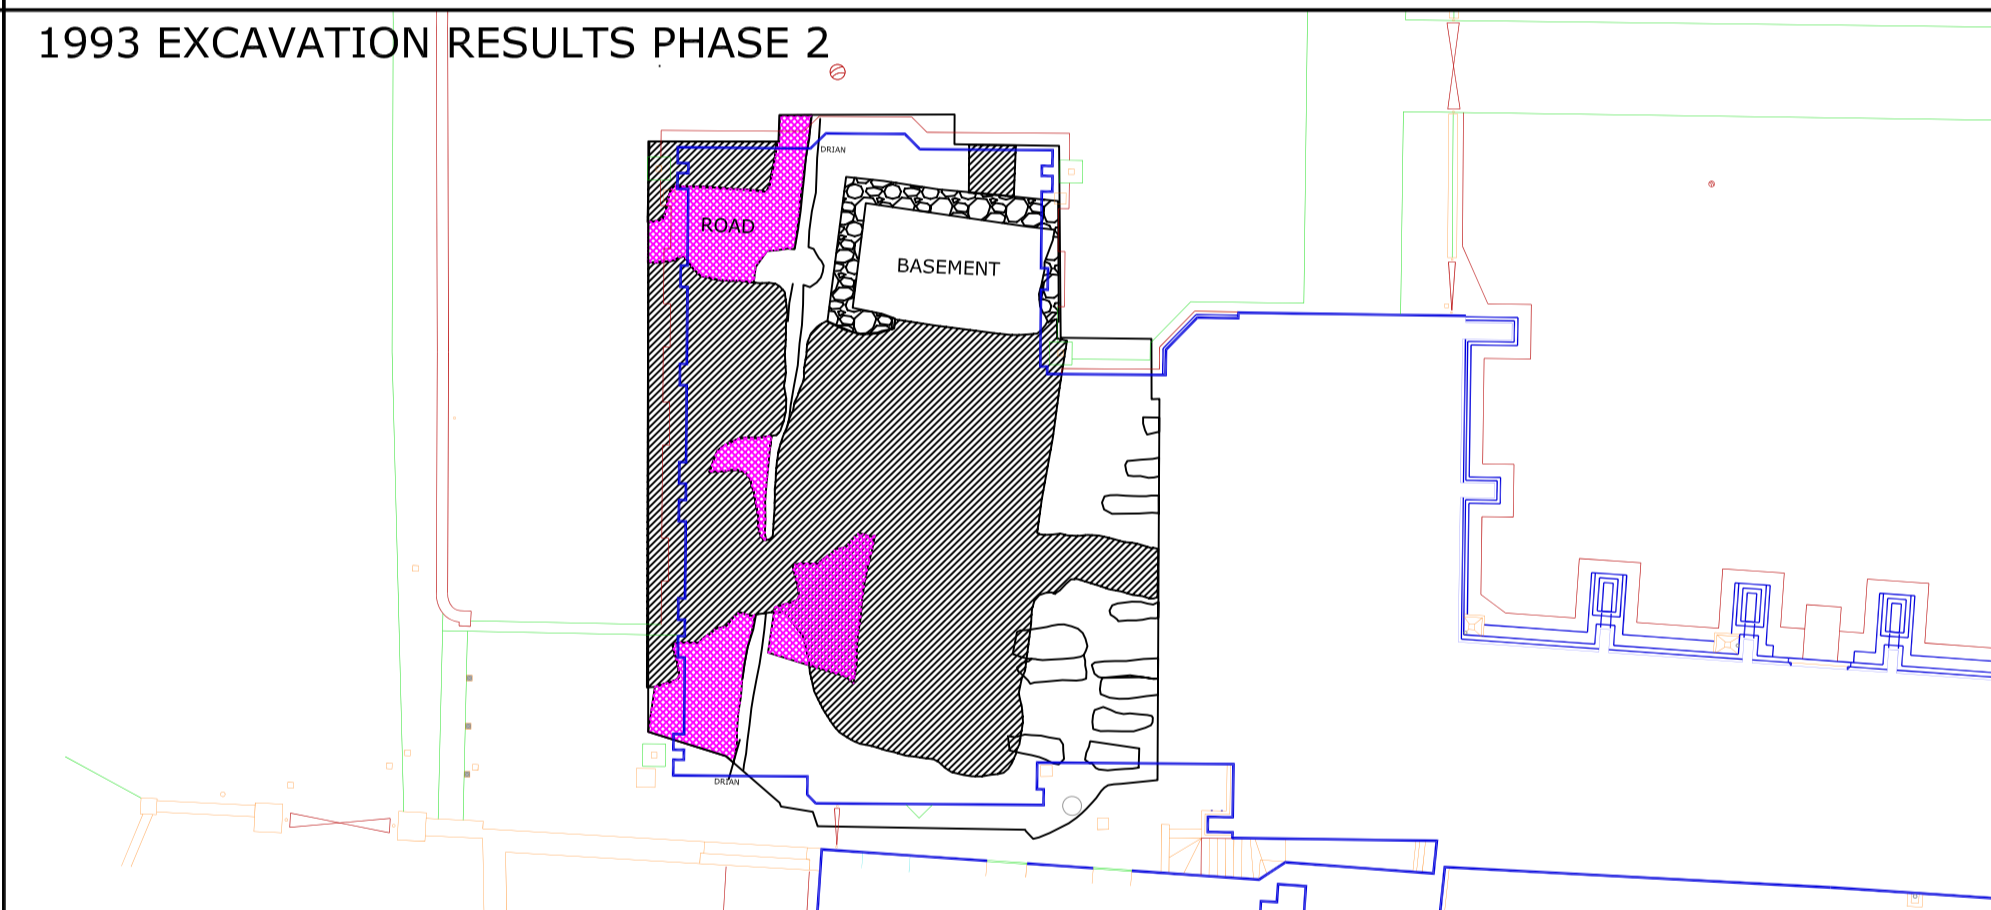

| Amendments |      |             |
|------------|------|-------------|
| Issue No.  | Date | Description |
|            |      |             |

1993 Excavation information taken from  
 A View from Hereford's Past. A report on the archaeological excavation of Hereford Cathedral Close in 1993. 1996. R Stone and N Appleton-Fox

Client  
**HEREFORD CATHEDRAL**

Project Title  
**HEREFORD CATHEDRAL CLOSE**

Supported by  
 The National Lottery through the Heritage Lottery Fund

**STRATASCAN**  
 GEOPHYSICS FOR ARCHAEOLOGY AND ENGINEERING  
 VINEYARD HOUSE  
 UPPER HOOK ROAD  
 UPTON UPON SEVERN  
 UK  
 WR8 0SA  
 T: +44 (0)1684 592266  
 F: +44 (0)1684 594142  
 E: info@stratascan.co.uk  
 www.stratascan.co.uk


Job No. **2118** Survey Date **MARCH 06**

Subject  
**ARCHAEOLOGICAL RECORD**

Scale  
**N/A**

|                       |                          |                         |
|-----------------------|--------------------------|-------------------------|
| Plot<br><b>A1</b>     | Checked by<br><b>PPB</b> | Issue No.<br><b>01</b>  |
| Date<br><b>MAY 06</b> | Drawn by<br><b>HH</b>    | Figure No.<br><b>03</b> |



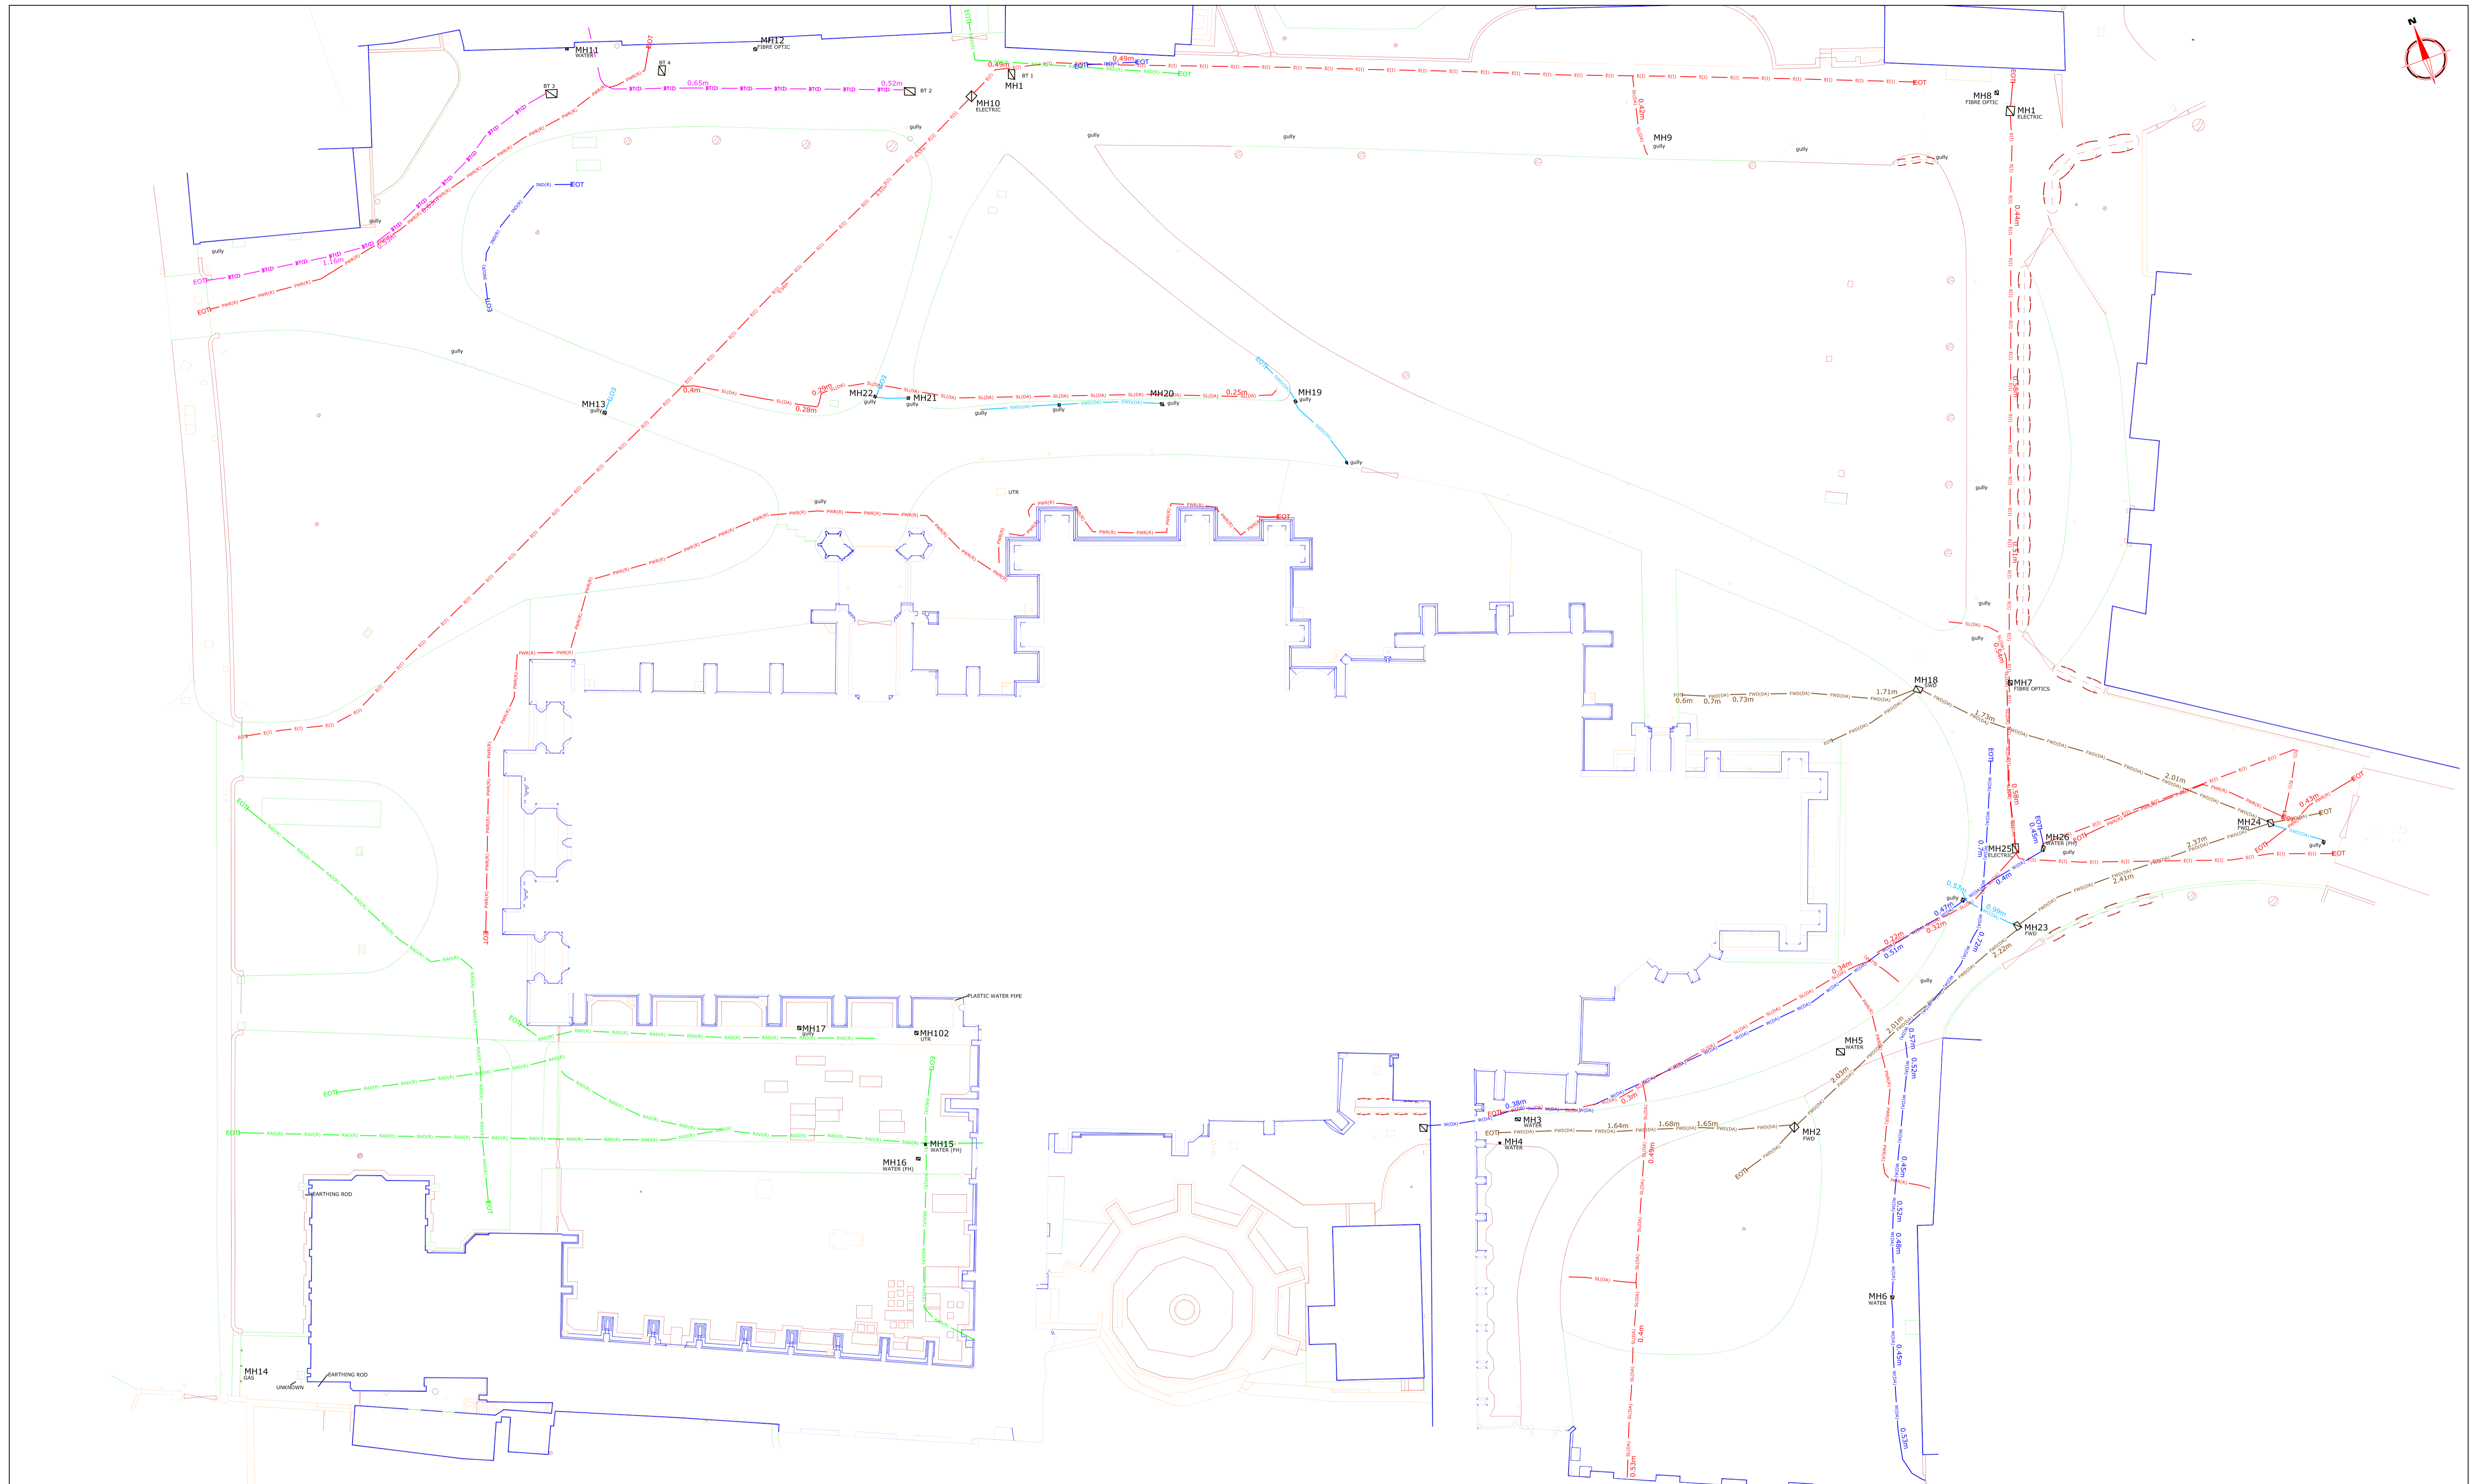

| Amendments |      |             |
|------------|------|-------------|
| Issue No.  | Date | Description |
|            |      |             |

**N.B.**  
**THE UTILITY SURVEY INFORMATION ON THIS PLAN HAS BEEN PRODUCED USING GPR AND ELECTRO-MAGNETIC LOCATING TECHNIQUES. ALTHOUGH BEING THE MOST ACCURATE AVAILABLE, SIGNALS ARE SUSCEPTIBLE TO DISTORTION ON THE SURFACE ESPECIALLY IN CONGESTED AREAS. THERE MAY ALSO BE NON-METALLIC SERVICES AND METALLIC SERVICES PRODUCING INSUFFICIENT SIGNALS FOR ACCURATE LOCATION USING ELECTRO-MAGNETIC TECHNIQUES. WHILST GPR SHOULD DETECT BOTH METALLIC AND NON-METALLIC SERVICES, INDIVIDUAL SERVICES WITHIN CONGESTED AND COMPLEX AREAS MAY BE OBSCURED. WHILST EVERY EFFORT HAS BEEN MADE TO PRODUCE AN ACCURATE PLAN OF THE BURIED SERVICES WITHIN THE SURVEY AREA, CRUCIAL DIMENSIONS AND DEPTHS SHOULD BE CHECKED.**  
**EXTREME CAUTION SHOULD BE TAKEN WHEN ANY EXCAVATION IS UNDERTAKEN - THE INFORMATION CONTAINED WITHIN THIS PLAN MAY NOT REPRESENT THE TOTAL NUMBER OF SERVICES CONTAINED WITHIN THE SURVEY AREA. HEALTH AND SAFETY GUIDELINES SHOULD BE FOLLOWED PRIOR TO EXCAVATION.**

**RADIODETECTION-RD433**  
 Two methods:  
**ACTIVE:** Artificially generated signals from an external source detect metallic services including water and BT. External signals can be applied by either; **INDUCTION:** of a radiating signal from the internal antenna to any conductors nearby. This method is used when inspection chambers are not accessible for all services, or **DIRECT CONNECTION:** of a 8/33/65 kHz signal via valves/inspection chambers. Rodding a sonde is an alternative method used to detect pipes where inspection chambers are present. Sometimes the directly applied signal can jump to adjacent services, allowing them to be detected.  
**PASSIVE:** Naturally occurring signals on a conductor provide information of services present. Two modes used are either **RADIO:** which detects re-radiated radio energy from conductors, or **POWER:** Current running through a metallic service causes an electromagnetic field that can be detected. This is usually in the frequency range of 50 to 60 Hz. If no current flows through the service no electromagnetic field is created and this method cannot be used to trace the service. Radio mode depends on naturally occurring radiowaves through the survey area. If the site is particularly quiet no signal may be re-radiated by the services.  
 All depths are measured to the centre of the service, or to the centre of the Sonde if this is being used. The signals detected by Radio mode do not allow a depth estimate to be calculated.


| KEY      |   |
|----------|---|
| BT (I)   | TELECOMMUNICATIONS (BT) IDENTIFIED BY INDUCTION         |
| E (I)    | ELECTRIC IDENTIFIED BY INDUCTION                        |
| SL (DA)  | STREET LIGHTING IDENTIFIED BY DIRECT APPLICATION        |
| FWD (DA) | FOWL WATER DRAINAGE IDENTIFIED BY DIRECT APPLICATION    |
| SWD (DA) | SURFACE WATER DRAINAGE IDENTIFIED BY DIRECT APPLICATION |
| W (DA)   | WATER IDENTIFIED BY DIRECT APPLICATION                  |
| WIR (R)  | SERVICE IDENTIFIED IN POWER MODE                        |
| RAD (R)  | SERVICE IDENTIFIED IN RADIO MODE                        |
| IND (R)  | SERVICE IDENTIFIED BY INDUCTION                         |
| 0.48m    | APPROXIMATE DEPTH OF SERVICE (m)                        |
| EOT      | END OF TRACE  |

|               |  |
|---------------|--|
| Client        | HEREFORD CATHEDRAL                                     |
| Project Title | HEREFORD CATHEDRAL CLOSE                               |
| Supported by  | The National Lottery through the Heritage Lottery Fund |

**STRATASCAN**  
 GEOPHYSICS FOR ARCHAEOLOGY  
 AND ENGINEERING  
 VINEYARD HOUSE  
 UPPER HOOK ROAD  
 UPTON UPON SEVERN  
 UK  
 WR8 0SA  
 T: +44 (0)1684 592266  
 F: +44 (0)1684 594142  
 E: info@stratascan.co.uk  
 www.stratascan.co.uk

|           |                |             |          |
|-----------|----------------|-------------|----------|
| Job No.   | 2118           | Survey Date | MARCH 06 |
| Subject   | RADIODETECTION |             |          |
| Scale     | 1:250          |             |          |
| Plot      | A1             | Checked by  | PPB      |
| Date      | MAY 06         | Drawn by    | HH       |
| Issue No. | 01             | Figure No.  | 04       |



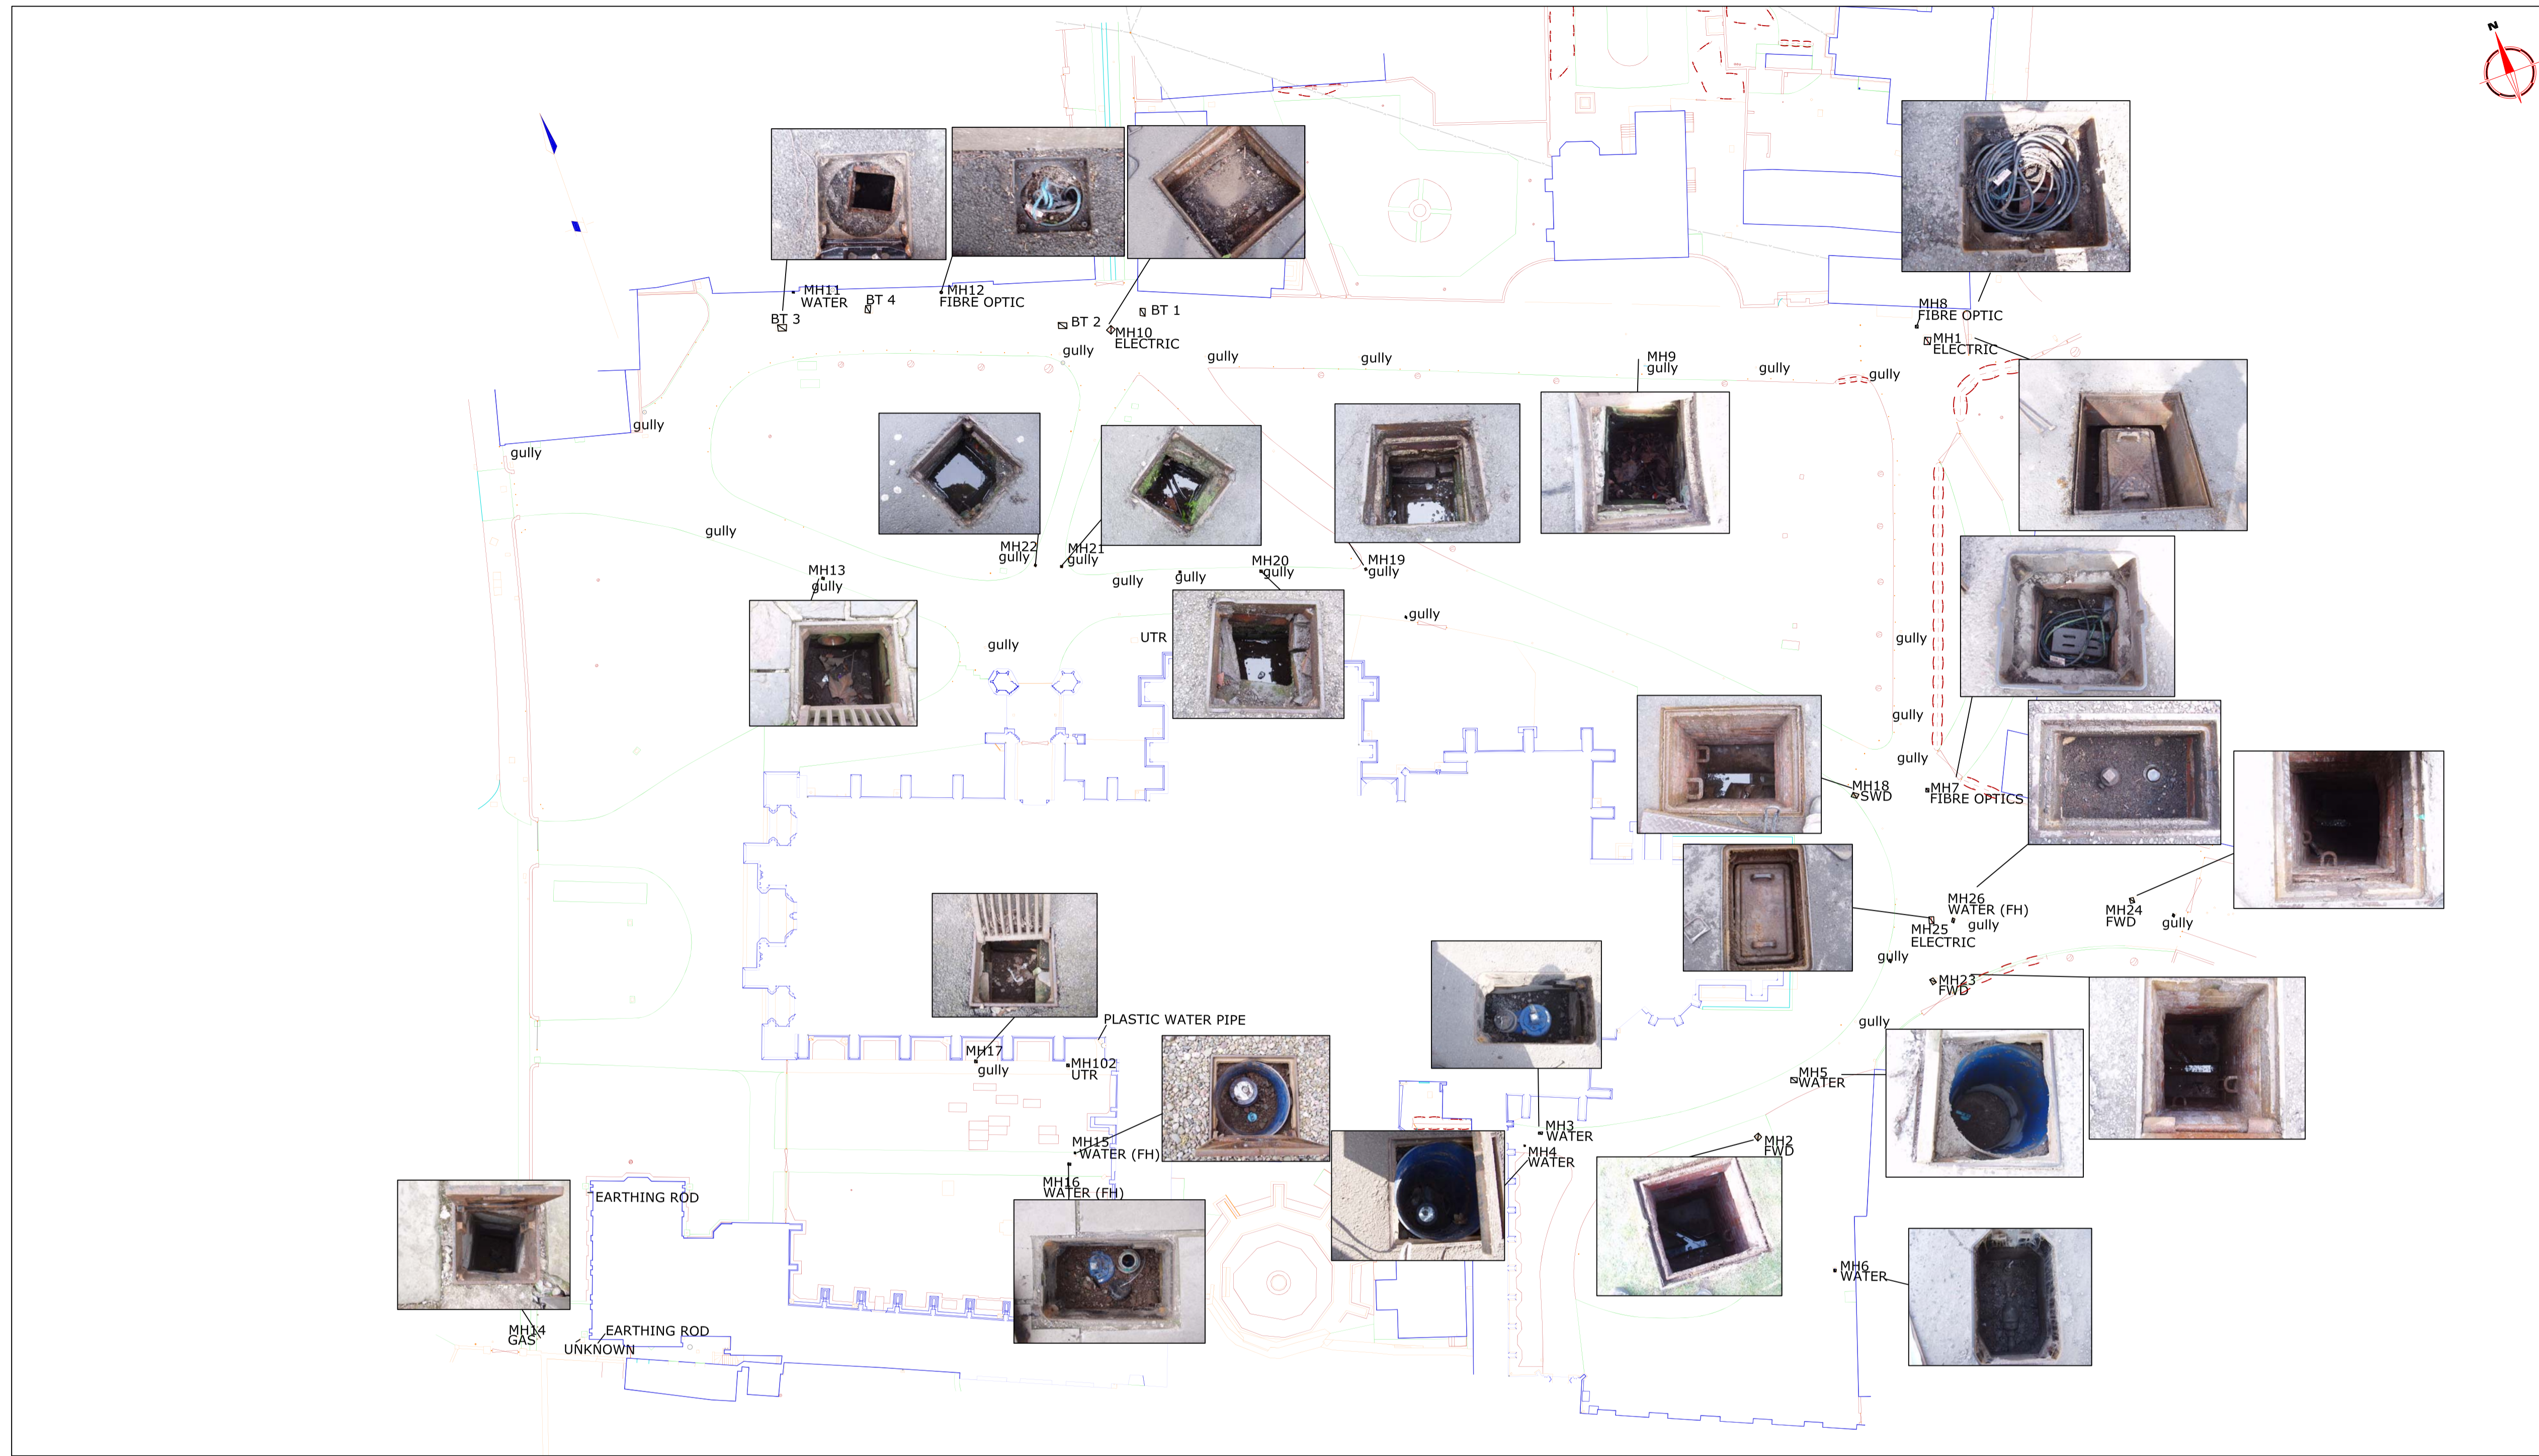

|                                      |                                    |   |
|--------------------------------------|------------------------------------|---|
| MH/ IC Number: 19                    | Duty: SWD (Gully)                  | Comments:                                     |
| Cover Size: 0.250m x 0.250m          | Cover Material: Cast Iron          |   |
| Chamber Size: 0.255m x 0.255m        | Chamber Depth: 0.500m              | Chamber material: Brick                       |
| Entries/Exits                        | Depth to Invert                    | Diameter                                      |
| A                                    | 0.380m                             | 0.120m  |
| MH/ IC Number: 20 Duty: SWD          |                                    |   |
| Cover Size: 0.250m x 0.250m          | Cover Material: Cast Iron          | Comments:                                     |
| Chamber Size: 0.255m x 0.255m        | Chamber Depth: 0.600m              | Chamber material: Brick                       |
| Entries/Exits                        | Depth to Invert                    | Diameter                                      |
| A                                    | 0.200m                             | 0.120m  |
| MH/ IC Number: 21 Duty: SWD          |                                    |   |
| Cover Size: 0.250m x 0.250m          | Cover Material: Cast Iron          | Comments:                                     |
| Chamber Size: 0.255m x 0.255m        | Chamber Depth: 0.550m              | Chamber material: Brick                       |
| Entries/Exits                        | Depth to Invert                    | Diameter                                      |
| A                                    | 0.240m                             | 0.120m  |
| X                                    | 0.240m                             | 0.140m  |
| MH/ IC Number: 22 Duty: SWD          |                                    |   |
| Cover Size: 0.250m x 0.250m          | Cover Material: Cast Iron          | Comments:                                     |
| Chamber Size: 0.255m x 0.255m        | Chamber Depth: 0.470m              | Chamber material: Brick                       |
| Entries/Exits                        | Depth to Invert                    | Diameter                                      |
| A                                    | 0.130m                             | 0.115m  |
| X                                    | 0.120m                             | 0.180m  |
| MH/ IC Number: 23 Duty: FWD          |                                    |   |
| Cover Size: 0.460m x 0.570m          | Cover Material: Ductile Steel      | Comments:                                     |
| Chamber Size: 0.460m x 0.570m        | Chamber Depth: 2.60m               | Chamber material: Brick                       |
| Entries/Exits                        | Depth to Invert                    | Diameter                                      |
| A                                    | FWD                                | 1.890m  |
| B                                    | SWD                                | 1.870m  |
| X                                    | SWD                                | 0.70m   |
| MH/ IC Number: 24 Duty: FWD          |                                    |   |
| Cover Size: 0.440 x 0.540            | Cover Material: Ductile Steel      | Comments:                                     |
| Chamber Size: Unknown                | Chamber Depth: 2.200m              | Chamber material: Brick                       |
| Entries/Exits                        | Depth to Invert                    | Diameter                                      |
| A                                    | 1.960m                             | 0.150m  |
| B                                    | 1.850m                             | 0.150m  |
| C                                    | 0.580m                             | 0.100m  |
| X                                    | 2.200m                             | 0.150m  |
| MH/ IC Number: 25 Duty: Electric     |                                    |   |
| Cover Size: 0.470m x 0.750m          | Cover Material: Concrete and Metal | Comments:                                     |
| Chamber Size: 0.420m x 0.750m        | Chamber Depth: 0.270m              | Chamber material: Metal                       |
| Entries/Exits                        | Depth to Invert                    | Diameter                                      |
| A                                    | 0.190m                             | Unknown                                       |
| X                                    | 0.190m                             | Unknown                                       |
| MH/ IC Number: 26 Duty: Fire Hydrant |                                    |   |
| Cover Size: 0.415m x 0.25m           | Cover Material: Cast Iron          | Comments:                                     |
| Chamber Size: 0.380m x 0.220m        | Chamber Depth: 0.380m              | Chamber material: Brick with Cast Iron Insert |
| Entries/Exits                        | Depth to Invert                    | Diameter                                      |
| A                                    |                                    |   |

|                               |  |                                |
|-------------------------------|--|--------------------------------|
| MH/ IC Number: 1              | Duty: Electrical                                   | Comments:                      |
| Cover Size: 0.79m x 0.64m     | Cover Material: Ductile Steel                      |                                |
| Chamber Size: 0.61m x 0.77m   | Chamber Depth: 0.54m                               | Chamber material: Brick        |
| Entries/Exits                 | Depth to Invert                                    | Diameter                       |
| A                             | 0.4m   |                                |
| MH/ IC Number: 2              |  |                                |
| Duty: Foul Water              | Comments:  |                                |
| Cover Size: 0.52m x 0.52m     | Cover Material: Cast Iron                          |                                |
| Chamber Size: 0.55m x 0.48m   | Chamber Depth: 1.62m                               | Chamber material: Brick        |
| Entries/Exits                 | Depth to Invert                                    | Diameter                       |
| A                             | 0.15m  | 0.08m                          |
| B                             | 0.15m  | clay                           |
| X                             | 1.54m  | 0.15m                          |
| MH/ IC Number: 3              |  |                                |
| Duty: Water                   | Comments:  |                                |
| Cover Size: 0.39m x 0.24m     | Cover Material: Ductile steel                      |                                |
| Chamber Size: 0.39m x 0.24m   | Chamber Depth: 0.3m                                | Chamber material: Concrete     |
| Entries/Exits                 | Depth to Invert                                    | Diameter                       |
| A                             | 0.24m  | 0.13m                          |
| X                             | 0.2m   | 0.8m                           |
| MH/ IC Number: 4              |  |                                |
| Duty: Water                   | Comments:  |                                |
| Cover Size: 0.2m x 0.19m      | Cover Material: Ductile steel                      |                                |
| Chamber Size: 0.2m x 0.19m    | Chamber Depth: 0.6m                                | Chamber material: Concrete     |
| Entries/Exits                 | Depth to Invert                                    | Diameter                       |
| A                             | 1.46m  | 0.10m                          |
| MH/ IC Number: 5              |  |                                |
| Duty: Water                   | Comments:  |                                |
| Cover Size: 0.19m x 0.2m      | Cover Material: Ductile Steel                      |                                |
| Chamber Size: 0.19m x 0.2m    | Chamber Depth: 0.43m                               | Chamber material: plastic      |
| Entries/Exits                 | Depth to Invert                                    | Diameter                       |
| A                             | 0.43m  | 0.04m                          |
| MH/ IC Number: 6              |  |                                |
| Duty: Water                   | Comments:  |                                |
| Cover Size: 0.24m x 0.4m      | Cover Material: Ductile Steel                      |                                |
| Chamber Size: 0.24m x 0.4m    | Chamber Depth: 0.4m                                | Chamber material: Concrete     |
| Entries/Exits                 | Depth to Invert                                    | Diameter                       |
| A                             | 0.39m  | 0.03m                          |
| X                             | 0.3m   | 0.04m                          |
| MH/ IC Number: 7              |  |                                |
| Duty: Fibre Optic             | Comments:  |                                |
| Cover Size: 0.3m x 0.3m       | Cover Material: Ductile Steel                      |                                |
| Chamber Size: 0.31m x 0.31m   | Chamber Depth: 0.32m                               | Chamber material: Brick        |
| Entries/Exits                 | Depth to Invert                                    | Diameter                       |
| A                             | 0.2m   | 0.08m                          |
| X                             | 0.29m  | 0.01m                          |
| Y                             | 0.29m  | 0.01m                          |
| MH/ IC Number: 8              |  |                                |
| Duty: Fibre Optics            | Comments:  |                                |
| Cover Size: 0.3m x 0.3m       | Cover Material: Ductile Steel                      |                                |
| Chamber Size: 0.31m x 0.31m   | Chamber Depth: 0.205m                              | Chamber material: Brick        |
| Entries/Exits                 | Depth to Invert                                    | Diameter                       |
| A                             | 0.07m  | 0.01m                          |
| MH/ IC Number: 9              |  |                                |
| Duty: SWD                     | Comments:  |                                |
| Cover Size: 0.33m x 0.26m     | Cover Material: Cast Iron                          |                                |
| Chamber Size: 0.2m x 0.34m    | Chamber Depth: 0.75m                               | Chamber material: Brick        |
| Entries/Exits                 | Depth to Invert                                    | Diameter                       |
| A                             | 0.54m  | 0.14m                          |
| X                             | 0.54m  | 0.14m                          |
| MH/ IC Number: 10             |  |                                |
| Duty: Electric                | Comments:  |                                |
| Cover Size: 0.67m x 0.67m     | Cover Material: Ductile Steel                      |                                |
| Chamber Size: 0.6m x 0.68m    | Chamber Depth: 0.26m                               | Chamber material: Brick        |
| Entries/Exits                 | Depth to Invert                                    | Diameter                       |
| A                             | 0.26m  | 0.38m                          |
| Y                             | 0.26m  | 0.38m                          |
| MH/ IC Number: 11             |  |                                |
| Duty: Water                   | Comments: Dials at bottom - possible valve beneath |                                |
| Cover Size: 0.19m x 0.21m     | Cover Material: Cast Iron                          |                                |
| Chamber Size: 0.192m x 0.21m  | Chamber Depth: 0.67m                               | Chamber material: Brick        |
| Entries/Exits                 | Depth to Invert                                    | Diameter                       |
| A                             | 0.15m  |                                |
| MH/ IC Number: 12             |  |                                |
| Duty: Fibre Optic             | Comments:  |                                |
| Cover Size: 0.17m x 0.17m     | Cover Material: Plastic                            |                                |
| Chamber Size: 0.17m x 0.17m   | Chamber Depth: Unknown                             | Chamber material: Plastic      |
| Entries/Exits                 | Depth to Invert                                    | Diameter                       |
| A                             | 0.01m  | 0.01m                          |
| MH/ IC Number: 13             |  |                                |
| Duty: SWD                     | Comments:  |                                |
| Cover Size: 0.25m x 0.25m     | Cover Material: Cast Iron                          |                                |
| Chamber Size: 0.25m x 0.25m   | Chamber Depth: 0.46m                               | Chamber material: Brick        |
| Entries/Exits                 | Depth to Invert                                    | Diameter                       |
| A                             | 0.22m  | 0.14m                          |
| MH/ IC Number: 14             |  |                                |
| Duty: GAS                     | Comments:  |                                |
| Cover Size: 0.14m x 0.13m     | Cover Material: Cast Iron                          |                                |
| Chamber Size: 0.14m x 0.15m   | Chamber Depth: 1.19m                               | Chamber material: Breeze Block |
| Entries/Exits                 | Depth to Invert                                    | Diameter                       |
| A                             | 0.55m  | 0.05m                          |
| MH/ IC Number: 15             |  |                                |
| Duty: Water                   | Comments:  |                                |
| Cover Size: 0.19m x 0.19m     | Cover Material: Ductile Steel                      |                                |
| Chamber Size: 0.19m x 0.19m   | Chamber Depth: 0.23m                               | Chamber material: Concrete     |
| Entries/Exits                 | Depth to Invert                                    | Diameter                       |
| A                             | 0.08m  |                                |
| B                             | 0.24m  | 0.035m                         |
| MH/ IC Number: 16             |  |                                |
| Duty: Fire Hydrant            | Comments:  |                                |
| Cover Size: 0.39m x 0.24m     | Cover Material: Ductile Steel                      |                                |
| Chamber Size: 0.39m x 0.24m   | Chamber Depth: 0.29m                               | Chamber material: Breeze block |
| Entries/Exits                 | Depth to Invert                                    | Diameter                       |
| A                             | 0.19m  | 0.14m                          |
| B                             | 0.26m  | 0.1m                           |
| MH/ IC Number: 17             |  |                                |
| Duty: SWD                     | Comments: Hollow - Probably for SWD                |                                |
| Cover Size: 0.25m x 0.25m     | Cover Material: Cast Iron                          |                                |
| Chamber Size: 0.25m x 0.25m   | Chamber Depth: 0.38m                               | Chamber material: Brick        |
| Entries/Exits                 | Depth to Invert                                    | Diameter                       |
| A                             |  |                                |
| MH/ IC Number: 18             |  |                                |
| Duty: FWD                     | Comments: Blocked unable to Sonde                  |                                |
| Cover Size: 0.5m x 0.65m      | Cover Material: Ductile Steel                      |                                |
| Chamber Size: 0.590m x 0.460m | Chamber Depth: 0.140m                              | Chamber material: Brick        |
| Entries/Exits                 | Depth to Invert                                    | Diameter                       |
| A                             | 0.125m   | 0.150m                         |

Client  
**HEREFORD CATHEDRAL**

Project Title  
**HEREFORD CATHEDRAL CLOSE**

Supported by  
**The National Lottery**  
through the Heritage Lottery Fund

Heritage Lottery Fund

**STRATASCAN**  
GEOPHYSICS FOR ARCHAEOLOGY  
AND ENGINEERING

REGISTERED  
GEOLOGIST  
GEOPHYSICIST

Job No. **2118** Survey Date **MARCH 06**

Subject  
**MANHOLE INSPECTION LOG**

Scale  
**1:400**

Plot **A1** Checked by **PPB** Issue No. **01**

Date **MAY 06** Drawn by **HH** Figure No. **05**


T: +44 (0)1684 592266  
F: +44 (0)1684 594142  
E: info@stratascan.co.uk  
www.stratascan.co.uk

Scale  
**1:400**

Plot **A1** Checked by **PPB** Issue No. **01**

Date **MAY 06** Drawn by **HH** Figure No. **05**



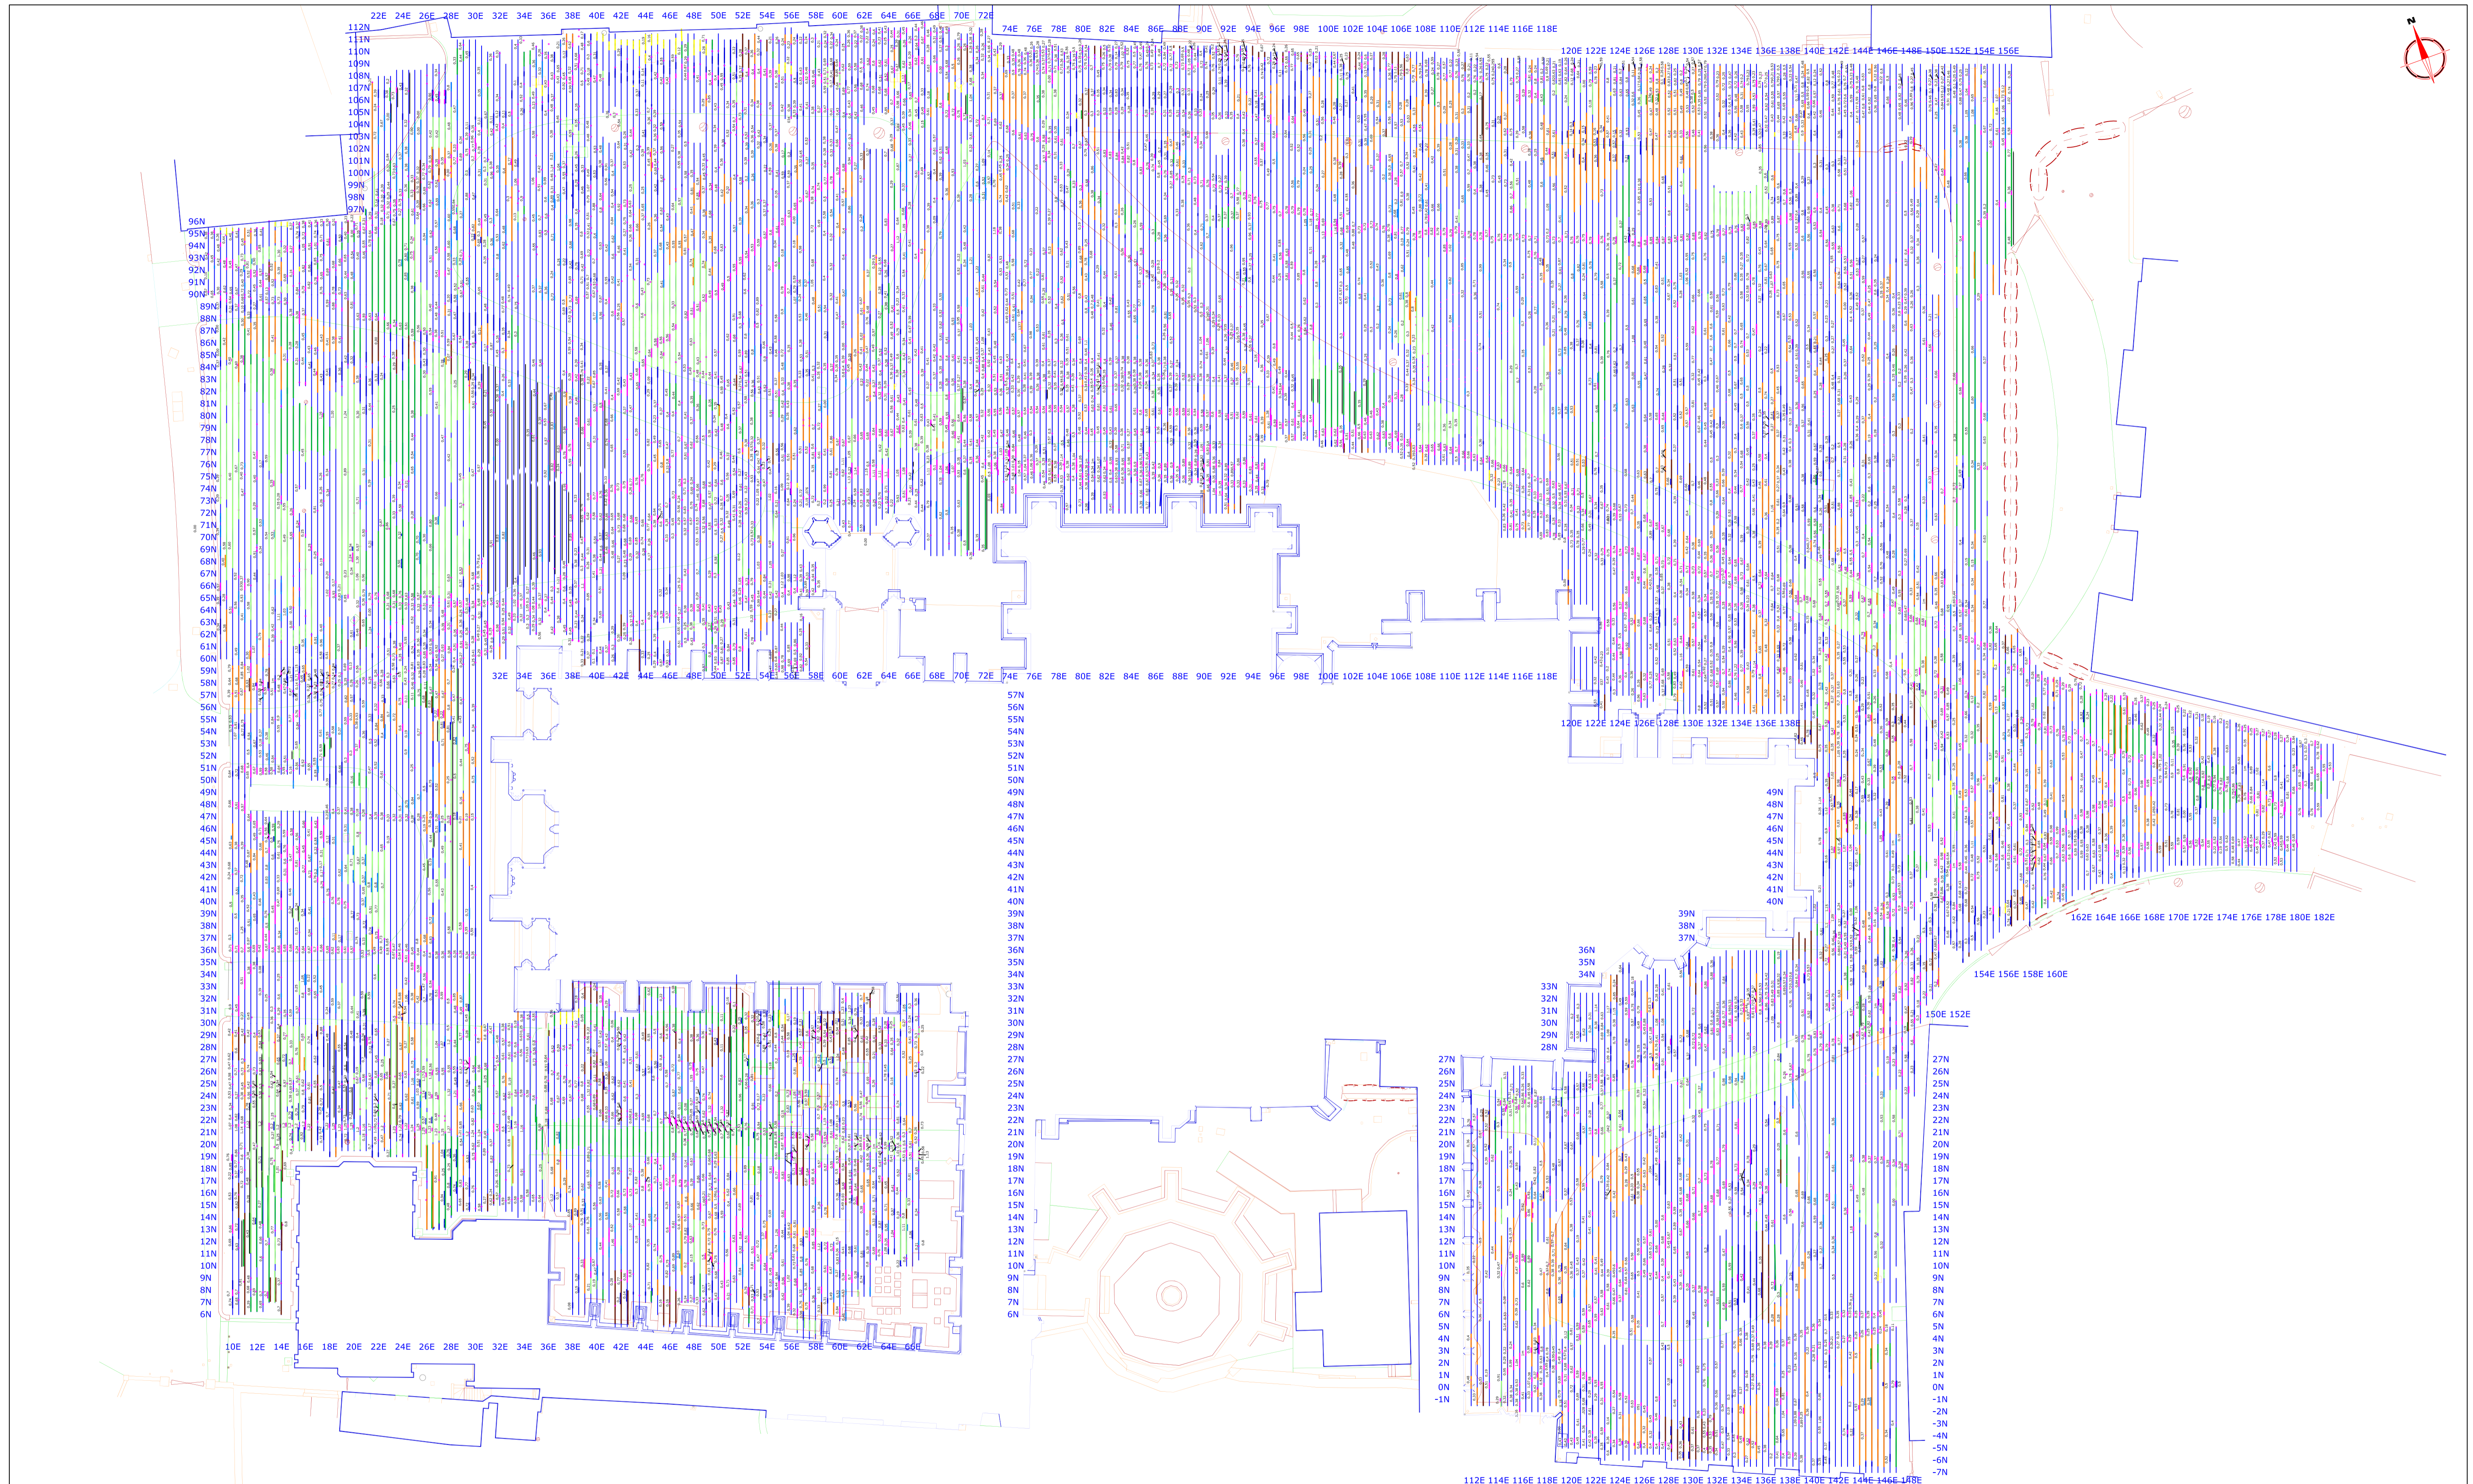

| Amendments |      |             |
|------------|------|-------------|
| Issue No.  | Date | Description |
| -          | -    | -           |
| -          | -    | -           |


| Radar Abstraction |                             |
|-------------------|-----------------------------|
|                   | Strong Discrete             |
|                   | Weak Discrete               |
|                   | Strong Complex              |
|                   | Weak Complex                |
|                   | Point Diffraction           |
|                   | Broad Crested               |
|                   | Strong Planar               |
|                   | Weak Planar                 |
|                   | Conductive Surface          |
|                   | Inclined Event              |
| 0.25              | Depth to top of feature (m) |

|               |   |
|---------------|---|
| Client        | HEREFORD CATHEDRAL  |
| Project Title | HEREFORD CATHEDRAL CLOSE                                  |
| Supported by  | The National Lottery<br>through the Heritage Lottery Fund |
|               |   |

**STRATASCAN**  
 GEOPHYSICS FOR ARCHAEOLOGY  
 AND ENGINEERING  
 VINEYARD HOUSE  
 UPPER UPON ROAD  
 UPTON UPON SEVERN  
 UK  
 WR8 0SA  
 T: +44 (0)1684 592266  
 F: +44 (0)1684 594142  
 E: info@stratascan.co.uk  
 www.stratascan.co.uk

|         |                        |             |          |
|---------|------------------------|-------------|----------|
| Job No. | 2118                   | Survey Date | MARCH 06 |
| Subject | GPR ABSTRACTION 400MHZ |             |          |
| Scale   | 1:250                  |             |          |
| Plot    | A1                     | Checked by  | PPB      |
| Date    | MAY 06                 | Issue No.   | 01       |
|         |                        | Figure No.  | 06       |



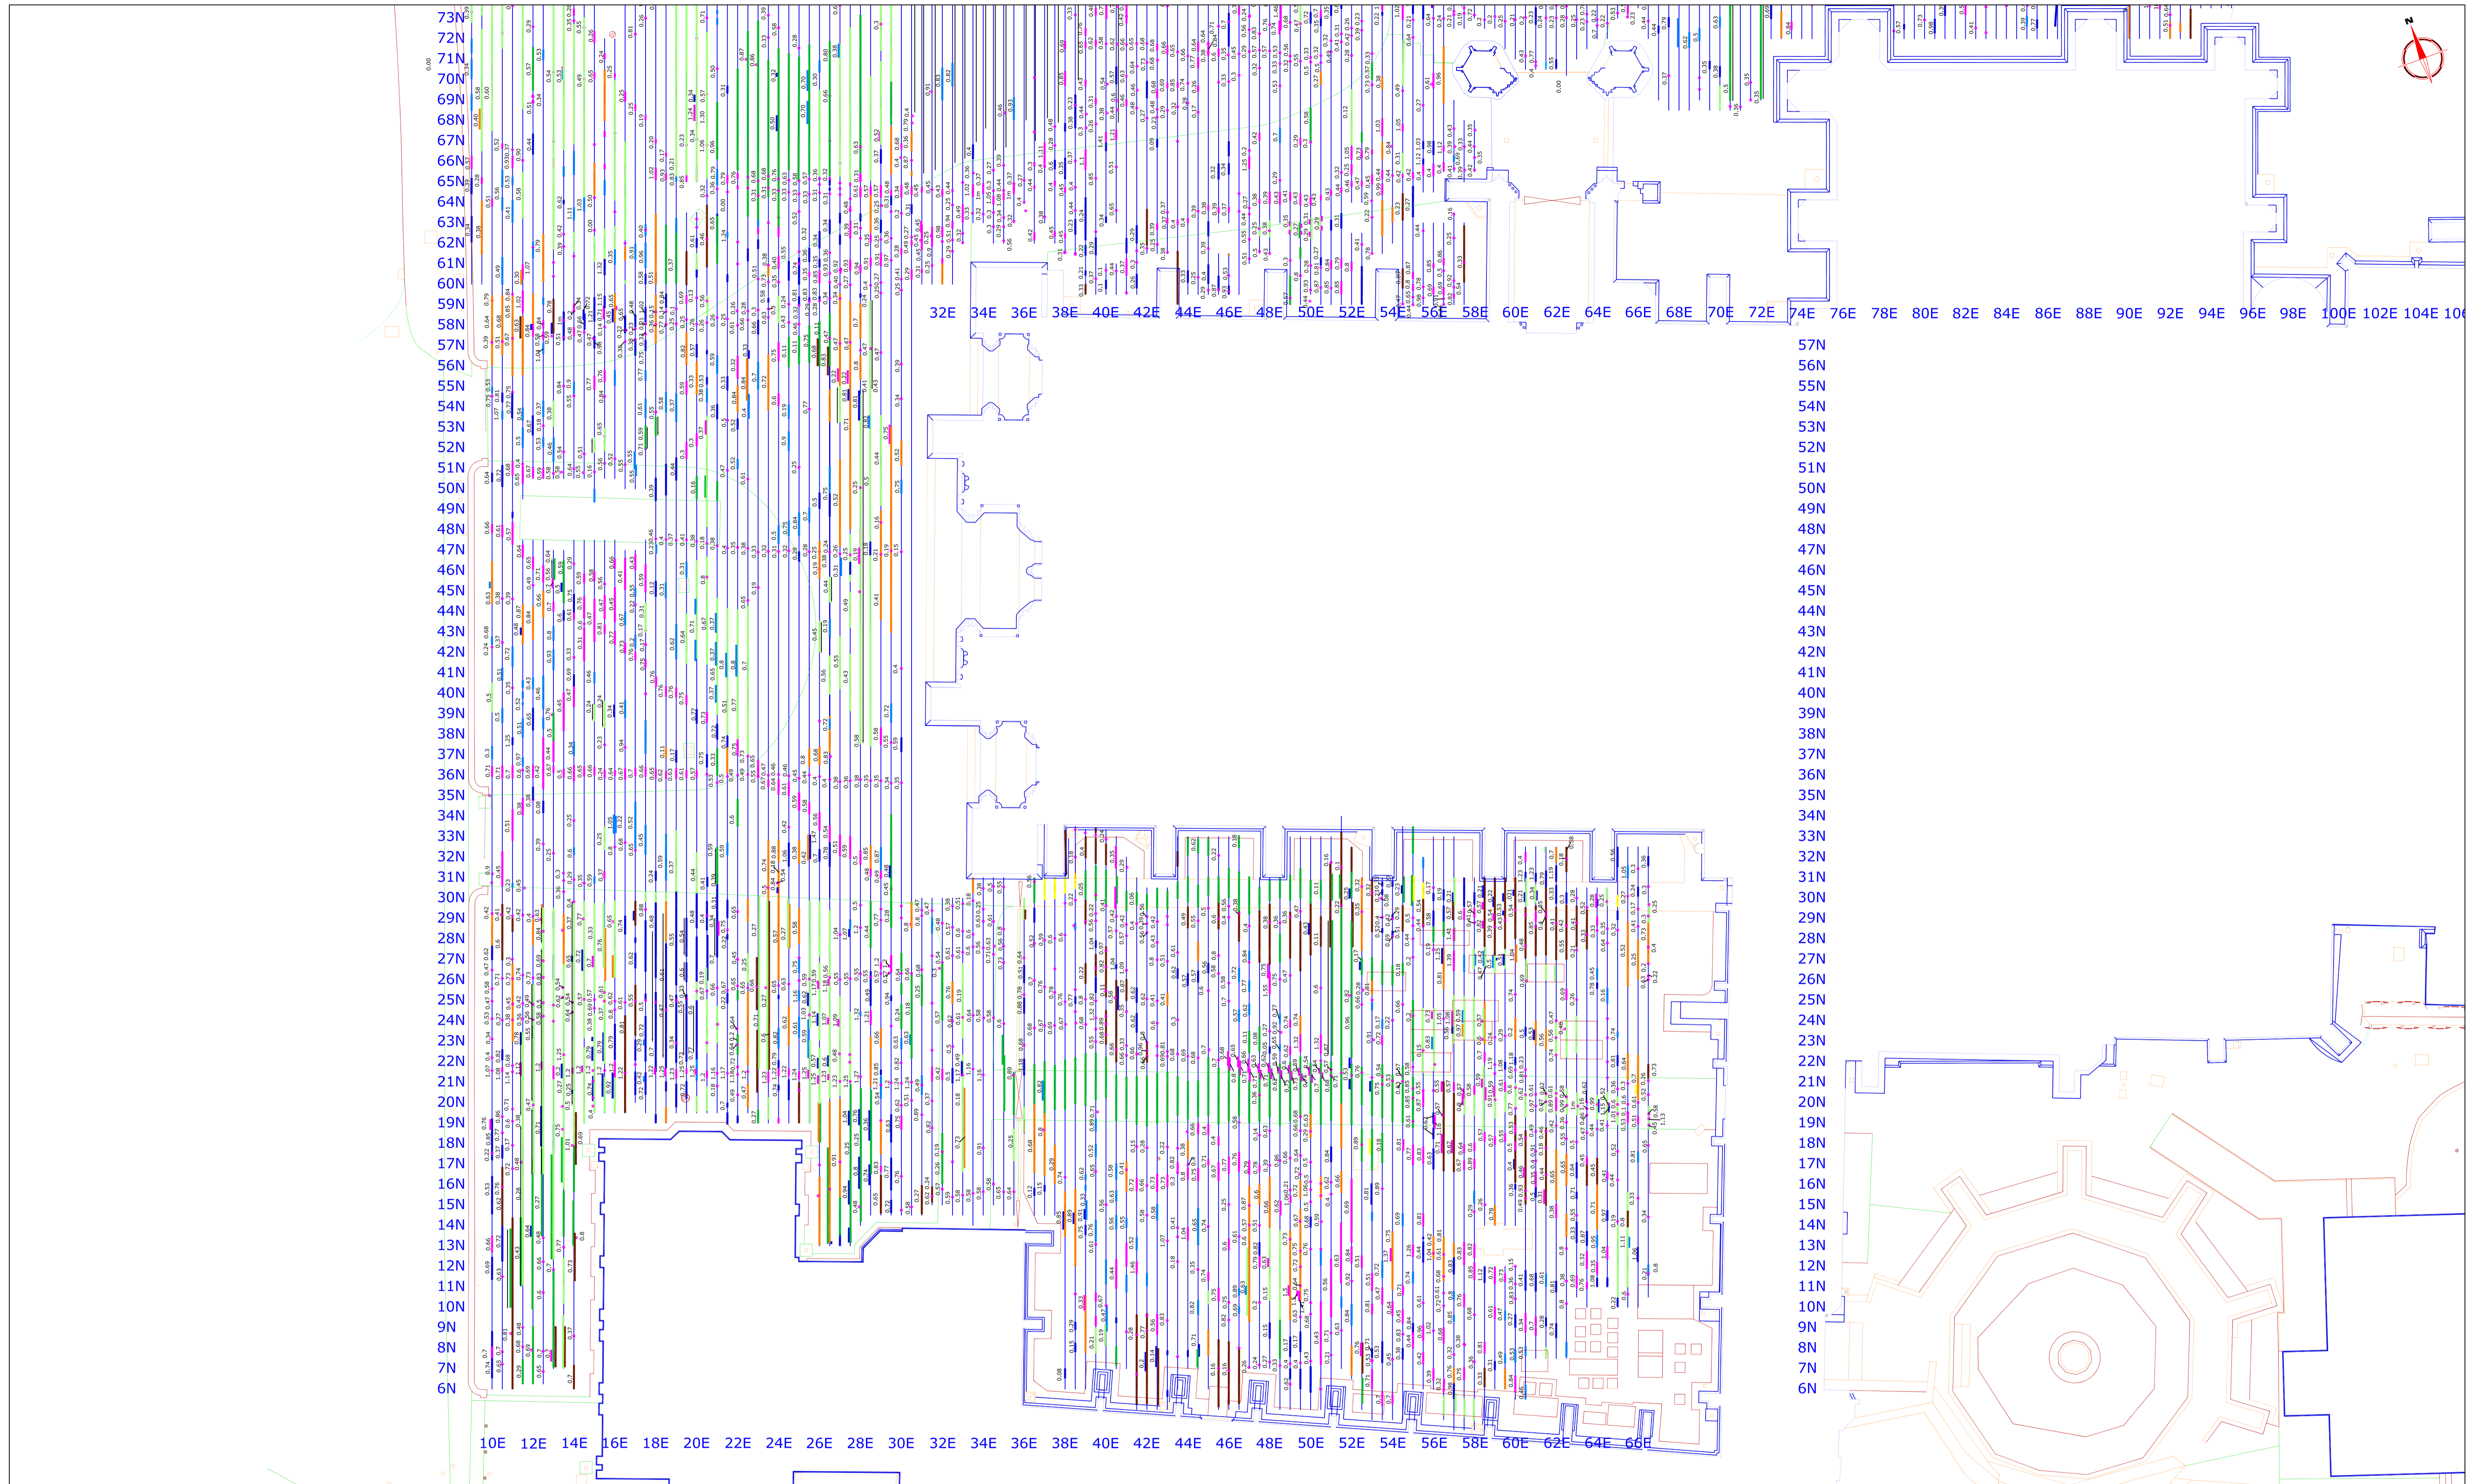

| Amendments |      |             |
|------------|------|-------------|
| Issue No.  | Date | Description |
| -          | -    | -           |


| Radar Abstraction |                             |
|-------------------|-----------------------------|
|                   | Strong Discrete             |
|                   | Weak Discrete               |
|                   | Strong Complex              |
|                   | Weak Complex                |
|                   | Point Diffraction           |
|                   | Broad Crested               |
|                   | Strong Planar               |
|                   | Weak Planar                 |
|                   | Conductive Surface          |
|                   | Inclined Event              |
|                   | Depth to top of feature (m) |

|               |   |
|---------------|---|
| Client        | HEREFORD CATHEDRAL  |
| Project Title | HEREFORD CATHEDRAL CLOSE                                  |
| Supported by  | The National Lottery<br>through the Heritage Lottery Fund |
|               |   |

**STRATASCAN**  
 GEOPHYSICS FOR ARCHAEOLOGY  
 AND ENGINEERING  
 VINEYARD HOUSE  
 UPPER HOOK ROAD  
 UPTON UPON SEVERN  
 UK  
 WR8 0SA  
 T: +44 (0)1684 592266  
 F: +44 (0)1684 594142  
 E: info@stratascan.co.uk  
 www.stratascan.co.uk

|         |                                   |             |            |
|---------|-----------------------------------|-------------|------------|
| Job No. | 2118                              | Survey Date | MARCH 06   |
| Subject | GPR ABSTRACTION 400MHZ SOUTH WEST |             |            |
| Scale   | 1:150                             |             |            |
| Plot    | A1                                | Checked by  | PPB        |
| Date    | MAY 06                            | Issue No.   | 01         |
|         | Drawn by                          | HH/SH       | Figure No. |
|         |                                   |             | 06a        |



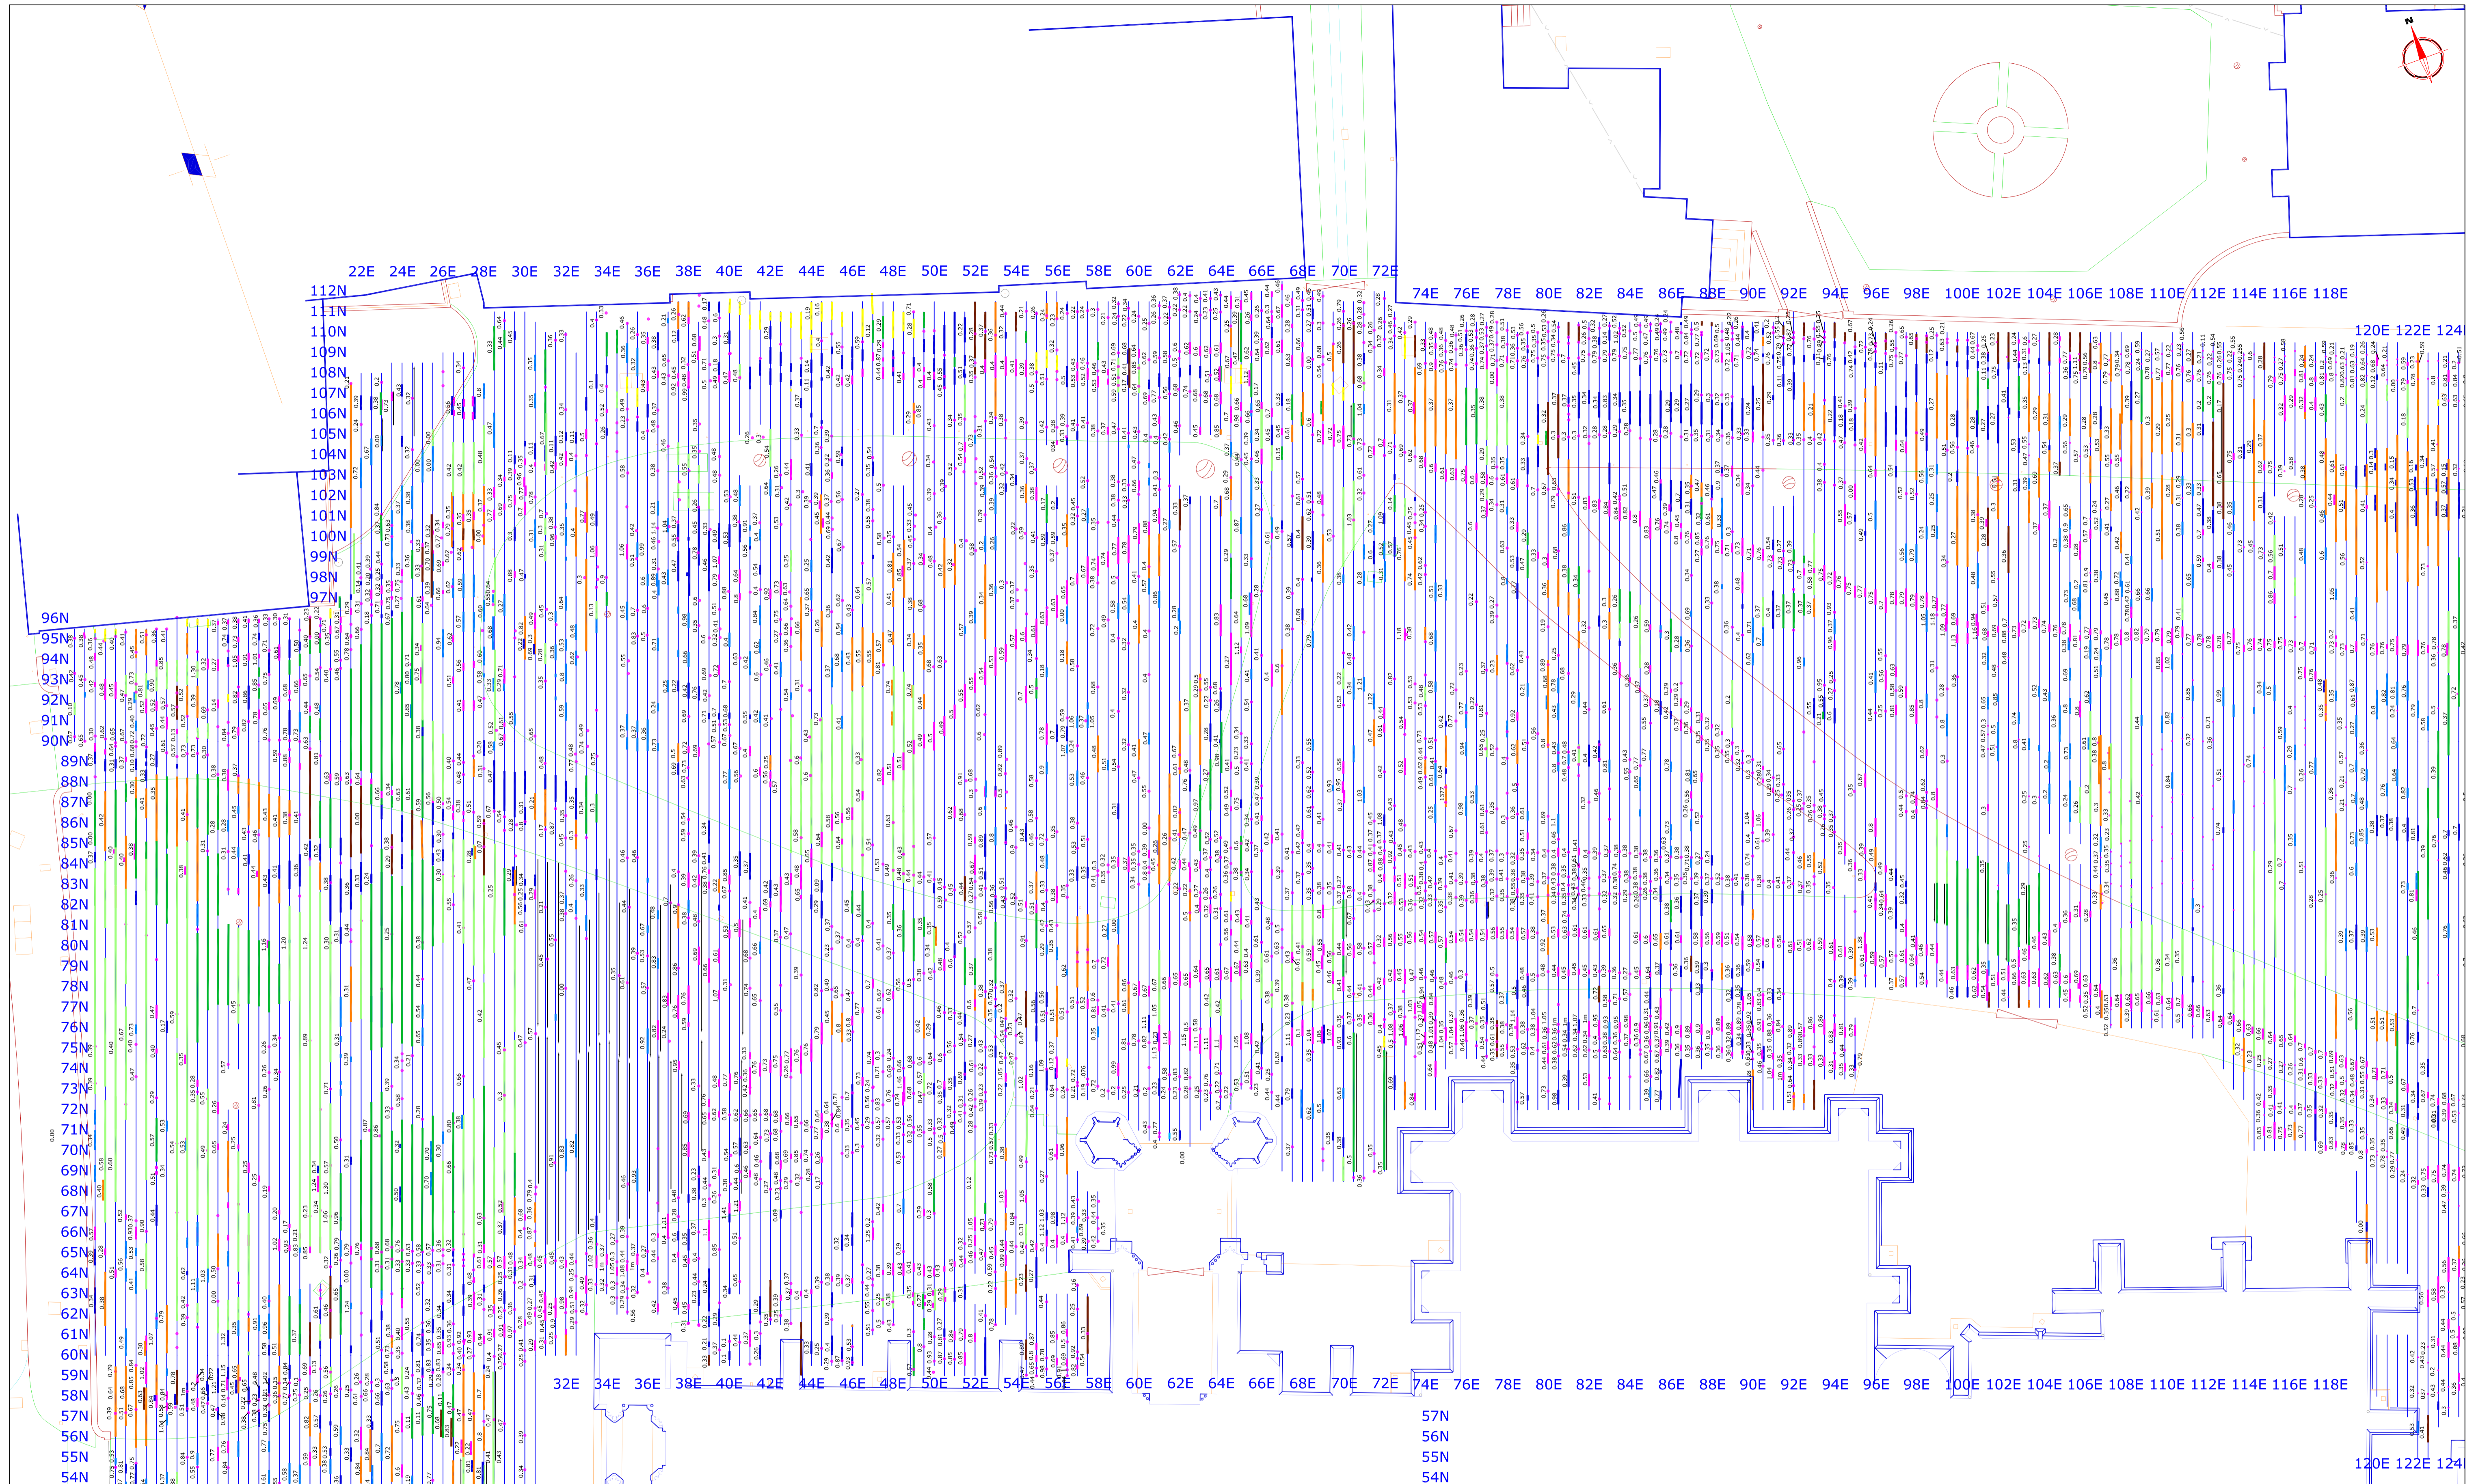

| Issue No. | Date | Description |
|-----------|------|-------------|
| 1         |      |             |

| Amendments |      |
|------------|------|
| Issue No.  | Date |
| 1          |      |


| Radar Abstraction |                   | Client |                             |
|-------------------|-------------------|--------|-----------------------------|
|                   | Strong Discrete   |        | Conductive Surface          |
|                   | Weak Discrete     |        | Inclined Event              |
|                   | Strong Complex    |        | Depth to top of feature (m) |
|                   | Weak Complex      |        |                             |
|                   | Point Diffraction |        |                             |
|                   | Broad Crested     |        |                             |
|                   | Strong Planar     |        |                             |
|                   | Weak Planar       |        |                             |

|                       |  |
|-----------------------|--|
| Client                | HEREFORD CATHEDRAL                                     |
| Project Title         | HEREFORD CATHEDRAL CLOSE                               |
| Supported by          | The National Lottery through the Heritage Lottery Fund |
| Heritage Lottery Fund |  |

**STRATASCAN**  
 GEOPHYSICS FOR ARCHAEOLOGY  
 AND ENGINEERING  
 VINEYARD HOUSE  
 UPPER HOOK ROAD  
 UPTON UPON SEVERN  
 UK  
 WR8 0SA  
 T: +44 (0)1684 592266  
 F: +44 (0)1684 594142  
 E: info@stratascan.co.uk  
 www.stratascan.co.uk

|           |                                   |             |          |
|-----------|-----------------------------------|-------------|----------|
| Job No.   | 2118                              | Survey Date | MARCH 06 |
| Subject   | GPR ABSTRACTION 400MHZ NORTH WEST |             |          |
| Scale     | 1:150                             |             |          |
| Plot      | A1                                | Checked by  | PPB      |
| Date      | MAY 06                            | Drawn by    | HH/SH    |
| Issue No. | 01                                | Figure No.  | 06b      |



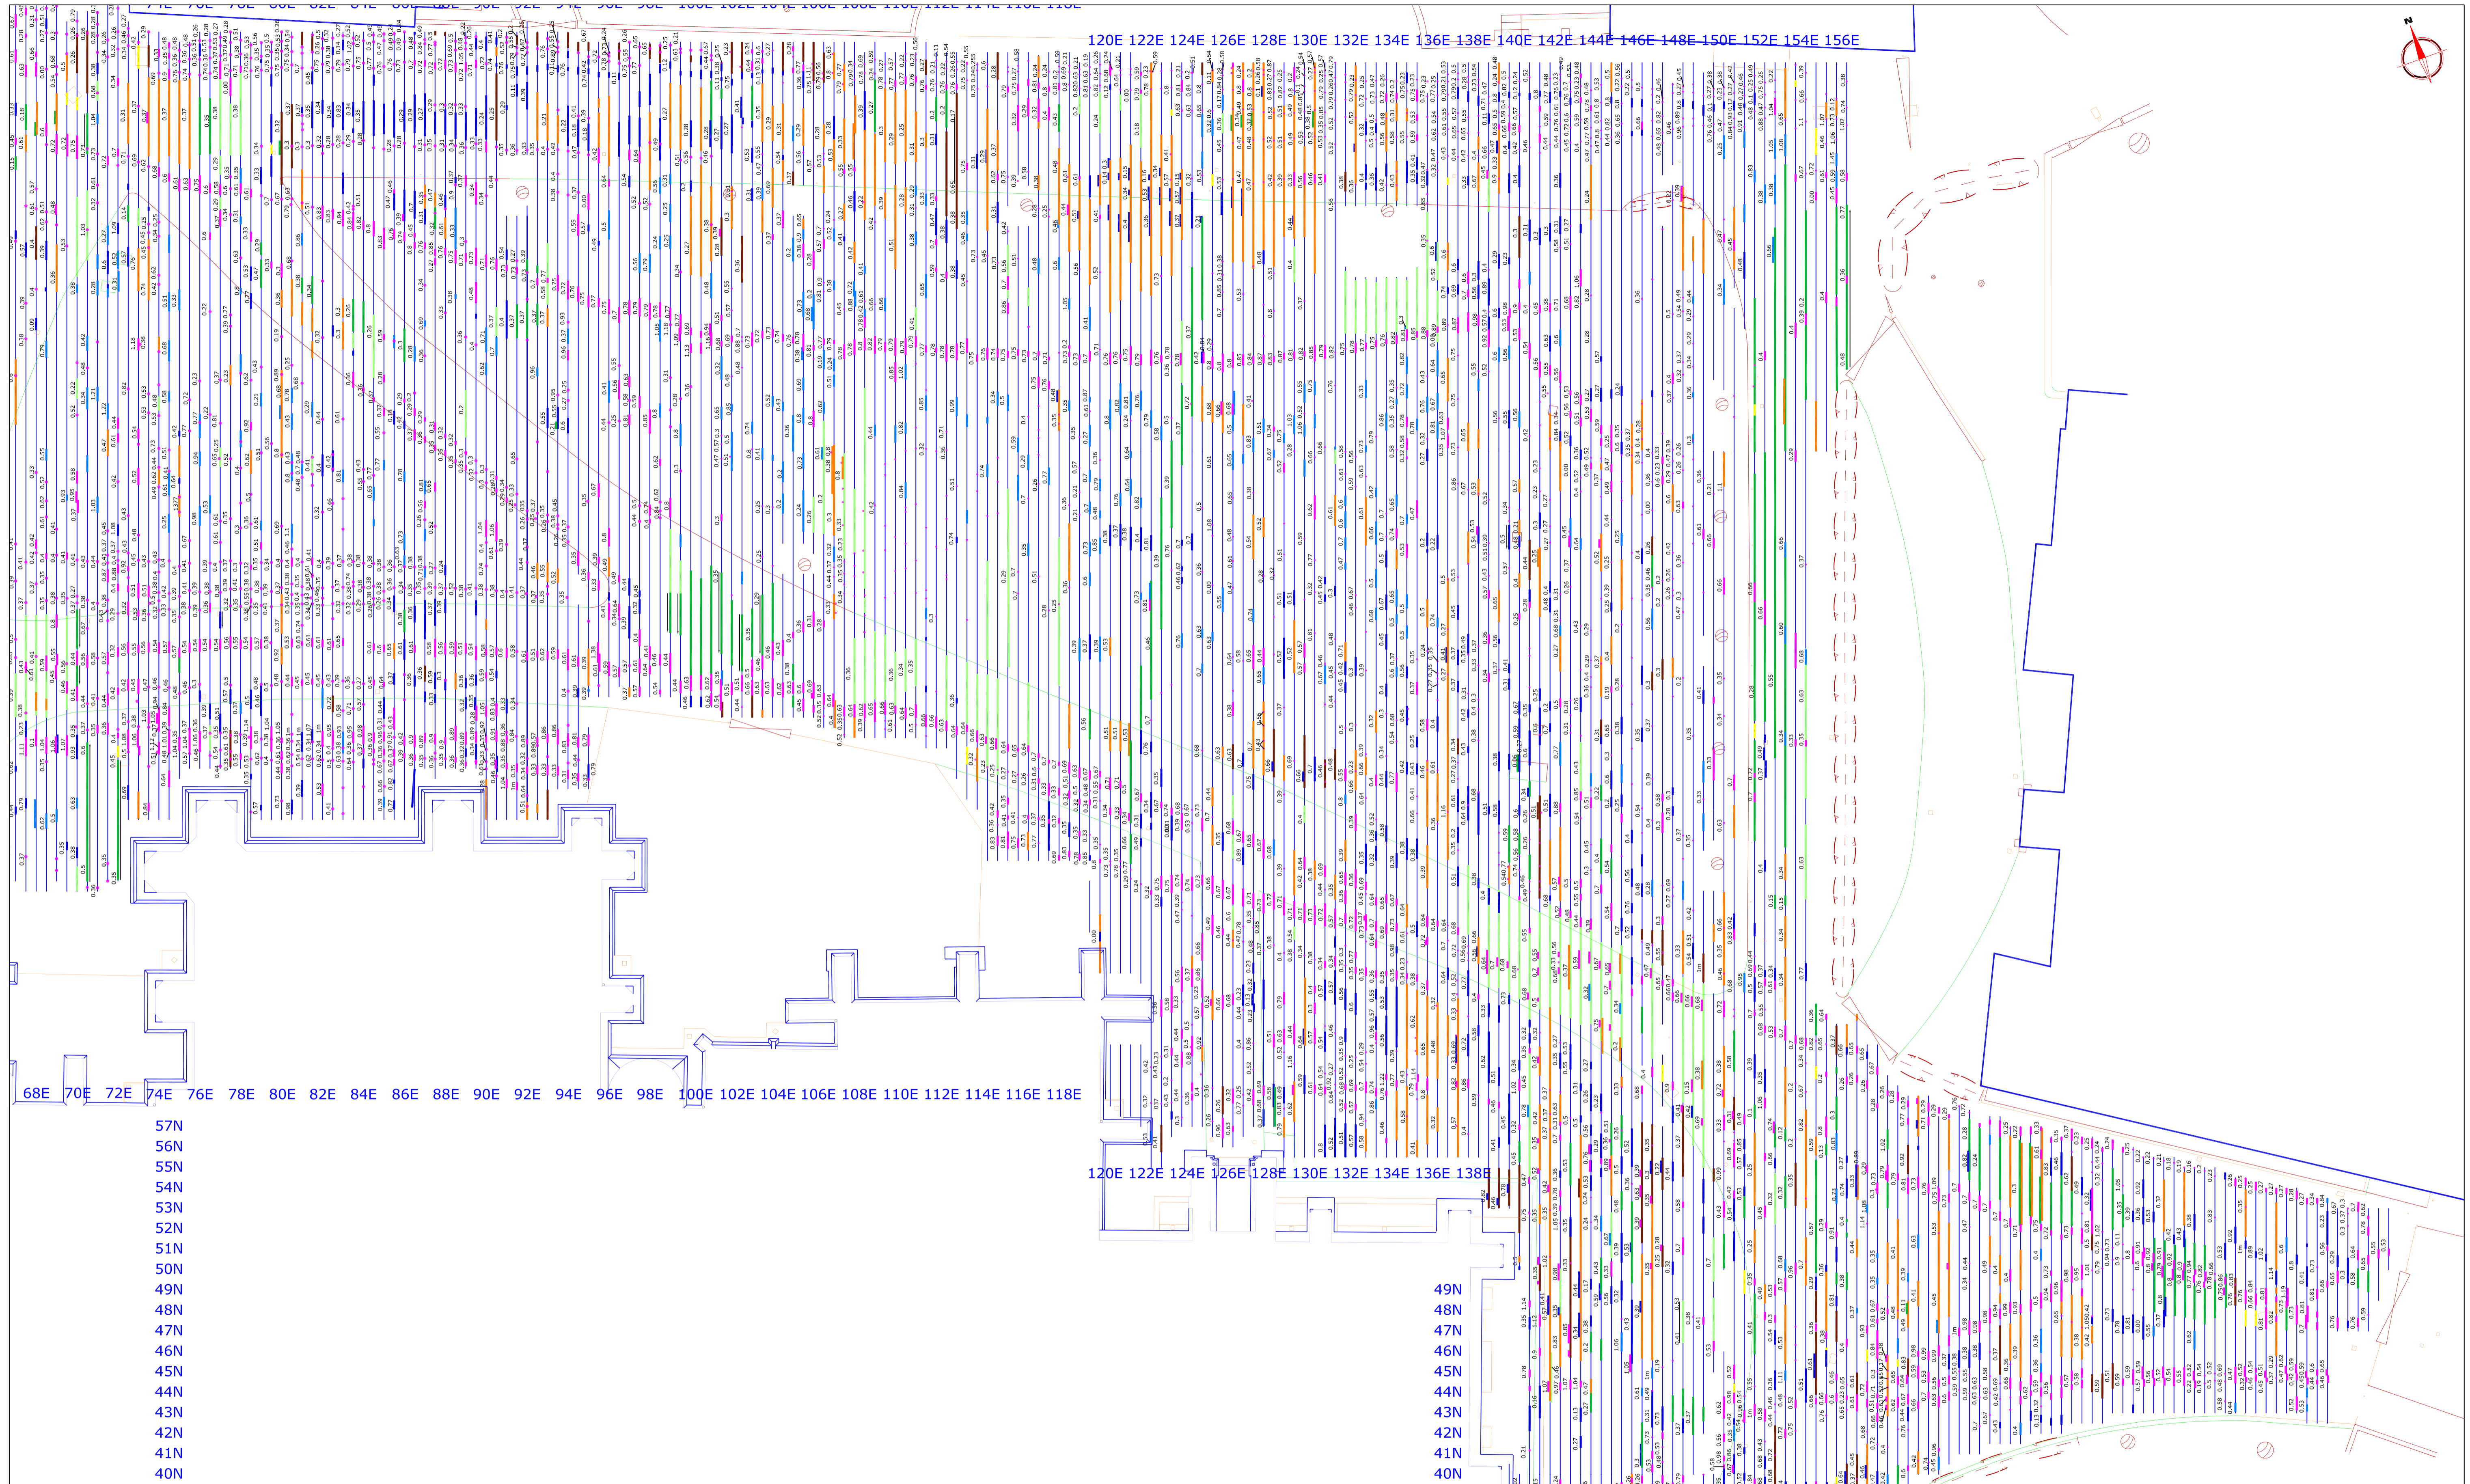

| Amendments |      |             |
|------------|------|-------------|
| Issue No.  | Date | Description |
|            |      |             |
|            |      |             |


| Radar Abstraction                                |                                     |
|--|-------------------------------------|
| <span style="color: blue;">█</span>              | Strong Discrete                     |
| <span style="color: lightblue;">█</span>         | Weak Discrete                       |
| <span style="color: brown;">█</span>             | Strong Complex                      |
| <span style="color: orange;">█</span>            | Weak Complex                        |
| <span style="color: magenta;">●</span>           | Point Diffraction                   |
| <span style="color: pink;">█</span>              | Broad Crested                       |
| <span style="color: green;">█</span>             | Strong Planar                       |
| <span style="color: lightgreen;">█</span>        | Weak Planar                         |
| <span style="background-color: yellow;">█</span> | Conductive Surface                  |
| <span style="color: black;">→</span>             | Inclined Event                      |
| <span style="border: 1px solid black;">█</span>  | 0.25<br>Depth to top of feature (m) |

|                       |   |
|-----------------------|---|
| Client                | HEREFORD CATHEDRAL  |
| Project Title         | HEREFORD CATHEDRAL CLOSE                                  |
| Supported by          | The National Lottery<br>through the Heritage Lottery Fund |
| Heritage Lottery Fund |   |

**STRATASCAN**  
 GEOPHYSICS FOR ARCHAEOLOGY  
 AND ENGINEERING  
 VINEYARD HOUSE  
 UPPER HOOK ROAD  
 UPTON UPON SEVERN  
 UK  
 WR8 0SA  
 T: +44 (0)1684 592266  
 F: +44 (0)1684 594142  
 E: info@stratascan.co.uk  
 www.stratascan.co.uk

|           |                                   |             |          |
|-----------|-----------------------------------|-------------|----------|
| Job No.   | 2118                              | Survey Date | MARCH 06 |
| Subject   | GPR ABSTRACTION 400MHZ NORTH EAST |             |          |
| Scale     | 1:150                             |             |          |
| Plot      | A1                                | Checked by  | PPB      |
| Date      | MAY 06                            | Drawn by    | HH/SH    |
| Issue No. | 01                                | Figure No.  | 06c      |



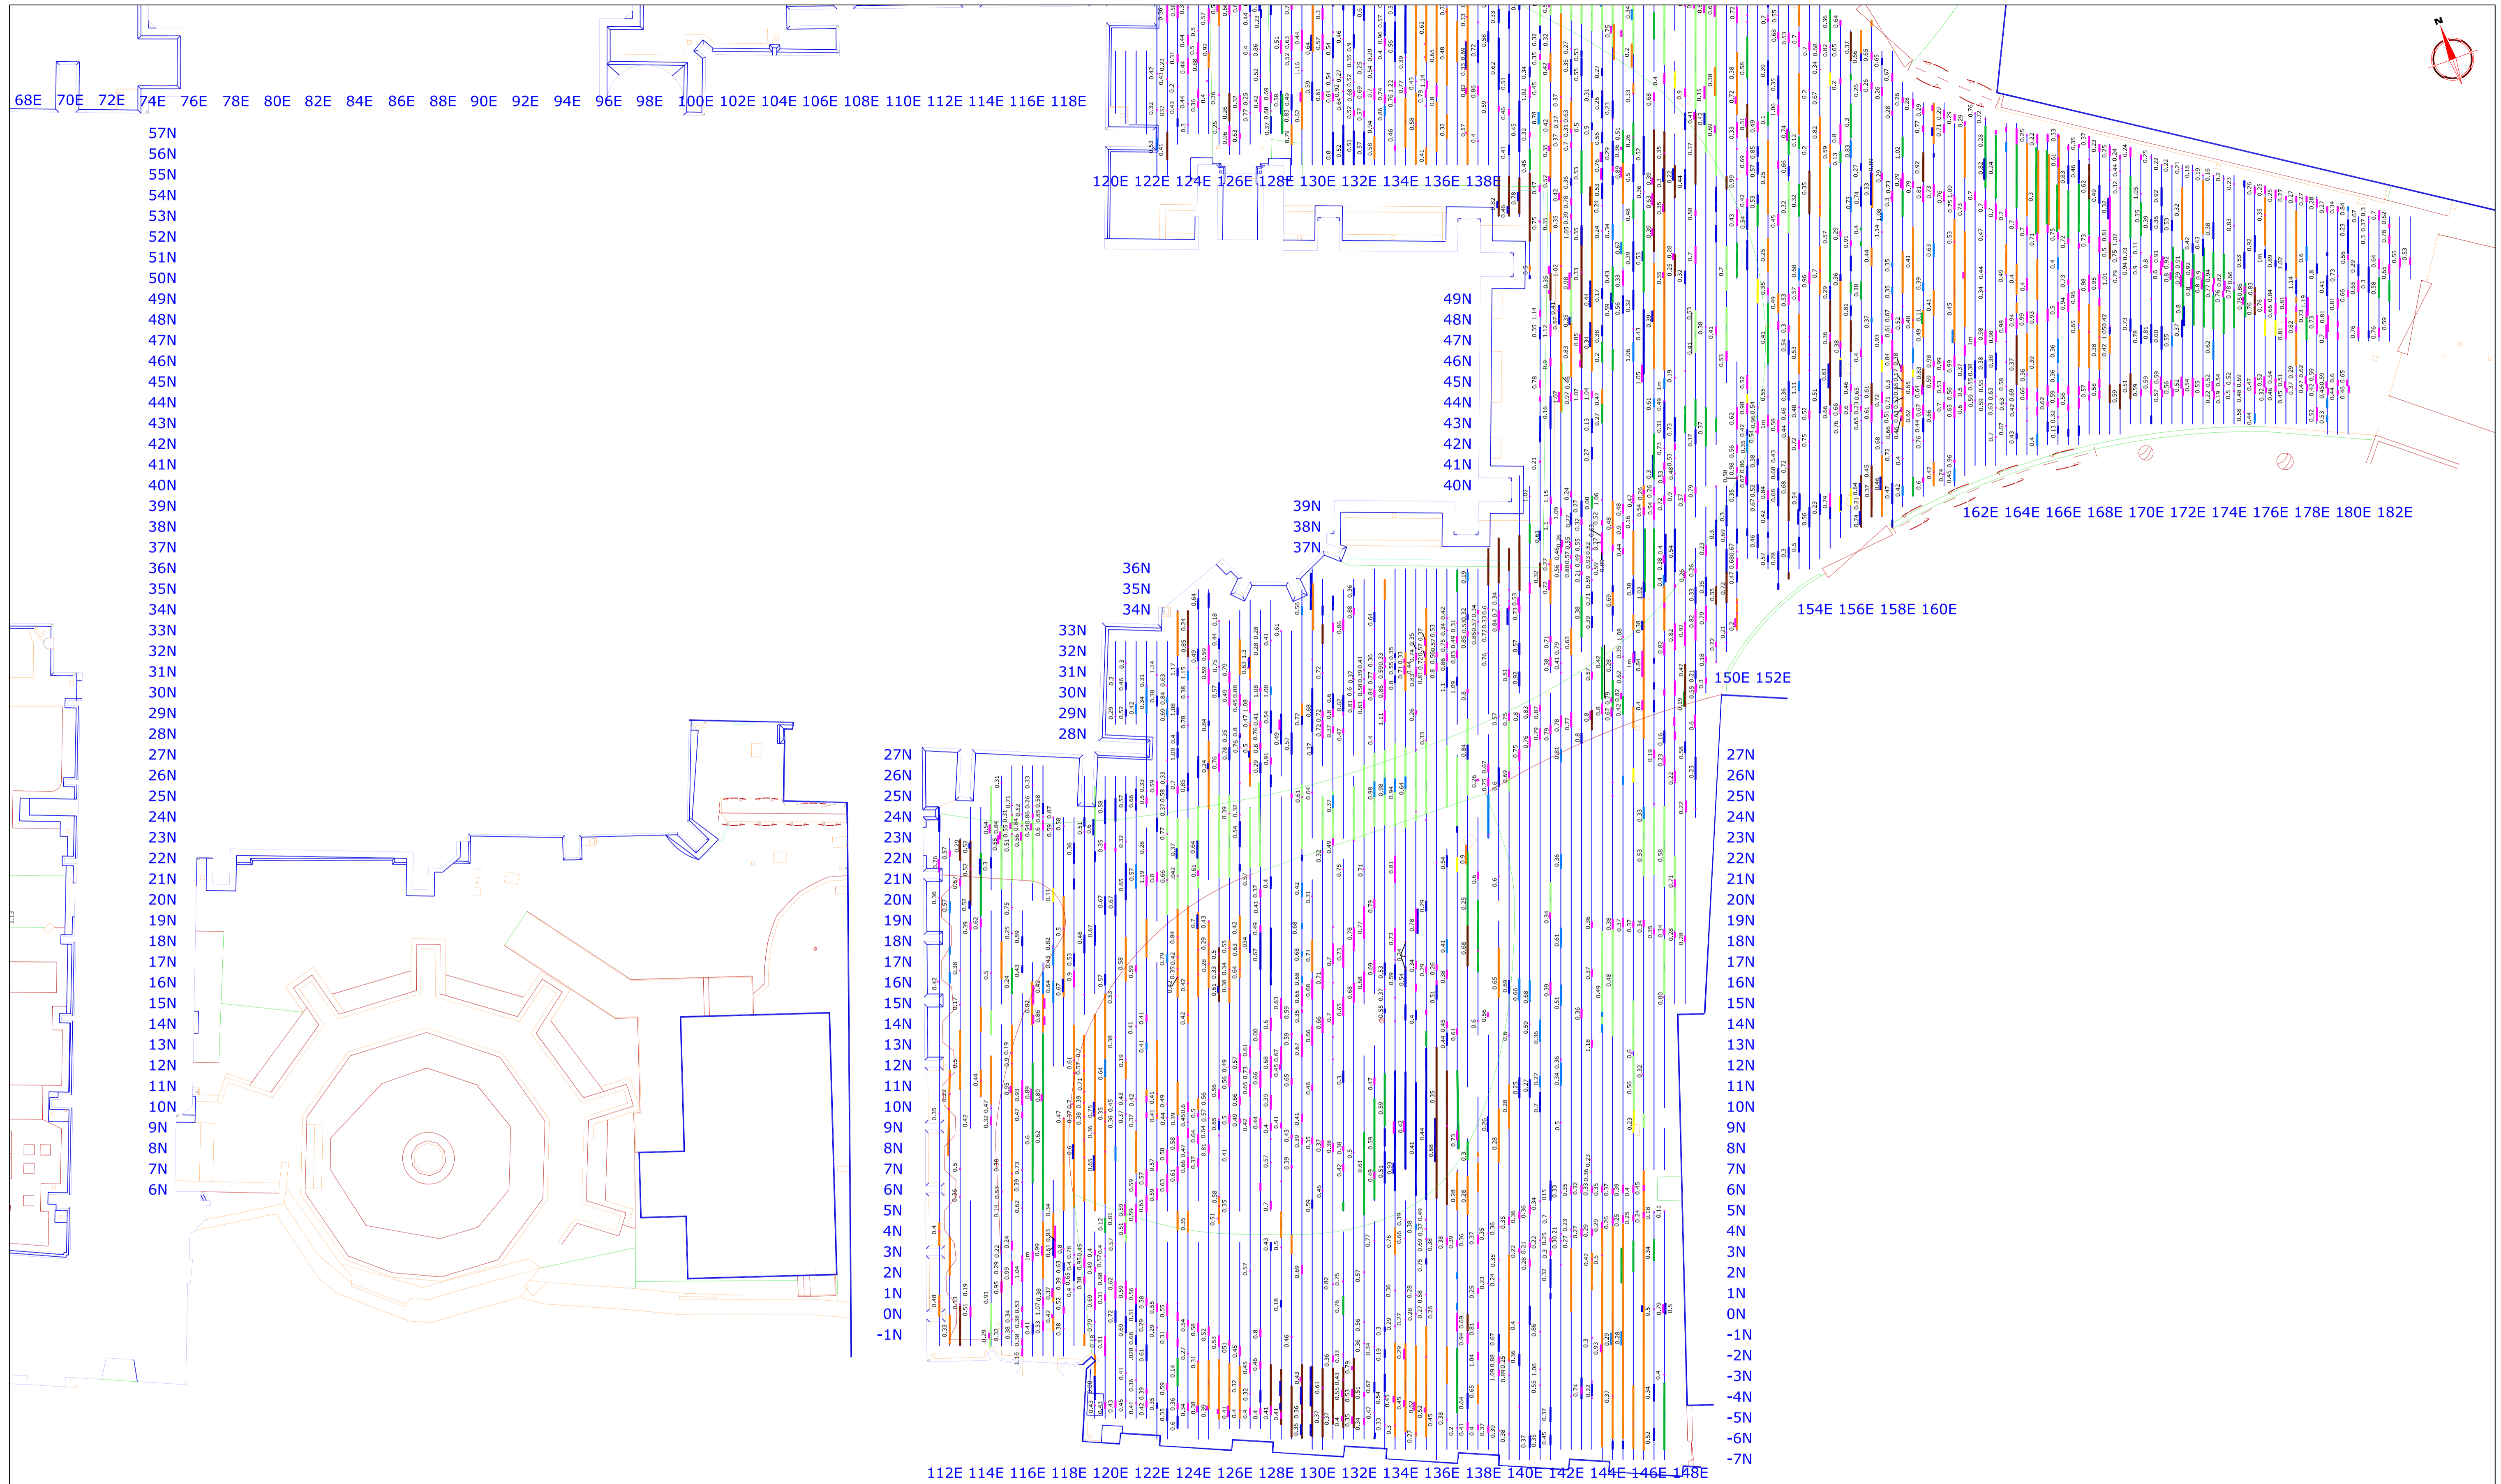

| Amendments |      |             |
|------------|------|-------------|
| Issue No.  | Date | Description |
| -          | -    | -           |


| Radar Abstraction                                |                             |
|--|-----------------------------|
| <span style="color: blue;">█</span>              | Strong Discrete             |
| <span style="color: lightblue;">█</span>         | Weak Discrete               |
| <span style="color: brown;">█</span>             | Strong Complex              |
| <span style="color: orange;">█</span>            | Weak Complex                |
| <span style="color: magenta;">●</span>           | Point Diffraction           |
| <span style="color: green;">█</span>             | Broad Crested               |
| <span style="color: red;">█</span>               | Strong Planar               |
| <span style="color: lightgreen;">█</span>        | Weak Planar                 |
| <span style="background-color: yellow;">█</span> | Conductive Surface          |
| <span style="color: black;">┆</span>             | Inclined Event              |
| <span style="color: black;">┆</span>             | Depth to top of feature (m) |

|               |  |
|---------------|--|
| Client        | HEREFORD CATHEDRAL                                     |
| Project Title | HEREFORD CATHEDRAL CLOSE                               |
| Supported by  | The National Lottery through the Heritage Lottery Fund |
|               |  |

**STRATASCAN**  
 GEOPHYSICS FOR ARCHAEOLOGY  
 AND ENGINEERING  
 VINEYARD HOUSE  
 UPPER HOOK ROAD  
 UPTON UPON SEVERN  
 UK  
 WR8 0SA  
 T: +44 (0)1684 592266  
 F: +44 (0)1684 594142  
 E: info@stratascan.co.uk  
 www.stratascan.co.uk

|         |                                   |             |          |
|---------|-----------------------------------|-------------|----------|
| Job No. | 2118                              | Survey Date | MARCH 06 |
| Subject | GPR ABSTRACTION 400MHZ SOUTH EAST |             |          |
| Scale   | 1:150                             |             |          |
| Plot    | A1                                | Checked by  | PPB      |
| Date    | MAY 06                            | Issue No.   | 01       |
|         |                                   | Figure No.  | 06d      |



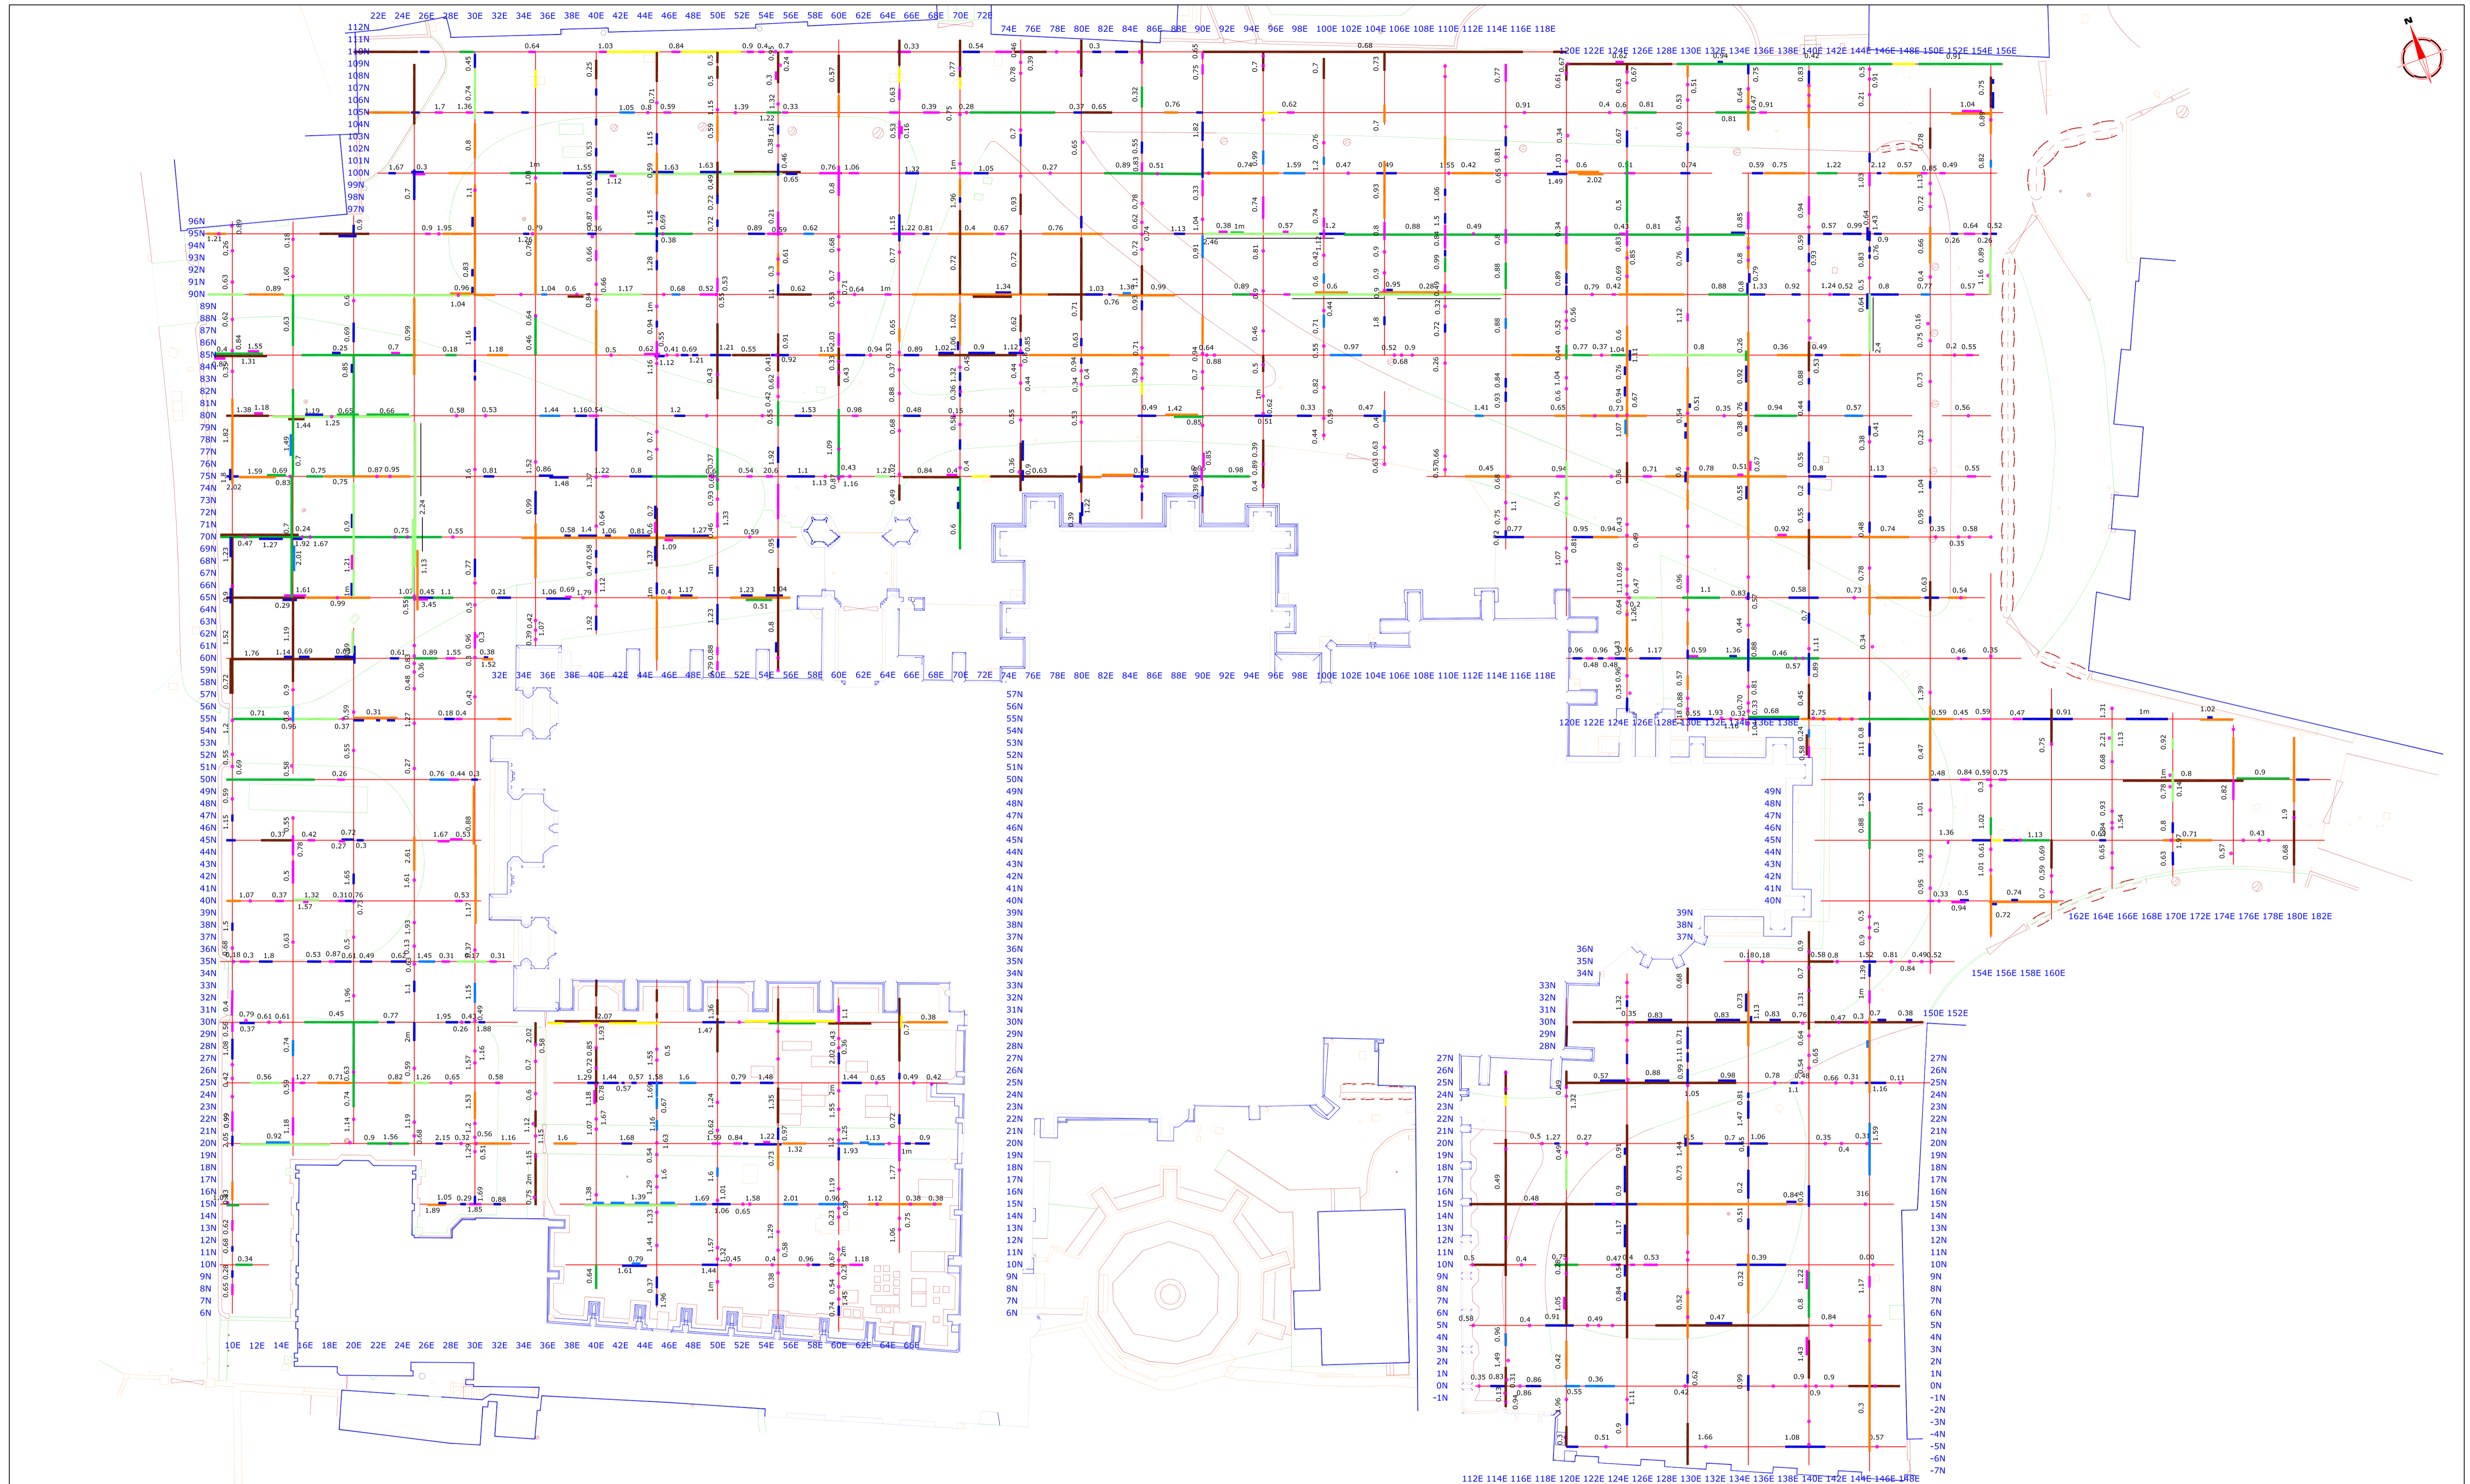

| Amendments |      |             |
|------------|------|-------------|
| Issue No.  | Date | Description |
| -          | -    | -           |


| Radar Abstraction                                |                             |
|--|-----------------------------|
| <span style="color: blue;">█</span>              | Strong Discrete             |
| <span style="color: green;">█</span>             | Weak Discrete               |
| <span style="color: orange;">█</span>            | Strong Complex              |
| <span style="color: red;">█</span>               | Weak Complex                |
| <span style="color: magenta;">●</span>           | Point Diffraction           |
| <span style="color: cyan;">█</span>              | Broad Crested               |
| <span style="color: blue;">█</span>              | Strong Planar               |
| <span style="color: green;">█</span>             | Weak Planar                 |
| <span style="background-color: yellow;">█</span> | Conductive Surface          |
| <span style="color: blue;">→</span>              | Inclined Event              |
| <span style="color: blue;">█</span>              | 0.25                        |
|  | Depth to top of feature (m) |

|                          |  |
|--------------------------|--|
| Client                   |  |
| HEREFORD CATHEDRAL       |  |
| Project Title            |  |
| HEREFORD CATHEDRAL CLOSE |  |
| Supported by             |  |
|                          |  |

**STRATASCAN**  
 GEOPHYSICS FOR ARCHAEOLOGY  
 AND ENGINEERING  
 VINEYARD HOUSE  
 UPPER HOOK ROAD  
 UPTON UPON SEVERN  
 UK  
 WR8 0SA  
 T: +44 (0)1684 592266  
 F: +44 (0)1684 594142  
 E: info@stratascan.co.uk  
 www.stratascan.co.uk

|         |                        |             |          |
|---------|------------------------|-------------|----------|
| Job No. | 2118                   | Survey Date | MARCH 06 |
| Subject | GPR ABSTRACTION 200MHZ |             |          |
| Scale   | 1:250                  |             |          |
| Plot    | A1                     | Checked by  | PPB      |
| Date    | MAY 06                 | Issue No.   | 01       |
|         |                        | Figure No.  | 07       |



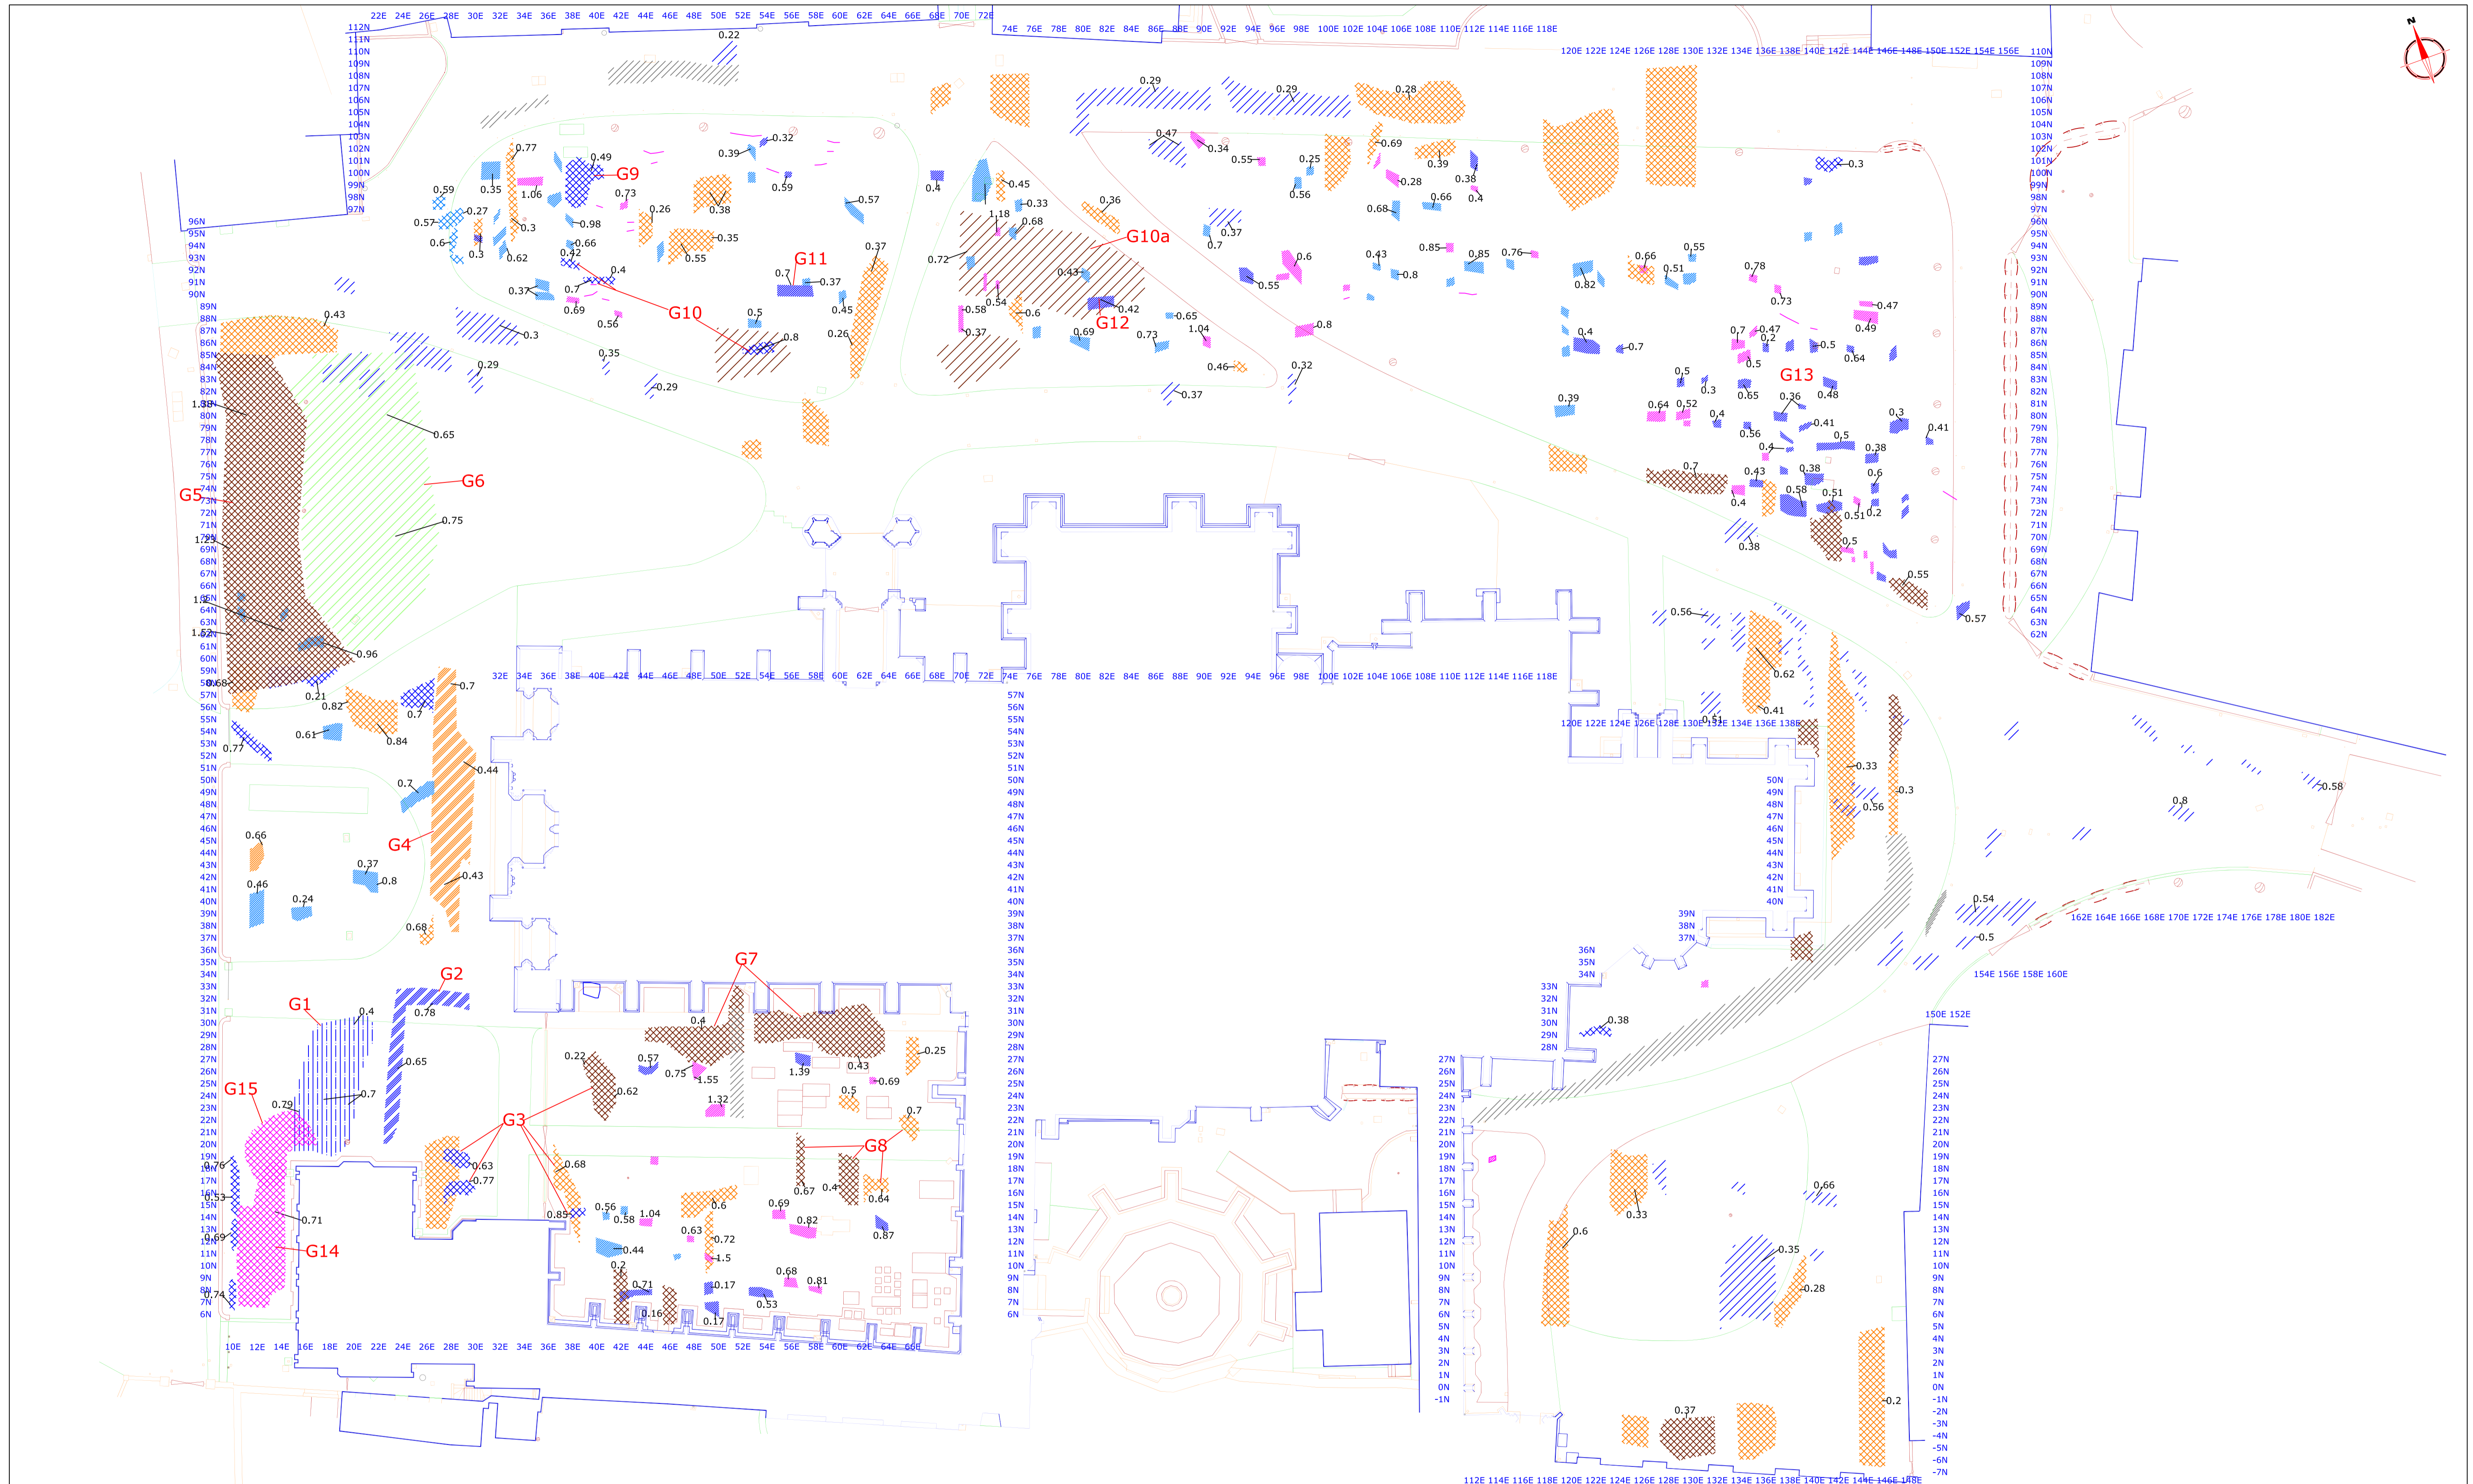

| Amendments |      |             |
|------------|------|-------------|
| Issue No.  | Date | Description |
| -          | -    | -           |

| Radar Interpretation |   |
|----------------------|---|
|                      | Discrete and complex responses relating to the music hall   |
|                      | Weak complex and planar responses relating to the original cathedral frontage                             |
|                      | Strong discrete responses probably relating to the Saxon road   |
|                      | Discrete area of high energy response identified with the tmslice data - possibly relating to mass graves |
|                      | Strong complex anomalies - possible structural remains and debris   |
|                      | Weak complex area anomaly - area of ground disturbance and/or structural debris                           |
|                      | Strong discrete area anomaly - possible structural remains or debris                                      |
|                      | Weak discrete area anomaly - ground disturbance of possible modern origin                                 |
|                      | Strong discrete anomaly - ground disturbance or structural debris of possible modern origin               |
|                      | Strong discrete anomaly - possibly relating to burials  |
|                      | Weak discrete anomaly - possibly relating to burials  |
|                      | Broad crested anomaly - possibly relating to burials  |
|                      | Area of planar response - possibly related to landscaping and demolition activities                       |
|                      | Complex anomalies identified within the 200MHz radar - possible area of ground disturbance at depth       |
|                      | Possible service trench   |
|                      | Linear anomaly or possible archaeological origin  |


|      |                             |
|------|-----------------------------|
| 0.25 | Depth to top of feature (m) |
| G1   | Anomaly number              |

|               |  |
|---------------|--|
| Client        | HEREFORD CATHEDRAL                                     |
| Project Title | HEREFORD CATHEDRAL CLOSE                               |
| Supported by  | The National Lottery through the Heritage Lottery Fund |
|               |  |

**STRATASCAN**  
 GEOPHYSICS FOR ARCHAEOLOGY  
 AND ENGINEERING  
 VINEYARD HOUSE  
 UPPER HOOK ROAD  
 UPTON UPON SEVERN  
 UK  
 WR8 0SA  
 T: +44 (0)1684 592266  
 F: +44 (0)1684 594142  
 E: info@stratascan.co.uk  
 www.stratascan.co.uk

|         |                    |             |          |
|---------|--------------------|-------------|----------|
| Job No. | 2118               | Survey Date | MARCH 06 |
| Subject | GPR INTERPRETATION |             |          |
| Scale   | 1:250              |             |          |
| Plot    | A1                 | Checked by  | PPB      |
| Date    | MAY 06             | Issue No.   | 01       |
|         | Drawn by           | Figure No.  | 08       |



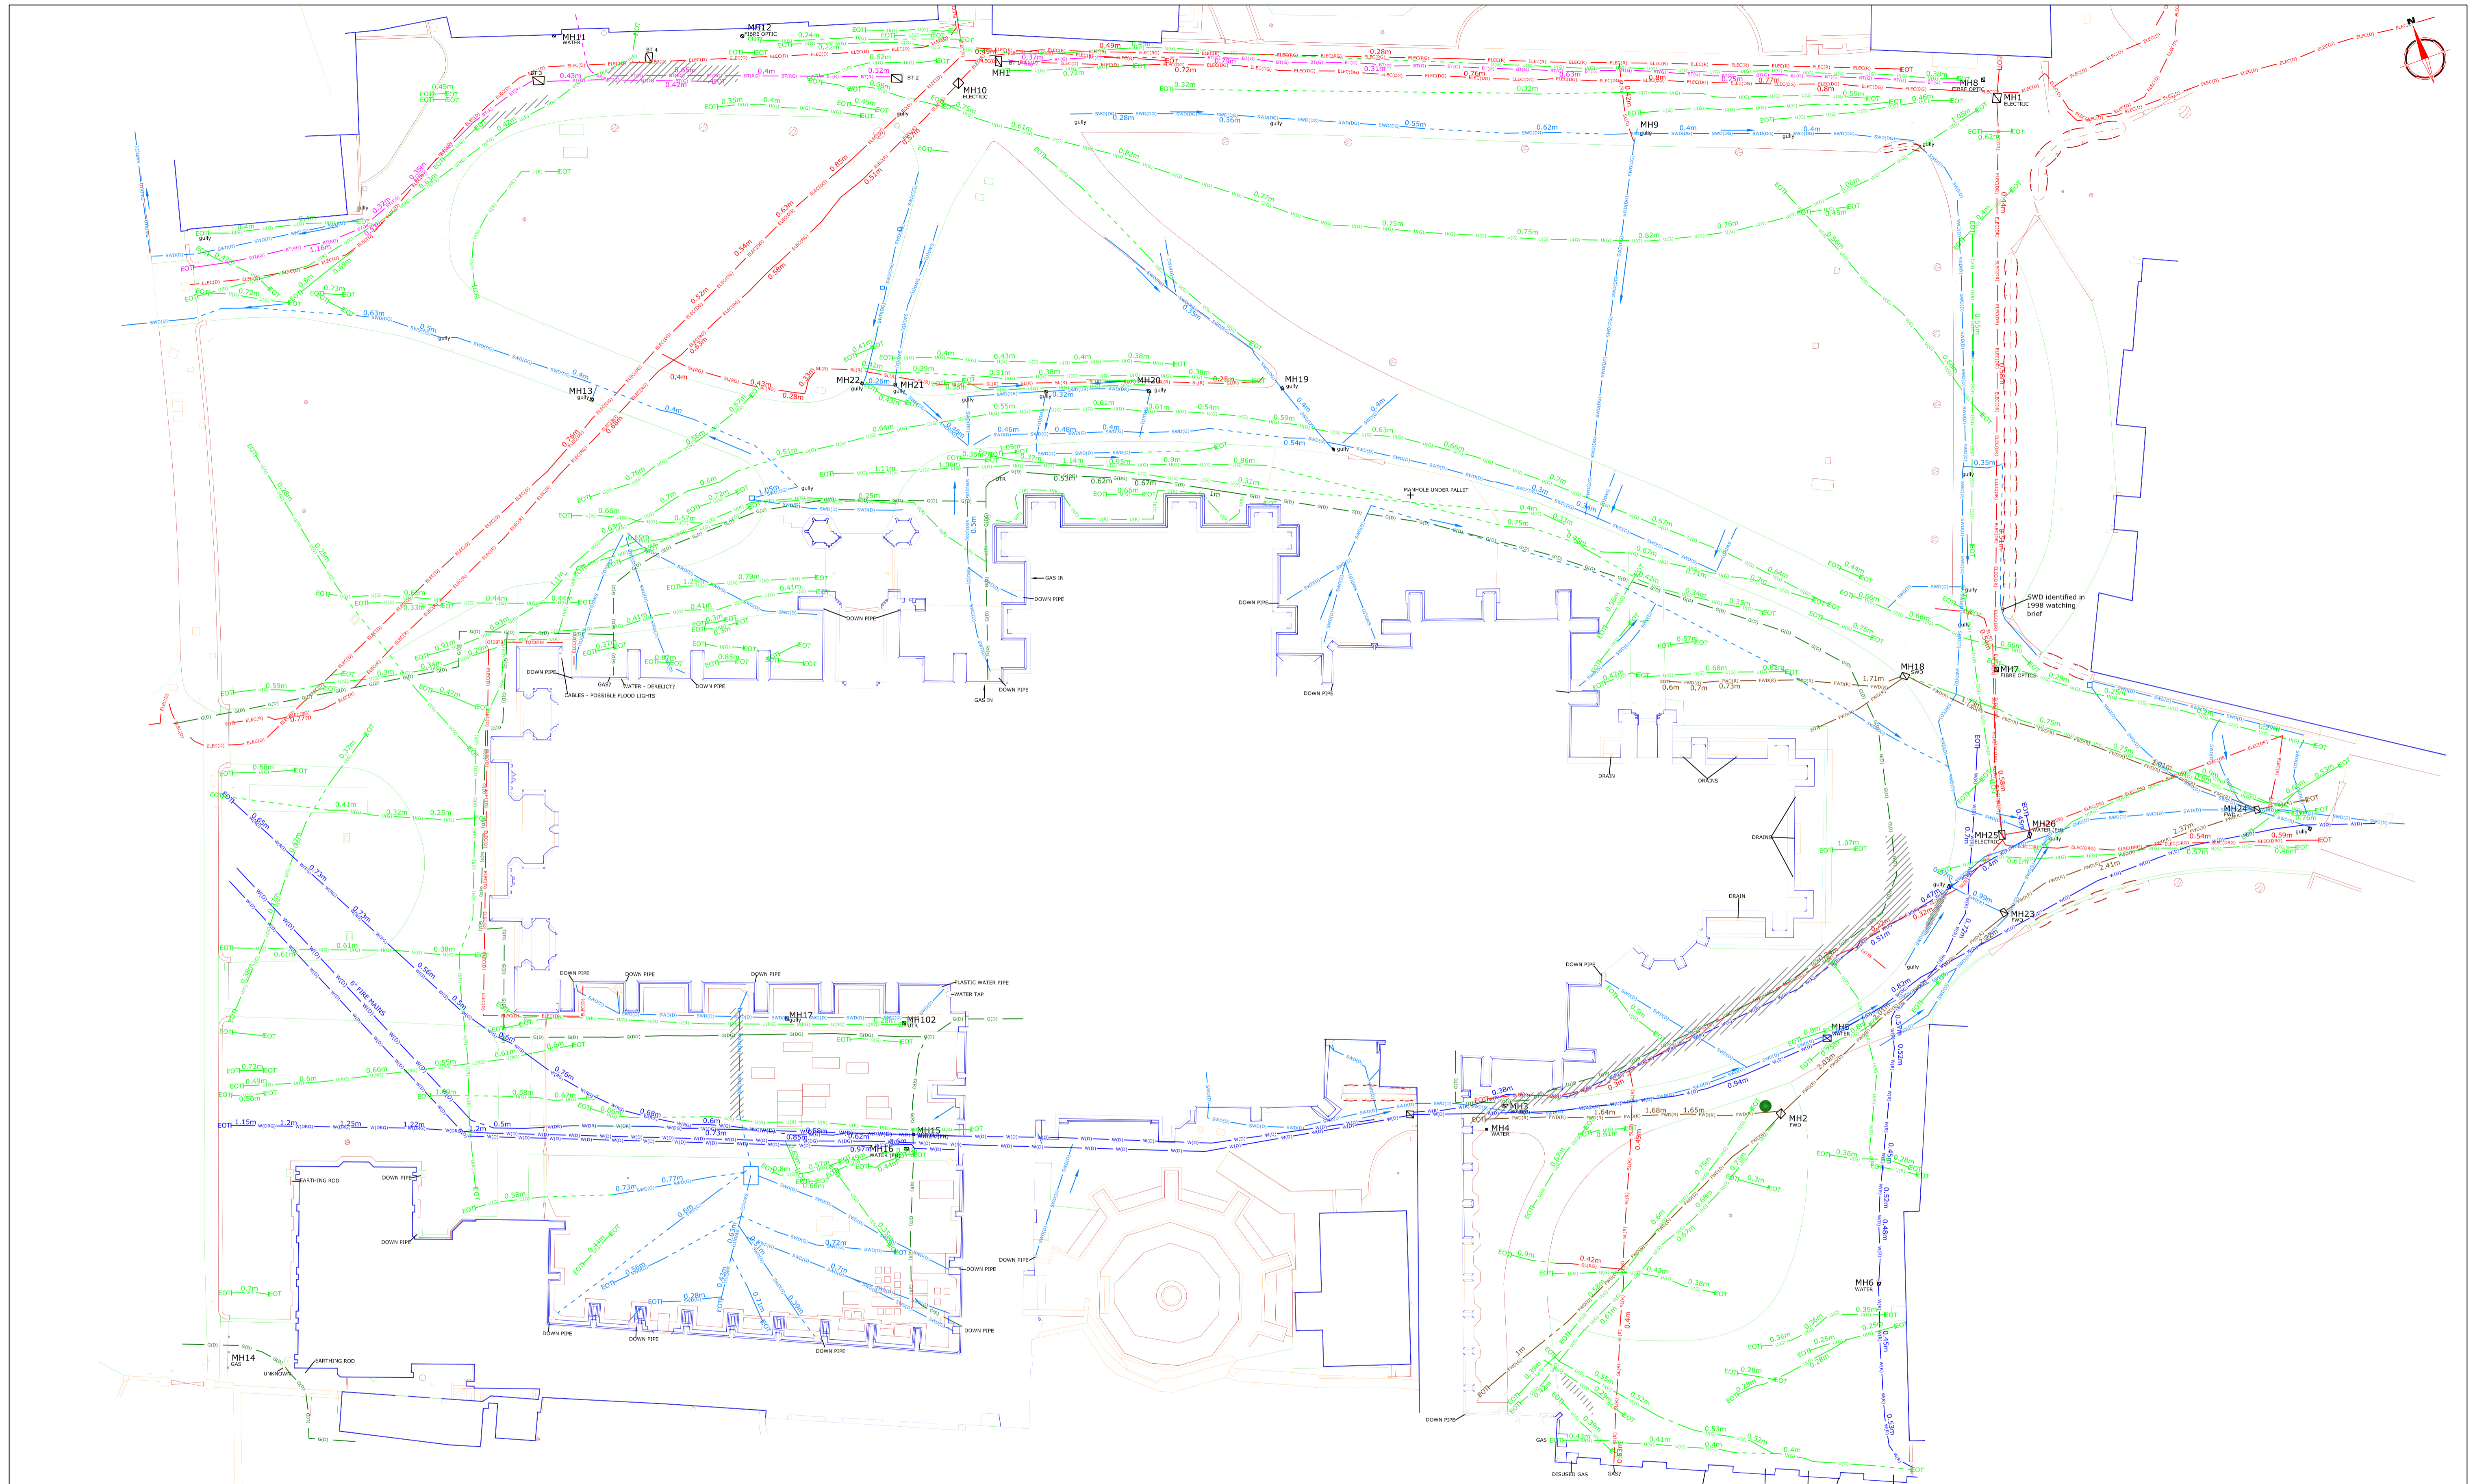

| Amendments |      |             |
|------------|------|-------------|
| Issue No.  | Date | Description |
| -          | -    | -           |

**Utility mapping information**  
 SWD within the Lady Arbour suggests the conversion point at stone marker, this differs from that stated by the record drawing.

**N.B.**  
 THE UTILITY SURVEY INFORMATION ON THIS PLAN HAS BEEN PRODUCED USING GPR AND ELECTRO-MAGNETIC LOCATING TECHNIQUES. ALTHOUGH BEING THE MOST ACCURATE AVAILABLE, SIGNALS ARE SUSCEPTIBLE TO DISTORTION ON THE SURFACE ESPECIALLY IN CONGESTED AREAS. THERE MAY ALSO BE NON-METALLIC SERVICES AND METALLIC SERVICES PRODUCING INSUFFICIENT SIGNALS FOR ACCURATE LOCATION USING ELECTRO-MAGNETIC TECHNIQUES. WHILST GPR SHOULD DETECT BOTH METALLIC AND NON-METALLIC SERVICES, INDIVIDUAL SERVICES WITHIN CONGESTED AND COMPLEX AREAS MAY BE OBTUSCURED. WHILST EVERY EFFORT HAS BEEN MADE TO PRODUCE AN ACCURATE PLAN OF THE BURIED SERVICES WITHIN THE SURVEY AREA, CRUCIAL DIMENSIONS AND DEPTHS SHOULD BE CHECKED. EXTREME CAUTION SHOULD BE TAKEN WHEN ANY EXCAVATION IS UNDERTAKEN - THE INFORMATION CONTAINED WITHIN THIS PLAN MAY NOT REPRESENT THE TOTAL NUMBER OF SERVICES CONTAINED WITHIN THE SURVEY AREA. HEALTH AND SAFETY GUIDELINES SHOULD BE FOLLOWED PRIOR TO EXCAVATION.

A number of intrusive investigations may be needed to identify and confirm the positions of services found within the GPR survey.

A number of services have been identified under the path in the Lady Arbour and have been attributed to water services. The 6" fire mains cannot be identified along the route of the drawing records running out of the Lady Arbour and may have been placed within existing service trench.

Two electric services have been identified running across the northwest of the Cathedral Close. The GPR service corresponds to that of the record drawings, whilst a parallel service has been identified through radiodetection (intermittent evidence of this service can be seen within the GPR).

| DATA SOURCE              | MATERIAL TYPE                     |
|--------------------------|-----------------------------------|
| D RECORD DRAWING         | ST STEEL                          |
| R RADIO DETECTION        | DI DUCTILE IRON                   |
| G GPR                    | CON CONCRETE                      |
| E EM DATA                | PE POLYETHYLENE                   |
| S SCAR                   | VC VITRIFIED CLAY                 |
| M MANHOLE/VALVE POSITION | DU DUCTS (P) PLASTIC DUCT         |
|                          | DU DUCTS (VC) VITRIFIED CLAY DUCT |

| INTERPRETED LINE INFORMATION (EXAMPLE)      |                |
|---|----------------|
| Data sources used in interpretation of line | Utility type   |
|   |                |
| Estimated depth of cover (m)                | Material       |
|   |                |
|   | Diameter (mm)* |

\* Where Known

| KEY                         |  |
|-----------------------------|--|
| LINETYPES AND ABBREVIATIONS |  |
|                             | BT TELECOMMUNICATIONS (BT)               |
|                             | CATV TELECOMMUNICATIONS (CATV)           |
|                             | FO TELECOMMUNICATIONS (FIBRE OPTIC)      |
|                             | G GAS                                    |
|                             | HV HIGH VOLTAGE ELECTRIC                 |
|                             | LV LOW VOLTAGE ELECTRIC                  |
|                             | W WATER                                  |
|                             | FH FIRE HYDRANT                          |
|                             | SWD SURFACE WATER DRAINAGE               |
|                             | SWD SURFACE WATER DRAINAGE (PRIVATE)     |
|                             | FWD FOUL SEWER                           |
|                             | FWD FOUL SEWER (PRIVATE)                 |
|                             | CS COMBINED SEWER                        |
|                             | CSW COMBINED SEWER (PRIVATE)             |
|                             | CSW FOUL SEWER (RISING MAIN)             |
|                             | DU DUCT (UNOCCUPIED)                     |
|                             | U UNKNOWN                                |
|                             | GPR SURVEY EXTENT                        |
|                             | POSSIBLE SERVICE TRENCH                  |
|                             | DIRECTION OF FLOW                        |
|                             | END OF TRACE                             |
|                             | UNABLE TO RAISE                          |
|                             | RODDING EYE/ INSPECTION CHAMBER/ MANHOLE |

Client  
**HEREFORD CATHEDRAL**

Project Title  
**HEREFORD CATHEDRAL CLOSE**


Supported by  
 through the Heritage Lottery Fund

**STRATASCAN**  
 GEOPHYSICS FOR ARCHAEOLOGY  
 AND ENGINEERING  
 VINEYARD HOUSE  
 UPPER UPON ROAD  
 UPTON UPON SEVERN  
 UK  
 WR8 0SA  
 T: +44 (0)1684 592266  
 F: +44 (0)1684 594142  
 E: info@stratascan.co.uk  
 www.stratascan.co.uk


REGISTERED ORGANISATION

|         |   |             |               |
|---------|---|-------------|---------------|
| Job No. | 2118                                    | Survey Date | MARCH 06      |
| Subject | UTILITY MAPPING<br>FINAL INTERPRETATION |             |               |
| Scale   | 1:250                                   |             |               |
| Plot    | A1                                      | Checked by  | PPB           |
| Date    | MAY 06                                  | Issue No.   | 01            |
|         | Drawn by                                | HH          | Figure No. 09 |



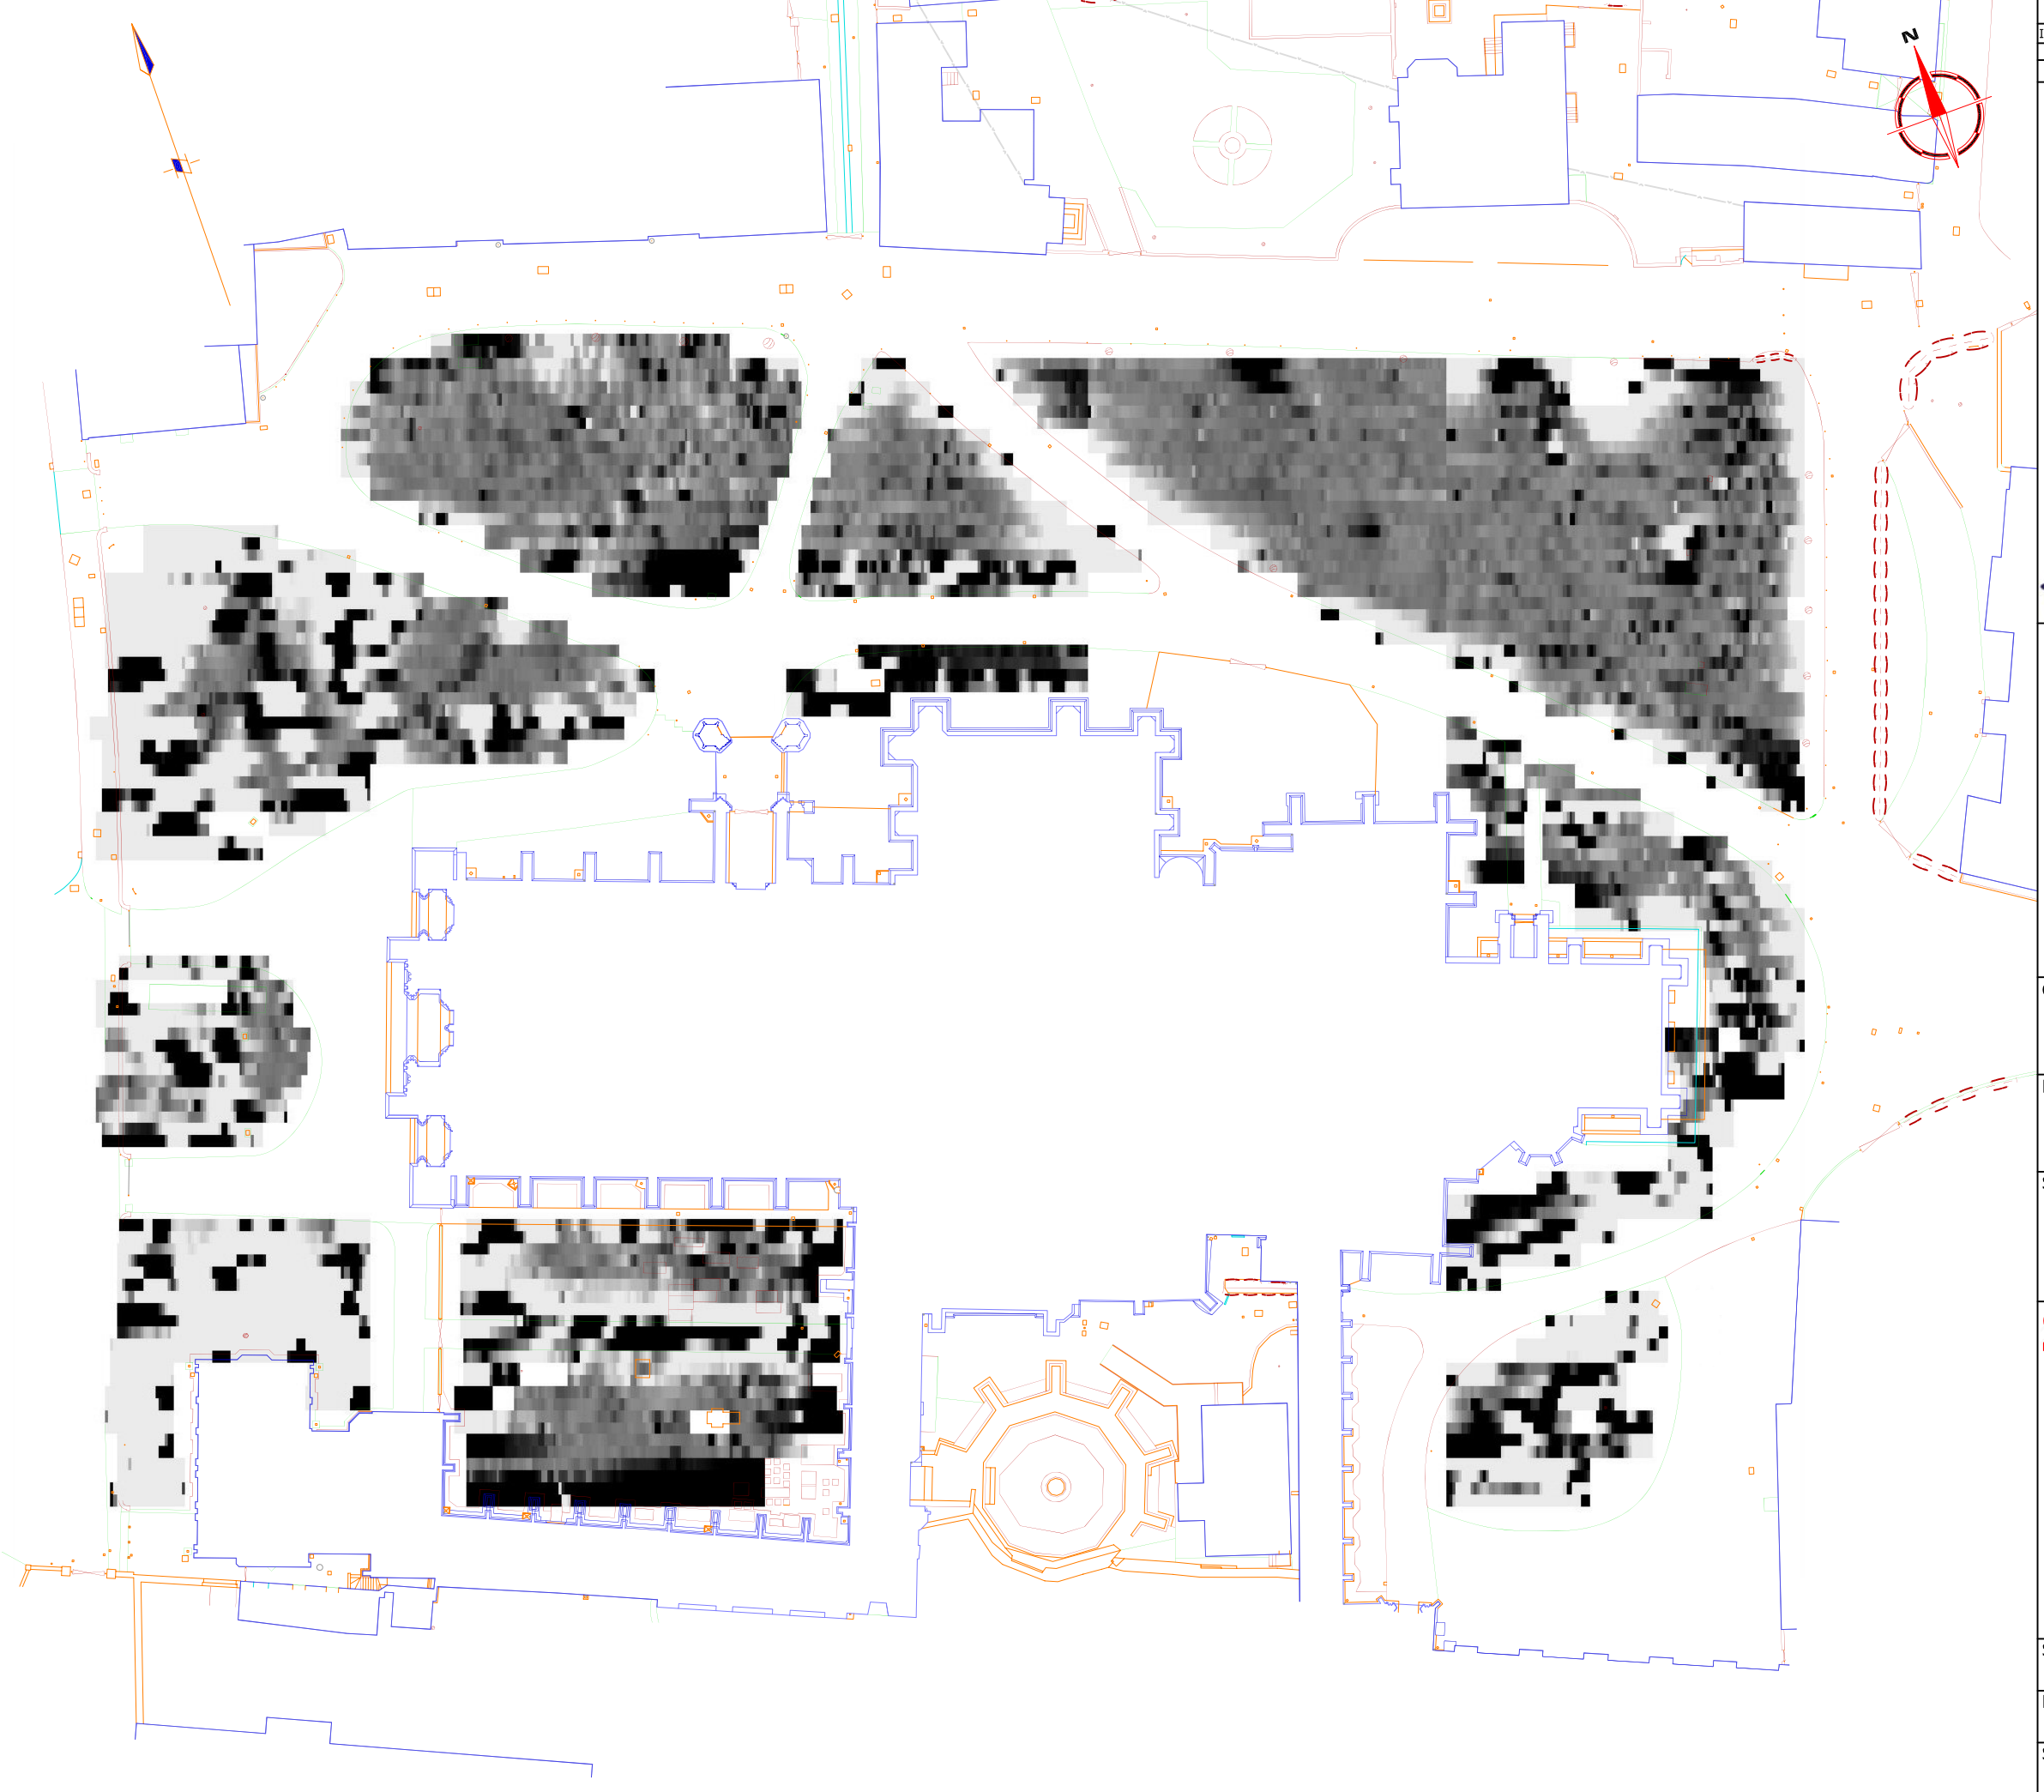

| Amendments |      |             |
|------------|------|-------------|
| Issue No.  | Date | Description |
| -          | -    | -           |
| -          | -    | -           |

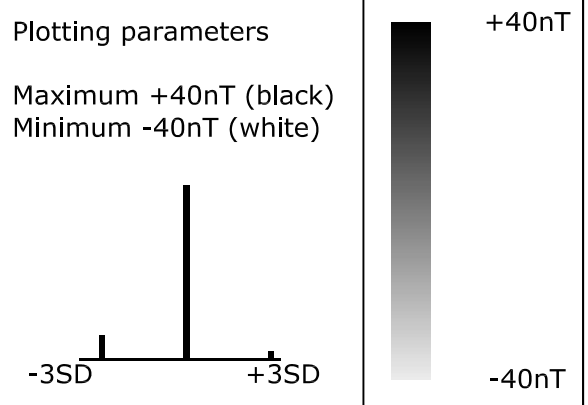

Client  
**HEREFORD CATHEDRAL**

Project Title Job No. 2118  
**GEOPHYSICAL SURVEY -  
HEREFORD CATHEDRAL CLOSE**

Subject  
**PLOT OF RAW GRADIOMETER DATA**

**STRATASCAN™**  
GEOPHYSICS FOR ARCHAEOLOGY  
AND ENGINEERING  
VINEYARD HOUSE  
UPPER HOOK ROAD  
UPTON UPON SEVERN  
UK  
WR8 0SA  
T: +44 (0)1684 592266  
F: +44 (0)1684 594142  
E: info@stratascan.co.uk  
www.stratascan.co.uk


Scale **1:500**  
0m 5 10 15 20 25m

|                              |                          |                         |
|------------------------------|--------------------------|-------------------------|
| Plot<br><b>A3</b>            | Checked by<br><b>SAS</b> | Issue No.<br><b>01</b>  |
| Survey date<br><b>MAY 06</b> | Drawn by<br><b>HH</b>    | Figure No.<br><b>10</b> |








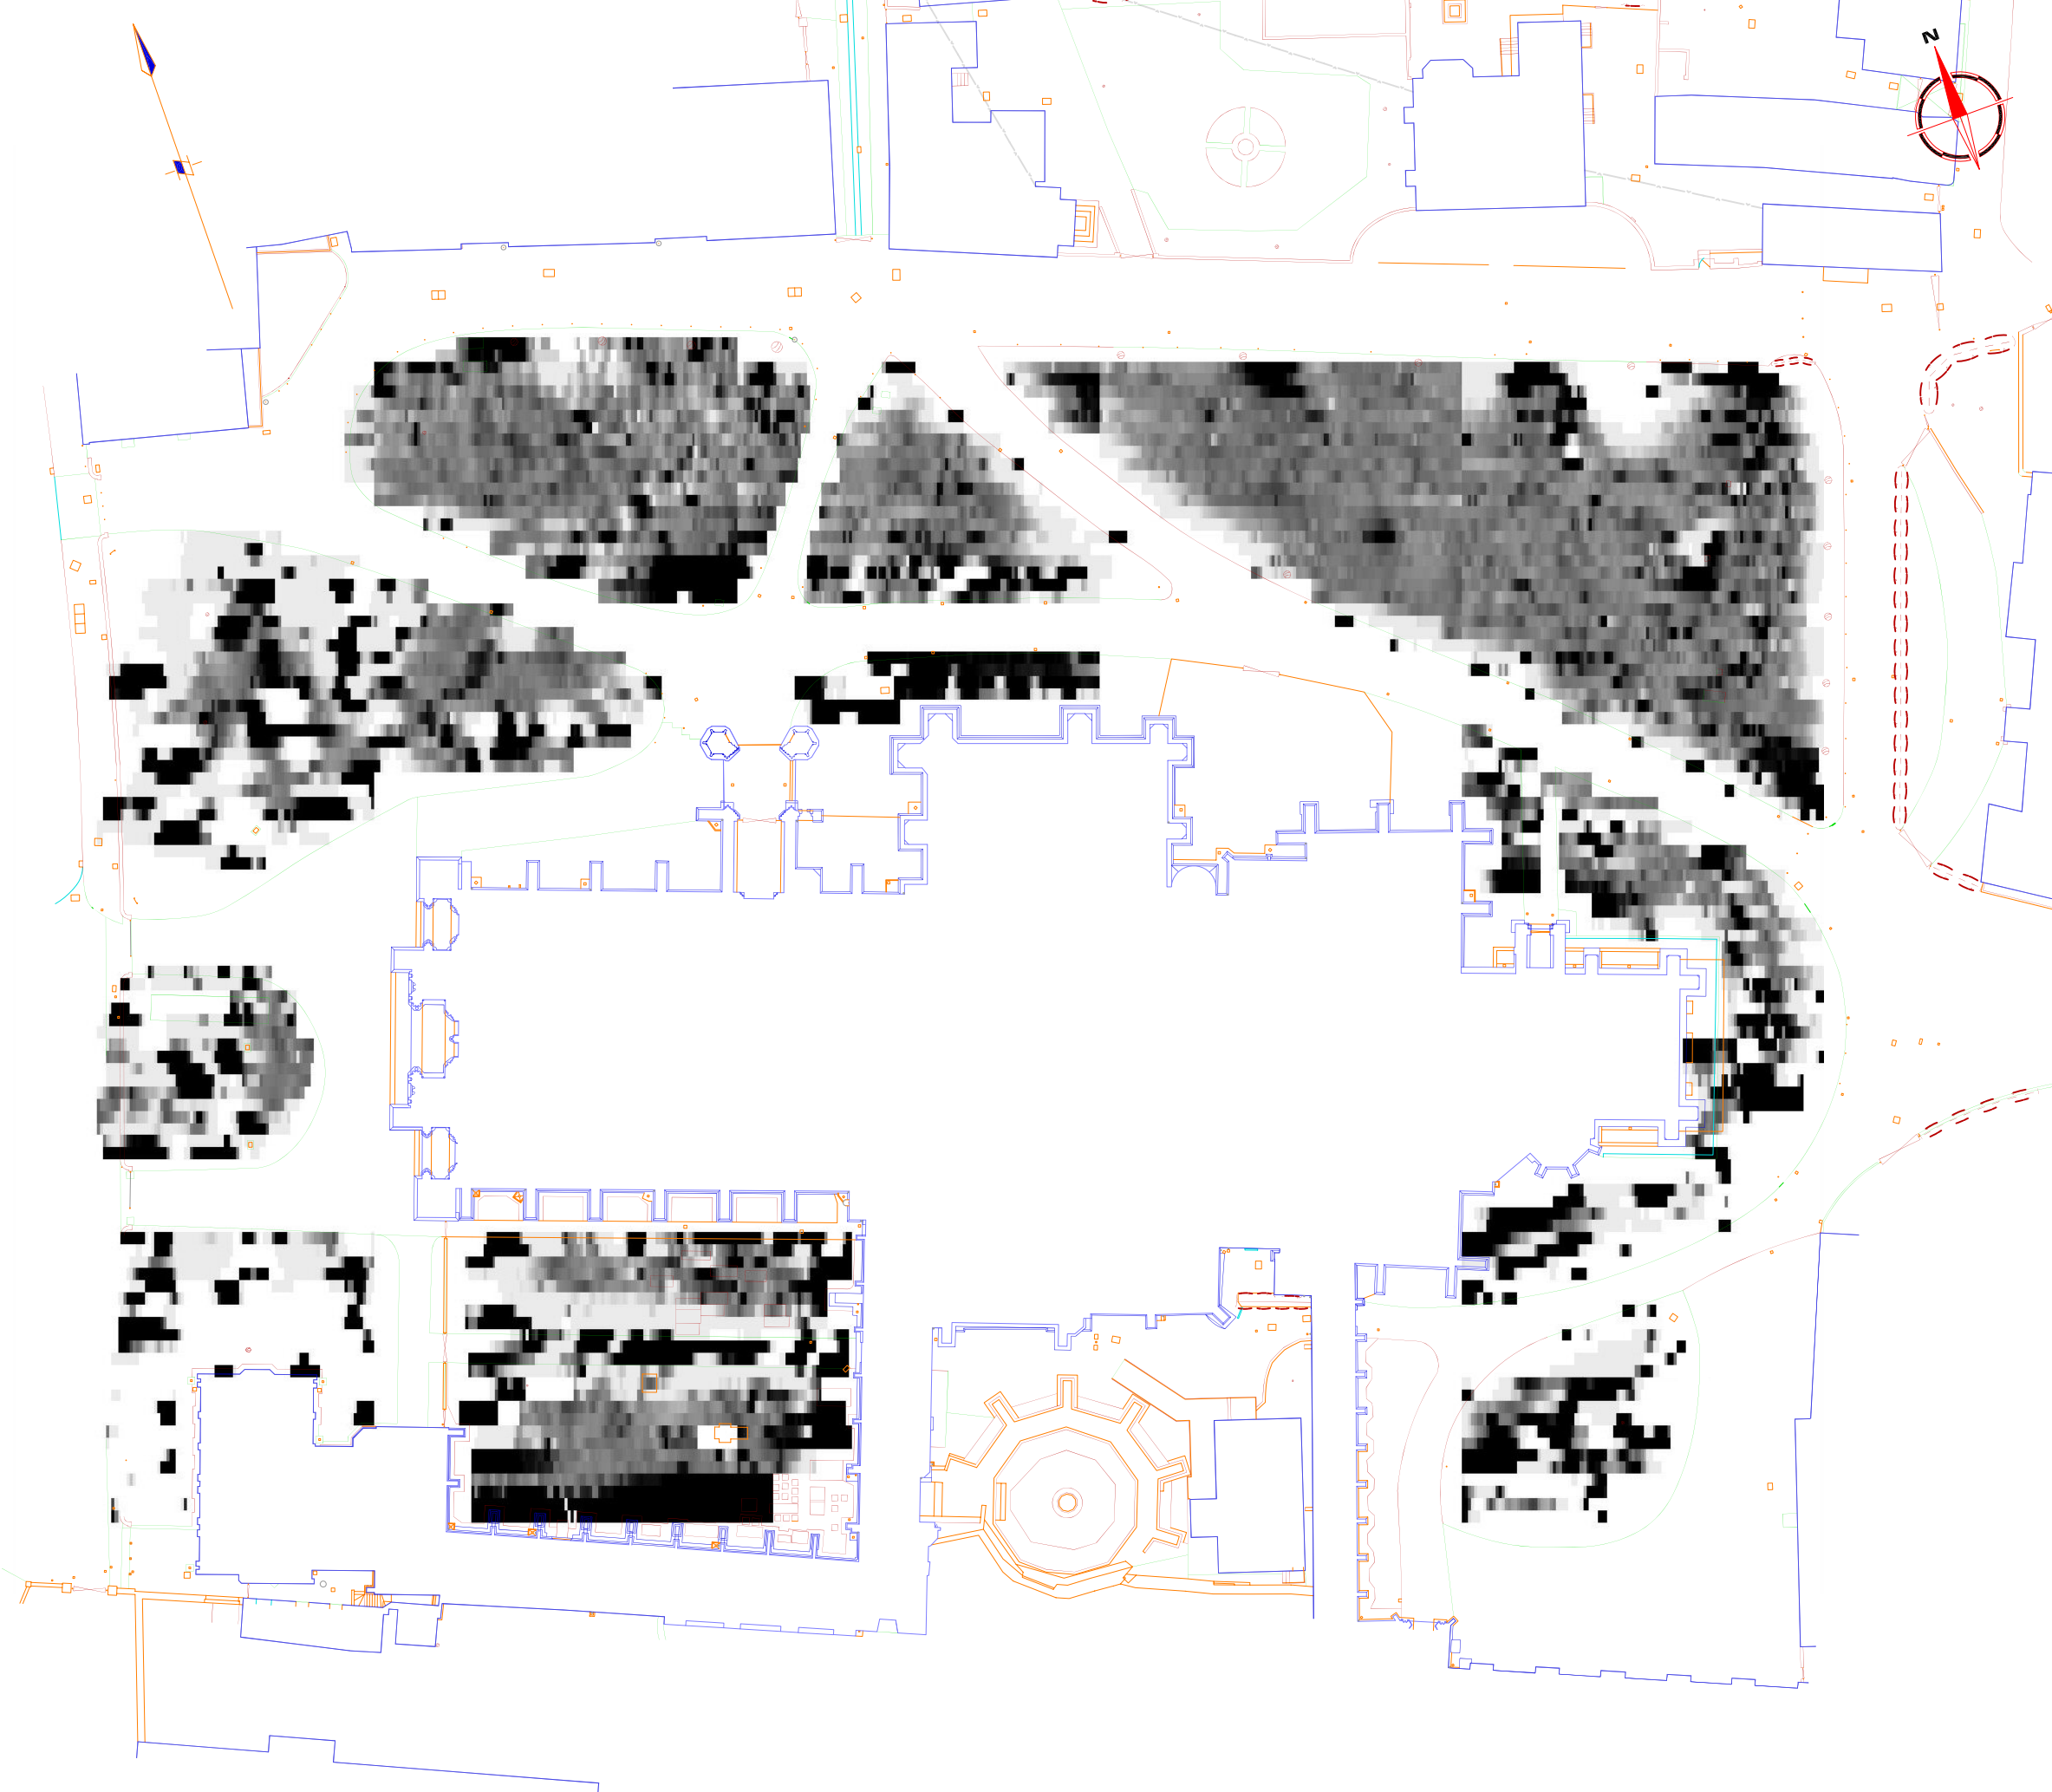

| Amendments |      |             |
|------------|------|-------------|
| Issue No.  | Date | Description |
| -          | -    | -           |

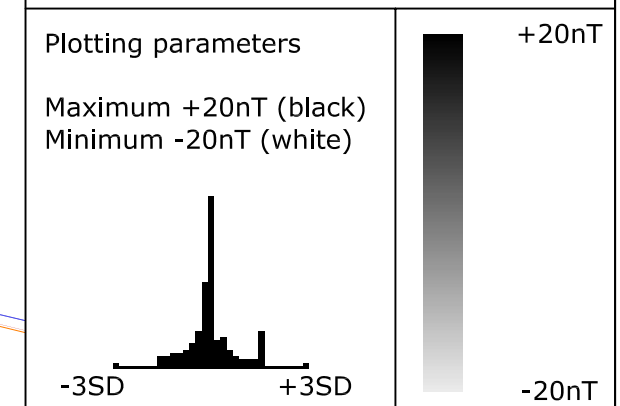

Client  
**HEREFORD CATHEDRAL**

Project Title                      Job No.    2118  
**GEOPHYSICAL SURVEY -  
HEREFORD CATHEDRAL CLOSE**

Subject  
**PLOT OF PROCESSED  
GRADIOMETER DATA**

**STRATASCAN™**  
GEOPHYSICS FOR ARCHAEOLOGY  
AND ENGINEERING  
VINEYARD HOUSE  
UPPER HOOK ROAD  
UPTON UPON SEVERN  
UK  
WR8 0SA  
T: +44 (0)1684 592266  
F: +44 (0)1684 594142  
E: info@stratascan.co.uk  
www.stratascan.co.uk

Scale                      0m    5    10    15    20    25m  
**1:500**

|                              |                          |                         |
|------------------------------|--------------------------|-------------------------|
| Plot<br><b>A3</b>            | Checked by<br><b>SAS</b> | Issue No.<br><b>01</b>  |
| Survey date<br><b>MAY 06</b> | Drawn by<br><b>HH</b>    | Figure No.<br><b>12</b> |





| Amendments |      |             |
|------------|------|-------------|
| Issue No.  | Date | Description |
| -          | -    | -           |



| KEY |   |
|-----|---|
|     | Discrete positive anomaly - possible cut feature or area of discrete ground disturbance     |
|     | Positive anomaly with associated negative response - ferrous object                         |
|     | Magnetic disturbance - associated with service  |
|     | Positive linear anomaly - cut feature of possible archaeological origin                     |
|     | Area of magnetic disturbance - evidence of ground disturbance or structural debris          |
|     | Area of magnetic debris - caused by nearby pathways, buildings and objects of modern origin |

Client  
**HEREFORD CATHEDRAL**

Project Title **GEOPHYSICAL SURVEY -**  
Job No. 2118  
**HEREFORD CATHEDRAL CLOSE**


Subject  
**ABSTRACTION AND**  
**INTERPRETATION OF GRADIOMETER**  
**ANOMALIES**

**STRATASCAN™**  
 GEOPHYSICS FOR ARCHAEOLOGY  
 AND ENGINEERING  
 VINEYARD HOUSE  
 UPPER HOOK ROAD  
 UPTON UPON SEVERN  
 UK  
 WR8 0SA  
 T: +44 (0)1684 592266  
 F: +44 (0)1684 594142  
 E: info@stratascan.co.uk  
 www.stratascan.co.uk


Scale **1:500**  
0m 5 10 15 20 25m

|                              |                          |                         |
|------------------------------|--------------------------|-------------------------|
| Plot<br><b>A3</b>            | Checked by<br><b>SAS</b> | Issue No.<br><b>01</b>  |
| Survey date<br><b>MAY 06</b> | Drawn by<br><b>HH</b>    | Figure No.<br><b>13</b> |



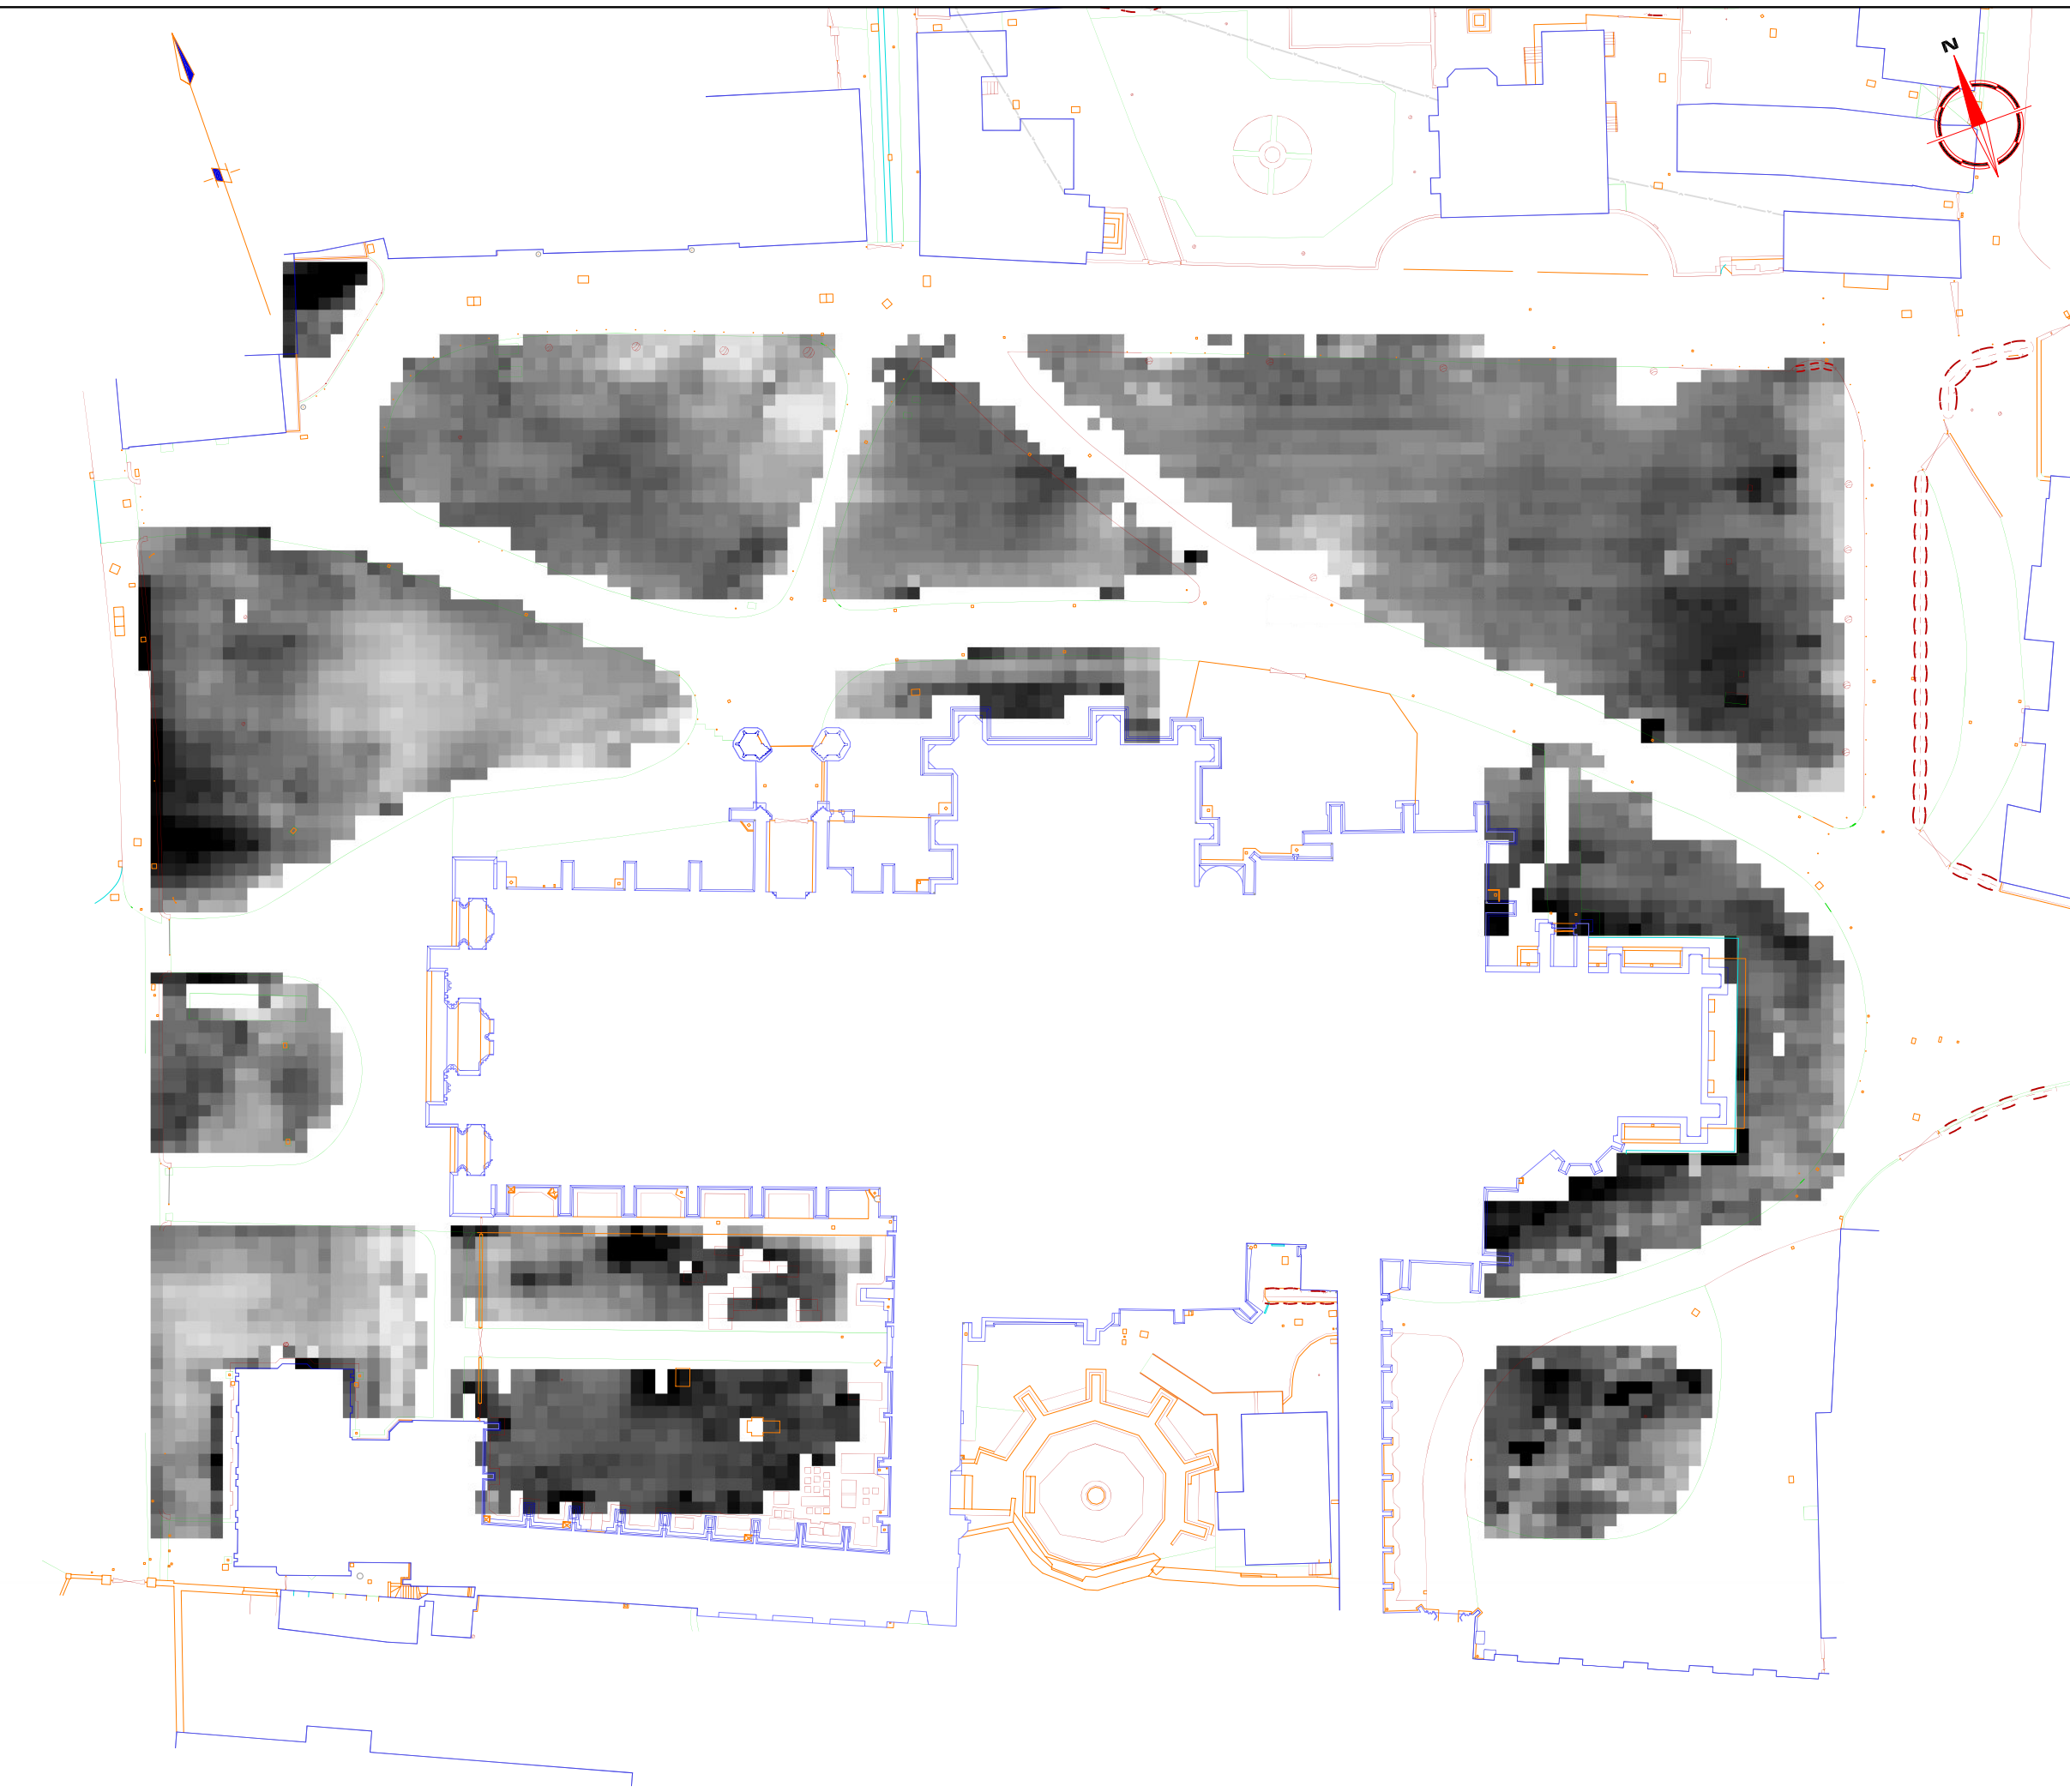

| Amendments |      |             |
|------------|------|-------------|
| Issue No.  | Date | Description |
| -          | -    | -           |
| -          | -    | -           |

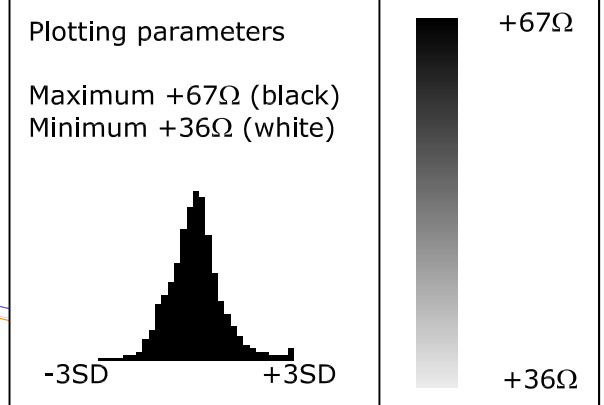

Client  
**HEREFORD CATHEDRAL**

Project Title Job No. 2118  
**GEOPHYSICAL SURVEY -  
HEREFORD CATHEDRAL CLOSE**


Subject  
**PLOT OF RAW RESISTANCE  
DATA**

**STRATASCAN™**  
GEOPHYSICS FOR ARCHAEOLOGY  
AND ENGINEERING  
VINEYARD HOUSE  
UPPER HOOK ROAD  
UPTON UPON SEVERN  
UK  
WR8 0SA  
T: +44 (0)1684 592266  
F: +44 (0)1684 594142  
E: info@stratascan.co.uk  
www.stratascan.co.uk


Scale **1:500**  
0m 5 10 15 20 25m

|                              |                          |                         |
|------------------------------|--------------------------|-------------------------|
| Plot<br><b>A3</b>            | Checked by<br><b>SAS</b> | Issue No.<br><b>01</b>  |
| Survey date<br><b>MAY 06</b> | Drawn by<br><b>HH</b>    | Figure No.<br><b>14</b> |



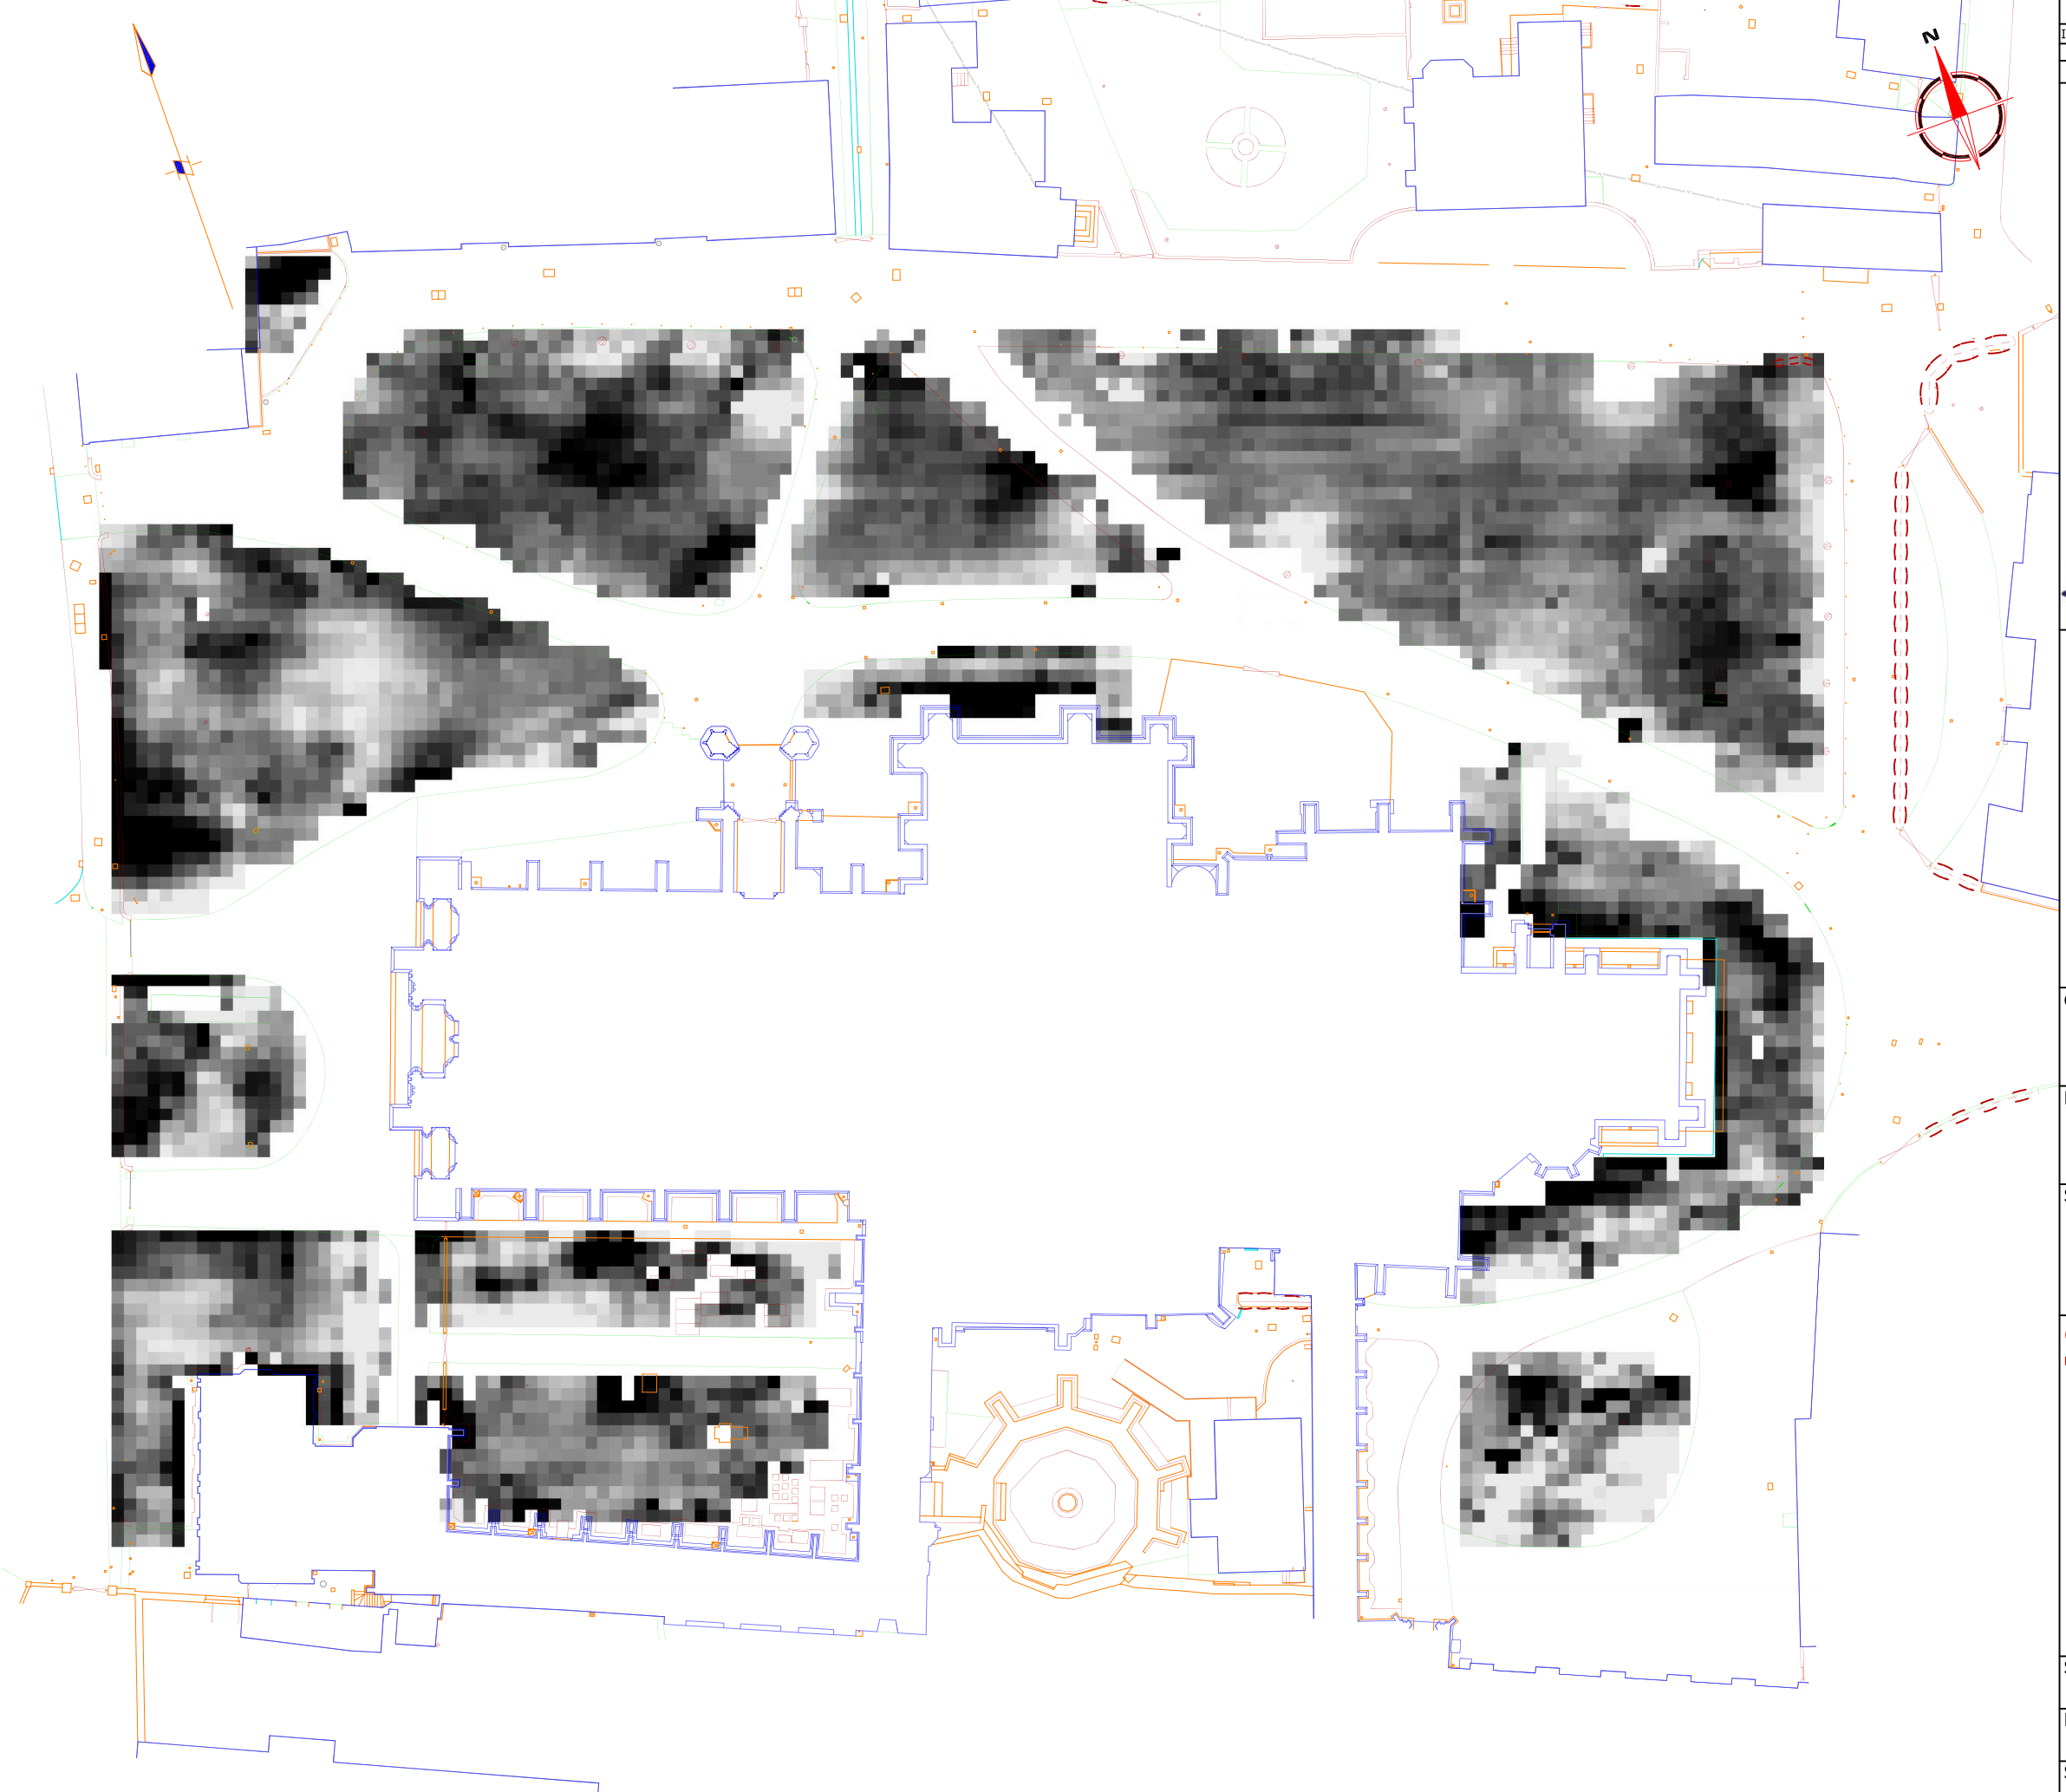

| Amendments |      |             |
|------------|------|-------------|
| Issue No.  | Date | Description |
| -          | -    | -           |

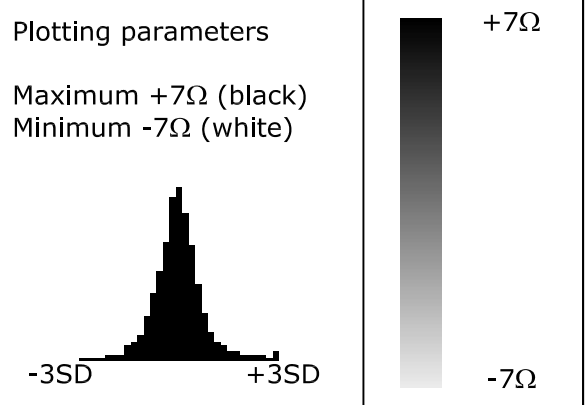

Client  
**HEREFORD CATHEDRAL**

Project Title Job No. 2118  
**GEOPHYSICAL SURVEY -  
HEREFORD CATHEDRAL CLOSE**


Subject  
**PLOT OF PROCESSED  
RESISTANCE DATA**

**STRATASCAN™**  
GEOPHYSICS FOR ARCHAEOLOGY  
AND ENGINEERING  
VINEYARD HOUSE  
UPPER HOOK ROAD  
UPTON UPON SEVERN  
UK  
WR8 0SA  
T: +44 (0)1684 592266  
F: +44 (0)1684 594142  
E: info@stratascan.co.uk  
www.stratascan.co.uk

Scale **1:500**  
0m 5 10 15 20 25m

|                              |                          |                         |
|------------------------------|--------------------------|-------------------------|
| Plot<br><b>A3</b>            | Checked by<br><b>SAS</b> | Issue No.<br><b>01</b>  |
| Survey date<br><b>MAY 06</b> | Drawn by<br><b>HH</b>    | Figure No.<br><b>15</b> |



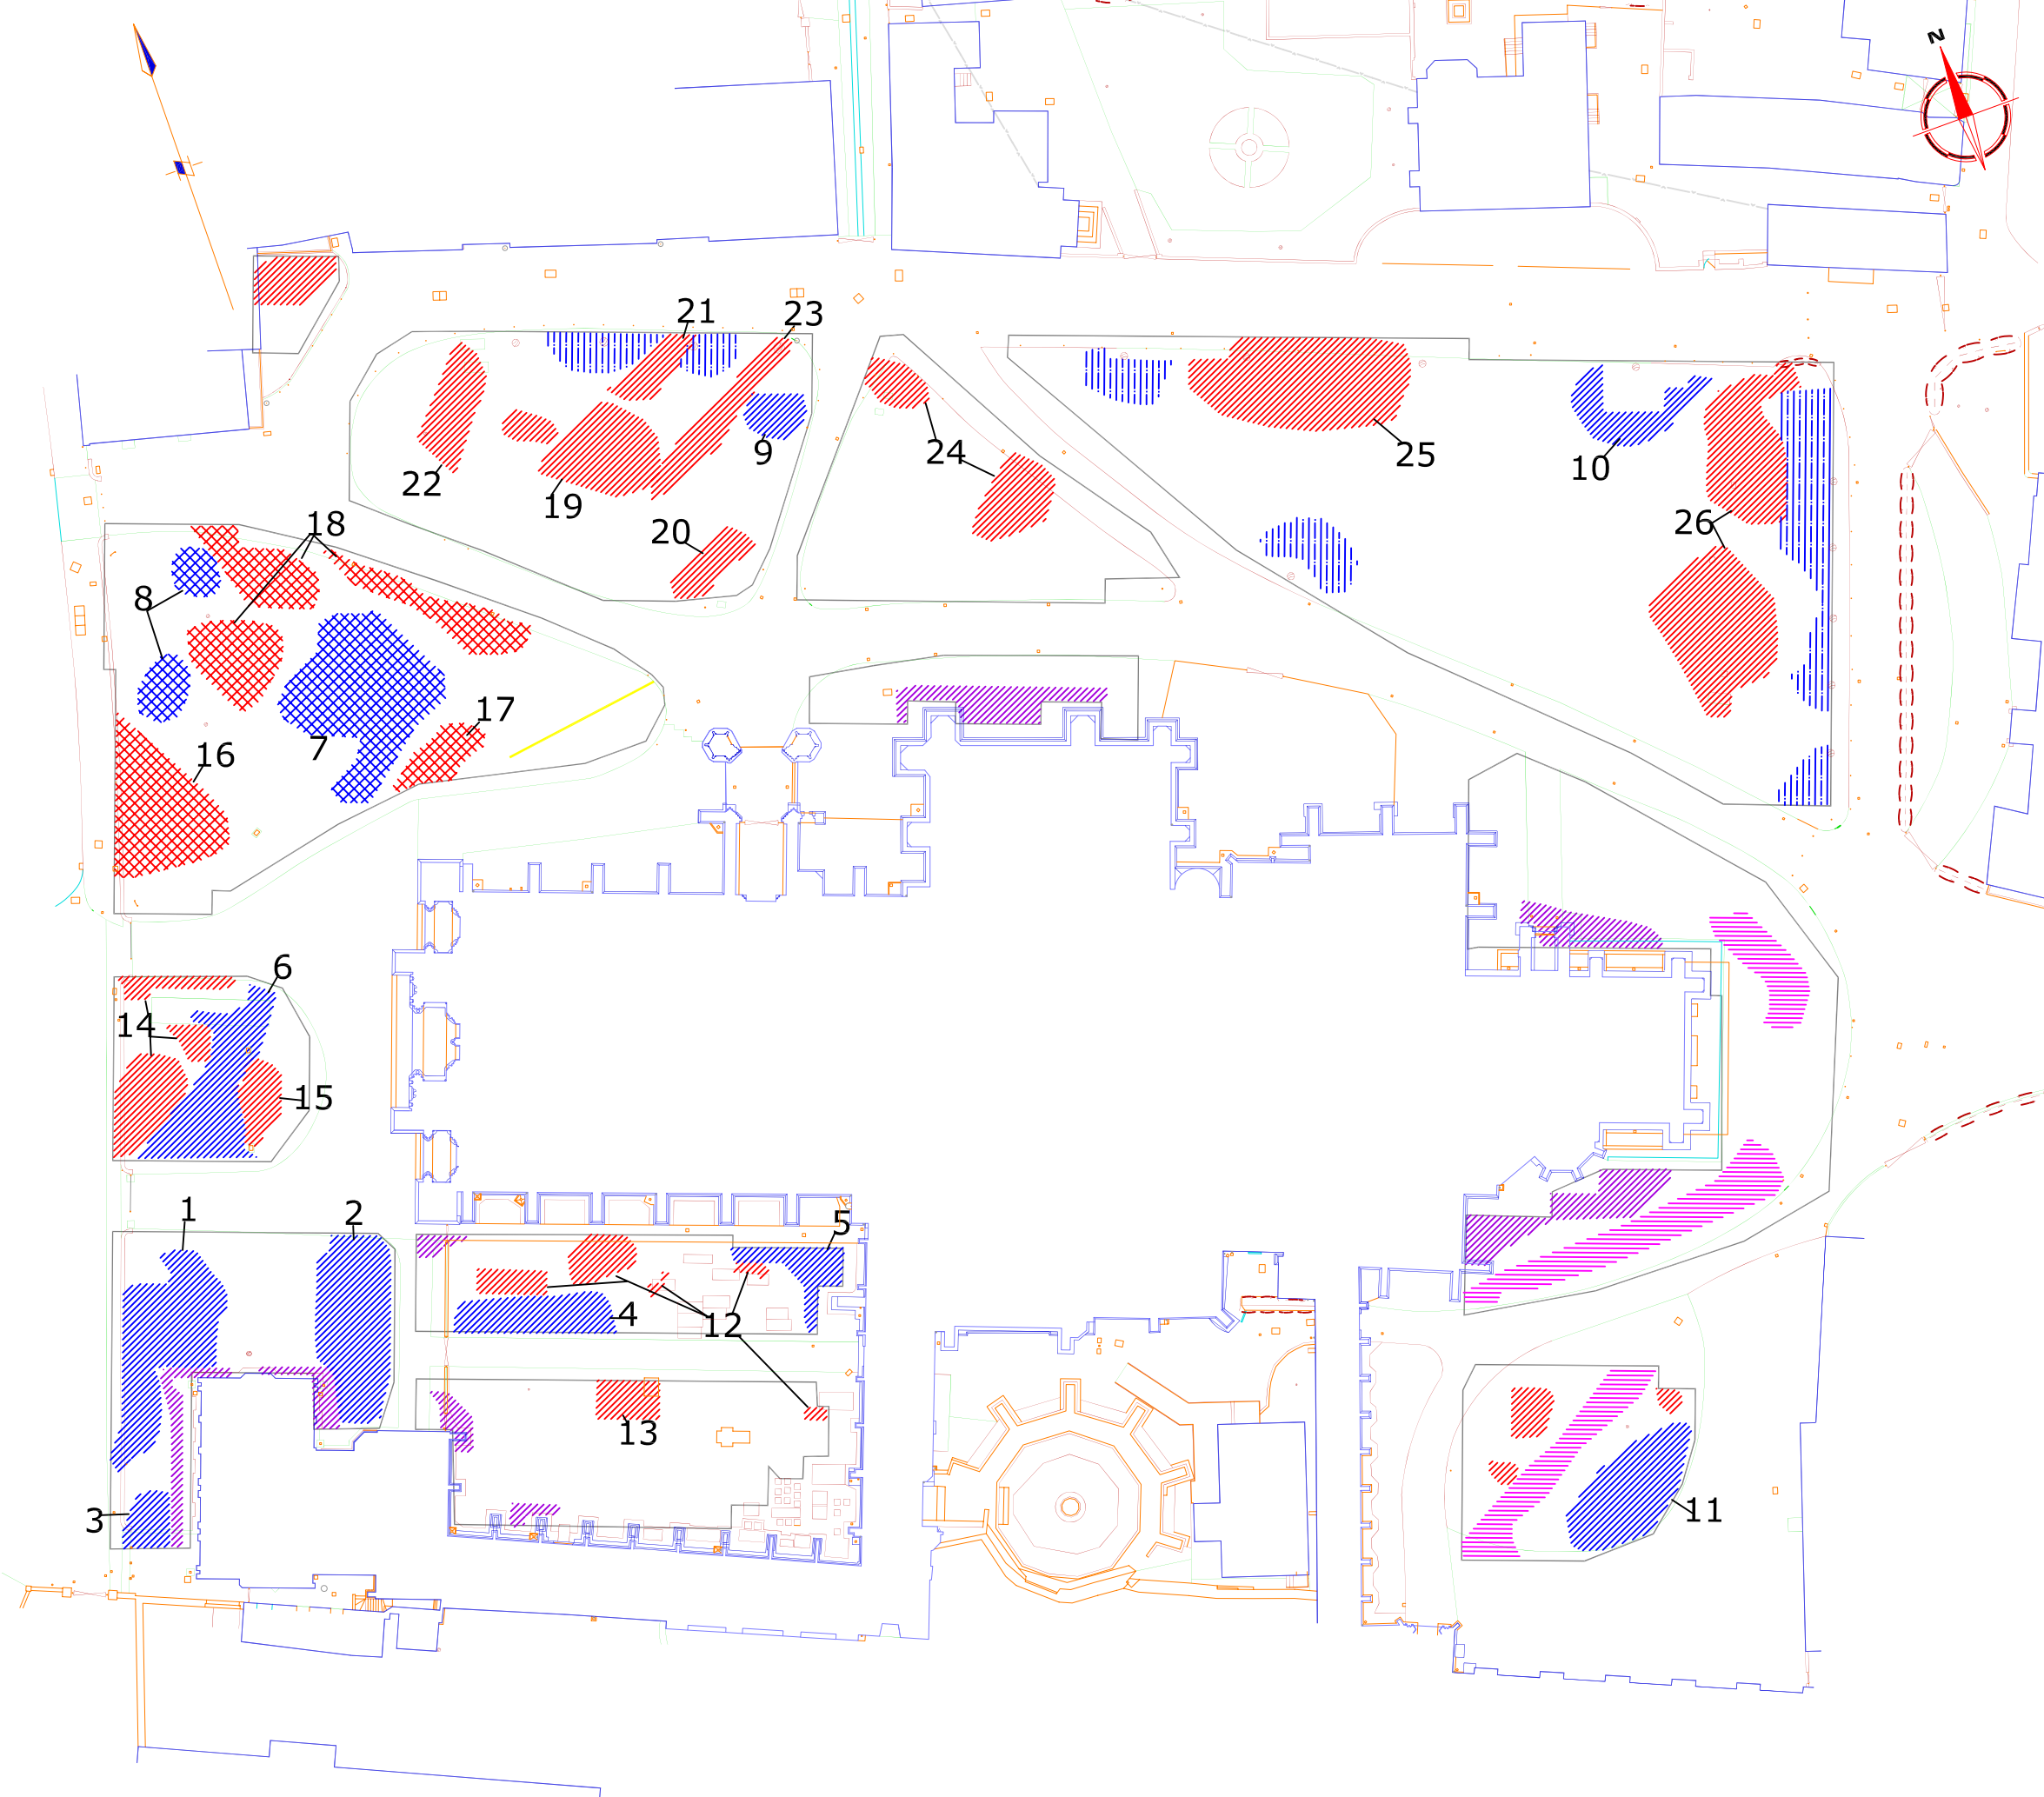

| Amendments |      |             |
|------------|------|-------------|
| Issue No.  | Date | Description |
| -          | -    | -           |



| KEY |   |
|-----|---|
|     | Low resistance linear anomaly - possibly associated with a service  |
|     | High resistance area anomaly - possible areas of structural debris  |
|     | High resistance area anomaly - possible areas of structural debris and landscaping activities             |
|     | Low resistance area anomaly - possible cut features of archaeological origin                              |
|     | Low resistance area anomaly - cut features possibly associated with demolition and landscaping activities |
|     | Low resistance area anomaly - possibly associated with the nearby trees                                   |
|     | High resistance area anomalies associated with nearby buildings   |
|     | Possible service trench   |

Client  
**HEREFORD CATHEDRAL**

Project Title Job No. 2118  
**GEOPHYSICAL SURVEY -  
HEREFORD CATHEDRAL CLOSE**


Subject  
**ABSTRACTION AND  
INTERPRETATION OF RESISTANCE  
ANOMALIES**

**STRATASCAN™**  
GEOPHYSICS FOR ARCHAEOLOGY  
AND ENGINEERING  
VINEYARD HOUSE  
UPPER HOOK ROAD  
UPTON UPON SEVERN  
UK  
WR8 0SA  
T: +44 (0)1684 592266  
F: +44 (0)1684 594142  
E: info@stratascan.co.uk  
www.stratascan.co.uk

Scale **1:500**  
0m 5 10 15 20 25m

|                              |                          |                         |
|------------------------------|--------------------------|-------------------------|
| Plot<br><b>A3</b>            | Checked by<br><b>SAS</b> | Issue No.<br><b>01</b>  |
| Survey date<br><b>MAY 06</b> | Drawn by<br><b>HH</b>    | Figure No.<br><b>16</b> |



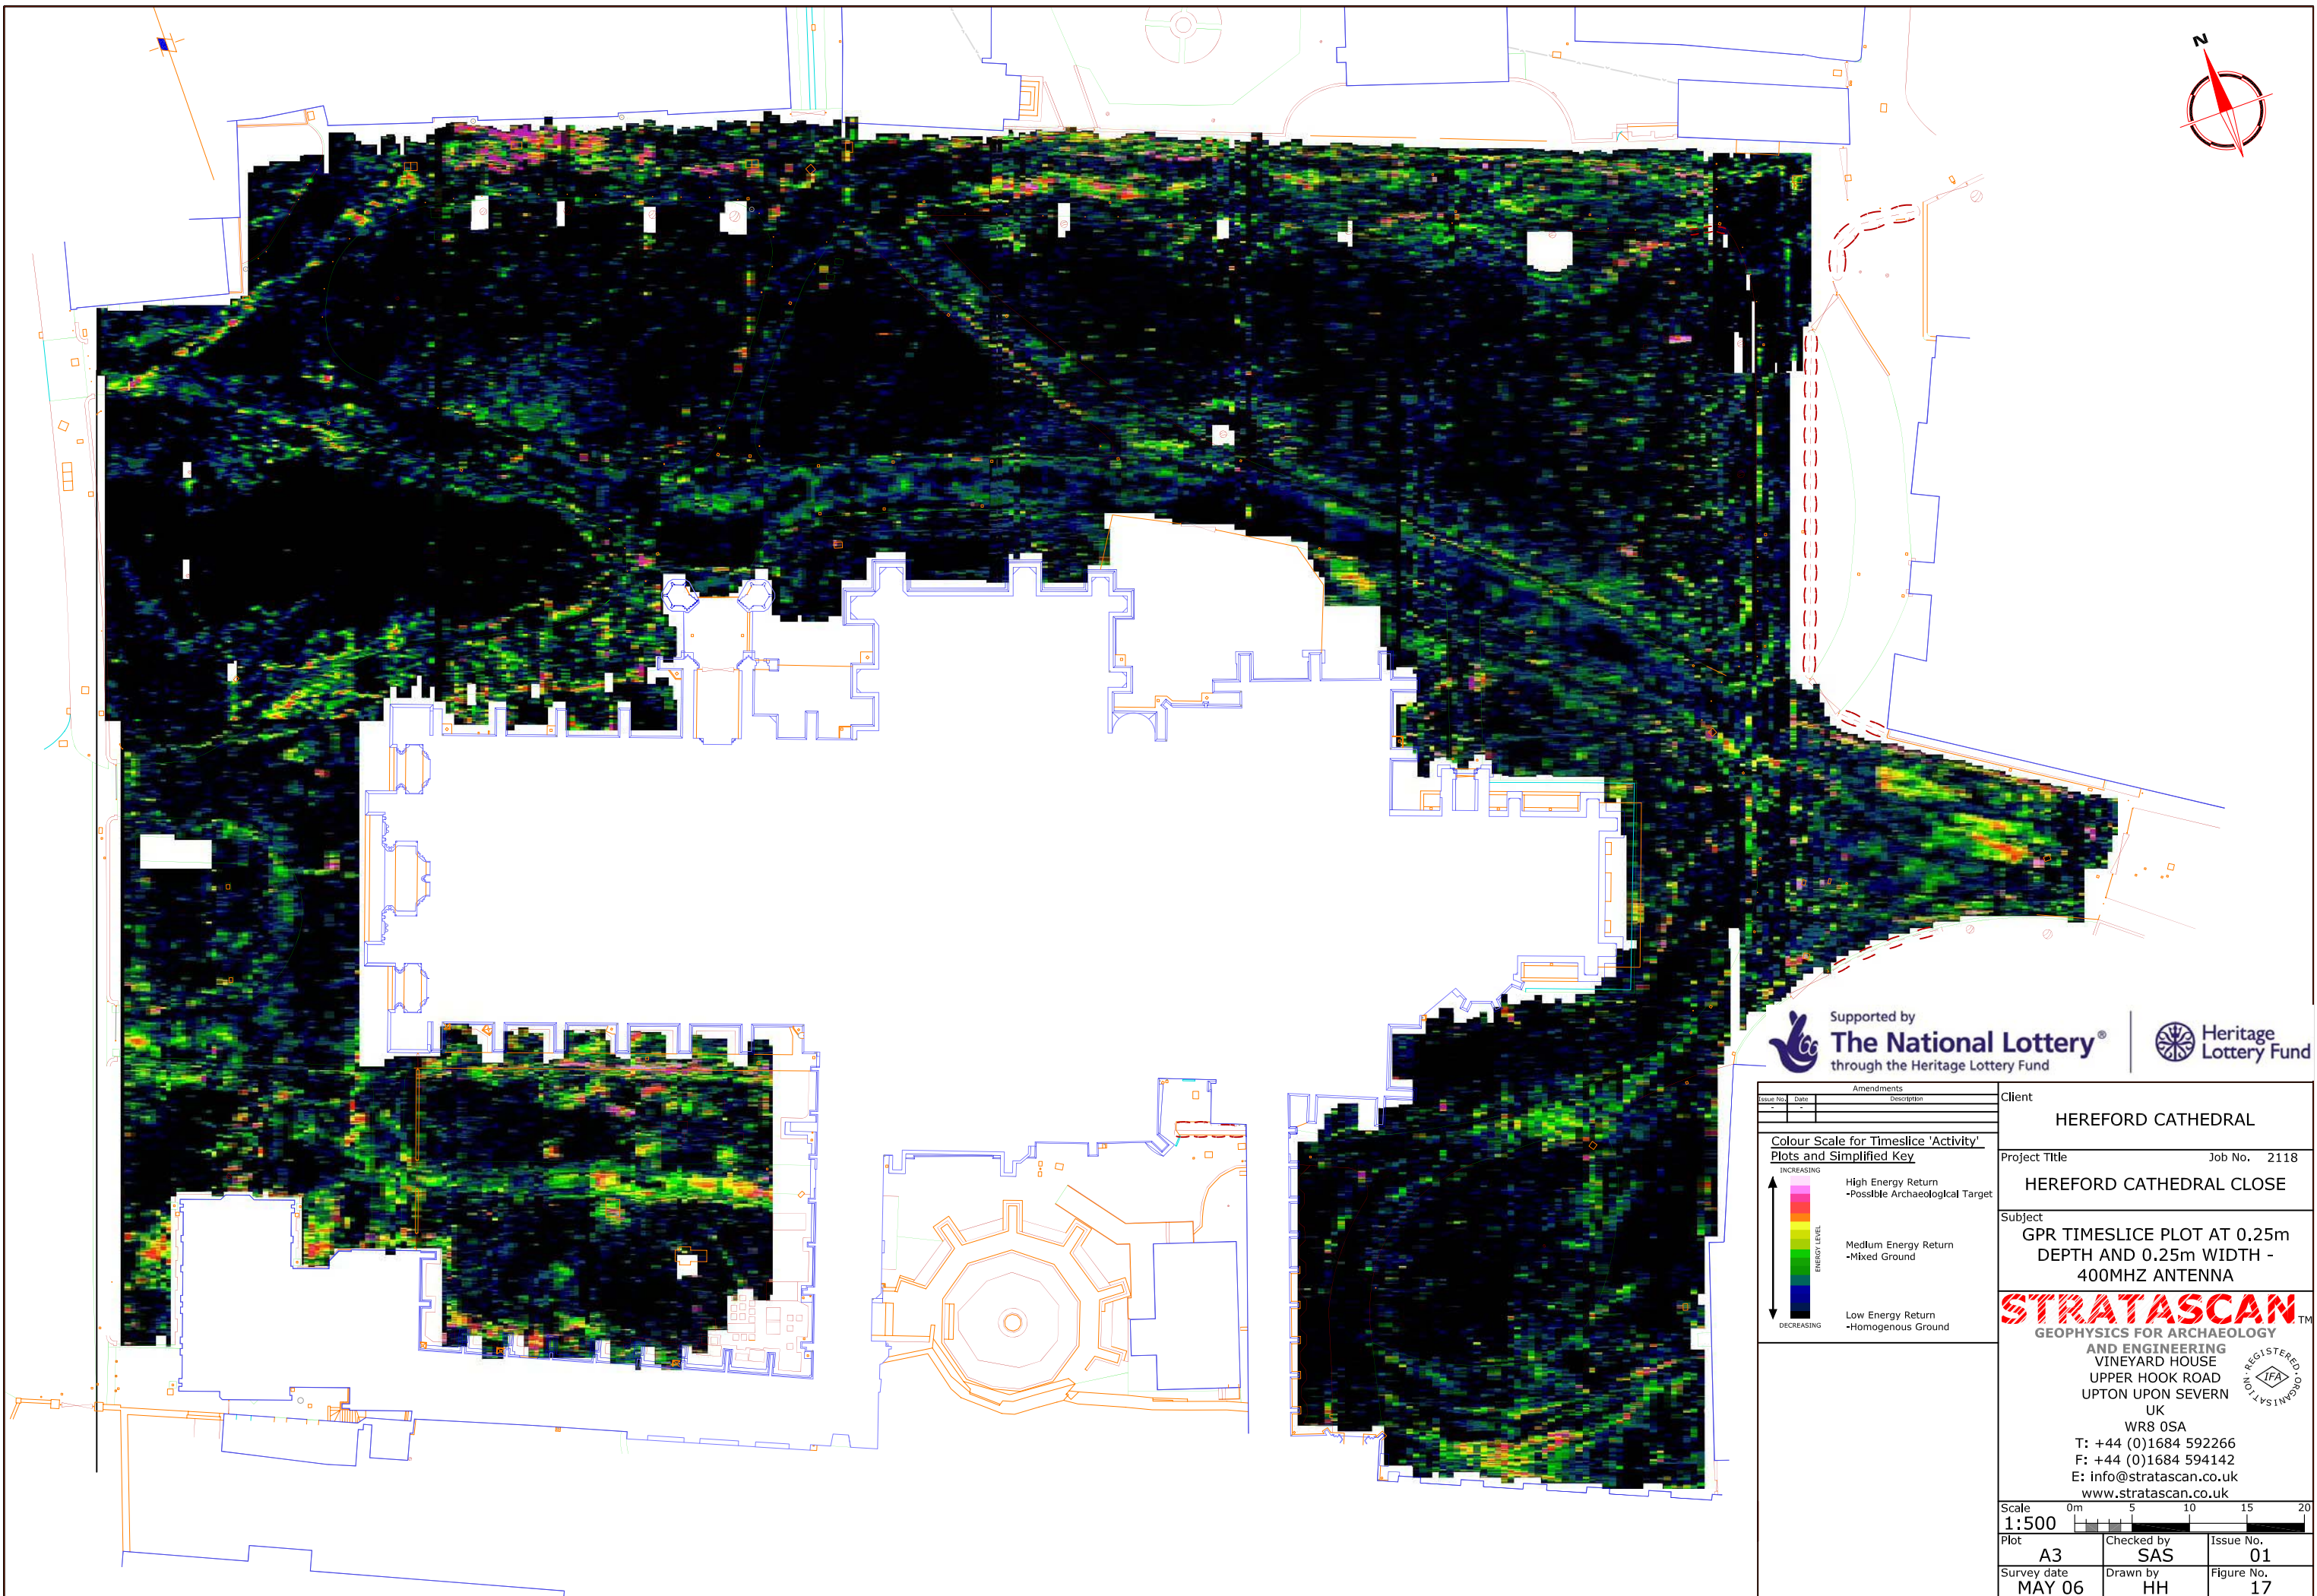

Supported by  
**The National Lottery**  
 through the Heritage Lottery Fund




| Scale No. | Date | Amendments |
|-----------|------|------------|
|           |      |            |

Client  
**HEREFORD CATHEDRAL**


**Colour Scale for Timeslice 'Activity'**  
**Plots and Simplified Key**

Project Title Job No. 2118  
**HEREFORD CATHEDRAL CLOSE**

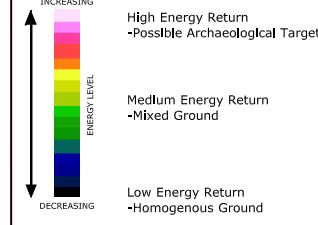


Subject  
 GPR TIMESLICE PLOT AT 0.25m DEPTH AND 0.25m WIDTH - 400MHZ ANTENNA

**STRATASCAN**  
 GEOPHYSICS FOR ARCHAEOLOGY  
 AND ENGINEERING  
 VINEYARD HOUSE  
 UPPER HOOK ROAD  
 UPTON UPON SEVERN  
 UK  
 WR8 0SA  
 T: +44 (0)1684 592266  
 F: +44 (0)1684 594142  
 E: info@stratascan.co.uk  
 www.stratascan.co.uk
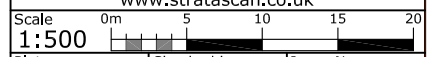
|             |            |            |
|-------------|------------|------------|
| Plot        | Checked by | Issue No.  |
| A3          | SAS        | 01         |
| Survey date | Drawn by   | Figure No. |
| MAY 06      | HH         | 17         |



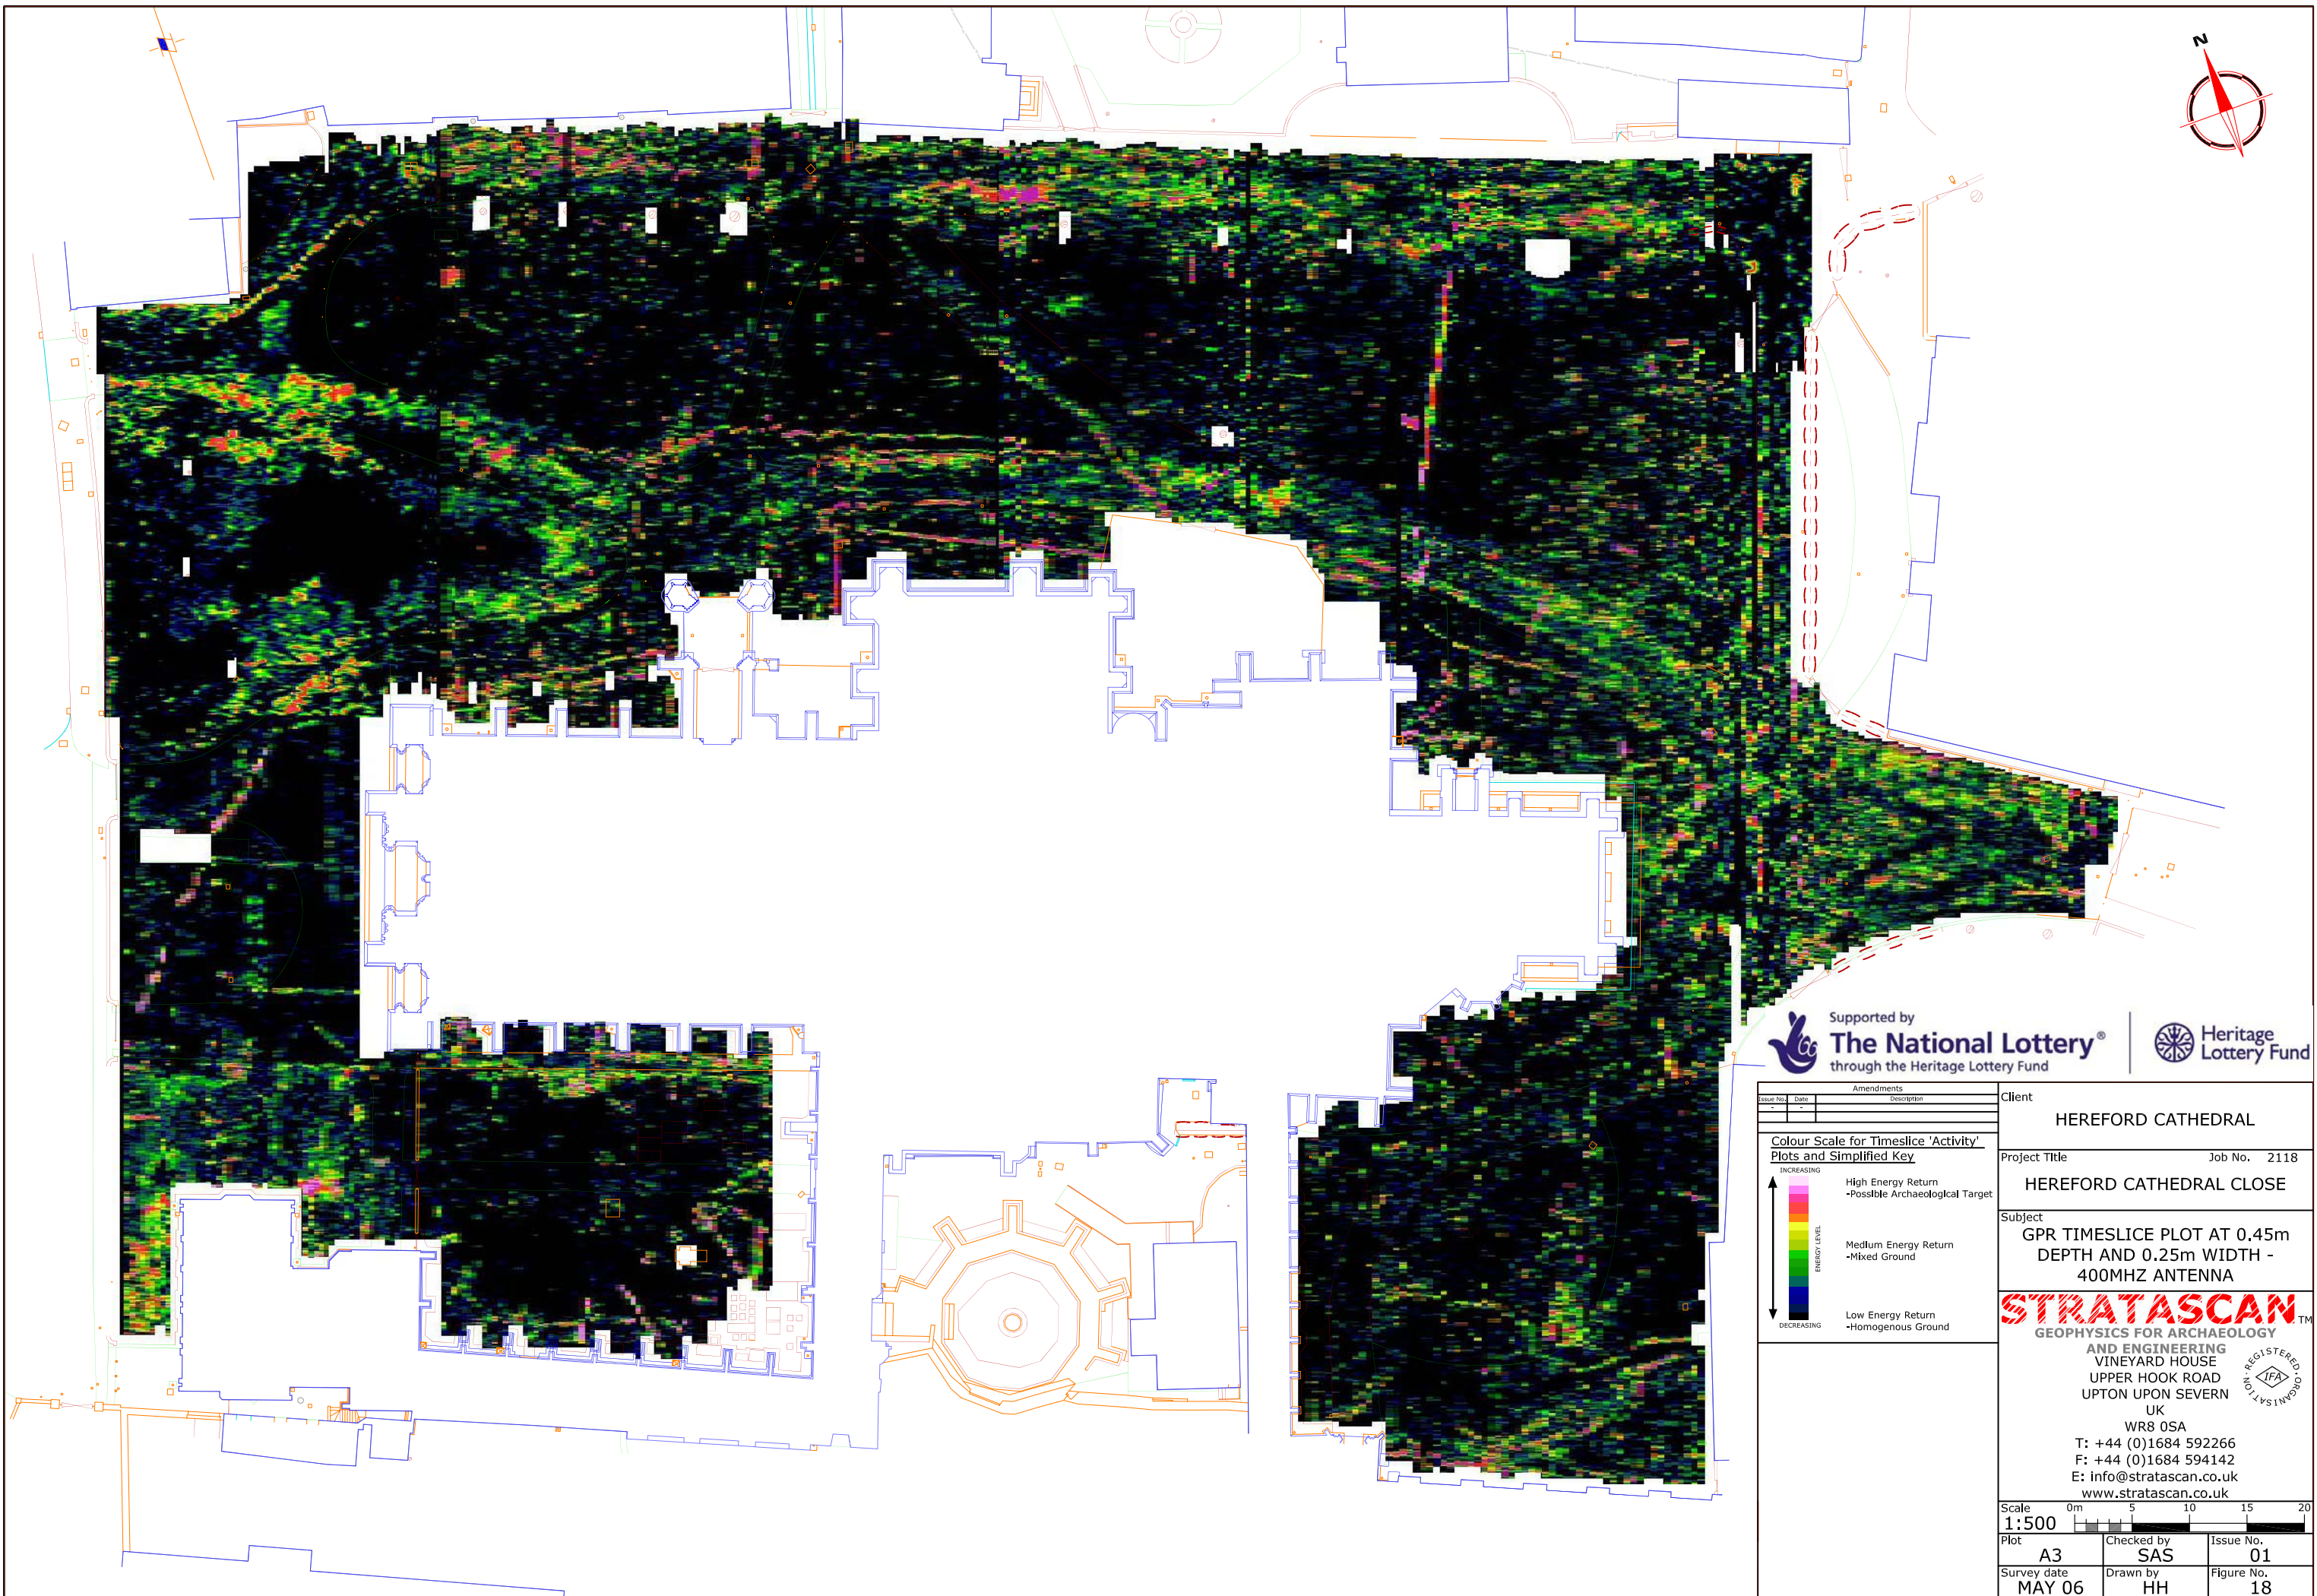


Supported by  
**The National Lottery**  
 through the Heritage Lottery Fund



| Issue No. | Date | Amendments |
|-----------|------|------------|
|           |      |            |

Client  
**HEREFORD CATHEDRAL**

**Colour Scale for Timeslice 'Activity'**  
**Plots and Simplified Key**

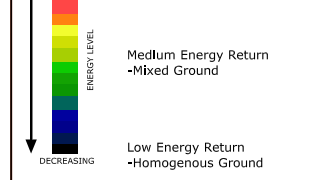


Project Title  
**HEREFORD CATHEDRAL CLOSE**

Job No. 2118


Subject  
**GPR TIMESLICE PLOT AT 0.45m DEPTH AND 0.25m WIDTH - 400MHZ ANTENNA**

**STRATASCAN**  
 GEOPHYSICS FOR ARCHAEOLOGY  
 AND ENGINEERING  
 VINEYARD HOUSE  
 UPPER HOOK ROAD  
 UPTON UPON SEVERN  
 UK  
 WR8 0SA  
 T: +44 (0)1684 592266  
 F: +44 (0)1684 594142  
 E: info@stratascan.co.uk  
 www.stratascan.co.uk
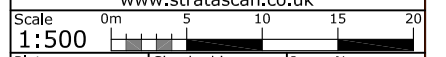
|                              |                          |                         |
|------------------------------|--------------------------|-------------------------|
| Plot<br><b>A3</b>            | Checked by<br><b>SAS</b> | Issue No.<br><b>01</b>  |
| Survey date<br><b>MAY 06</b> | Drawn by<br><b>HH</b>    | Figure No.<br><b>18</b> |



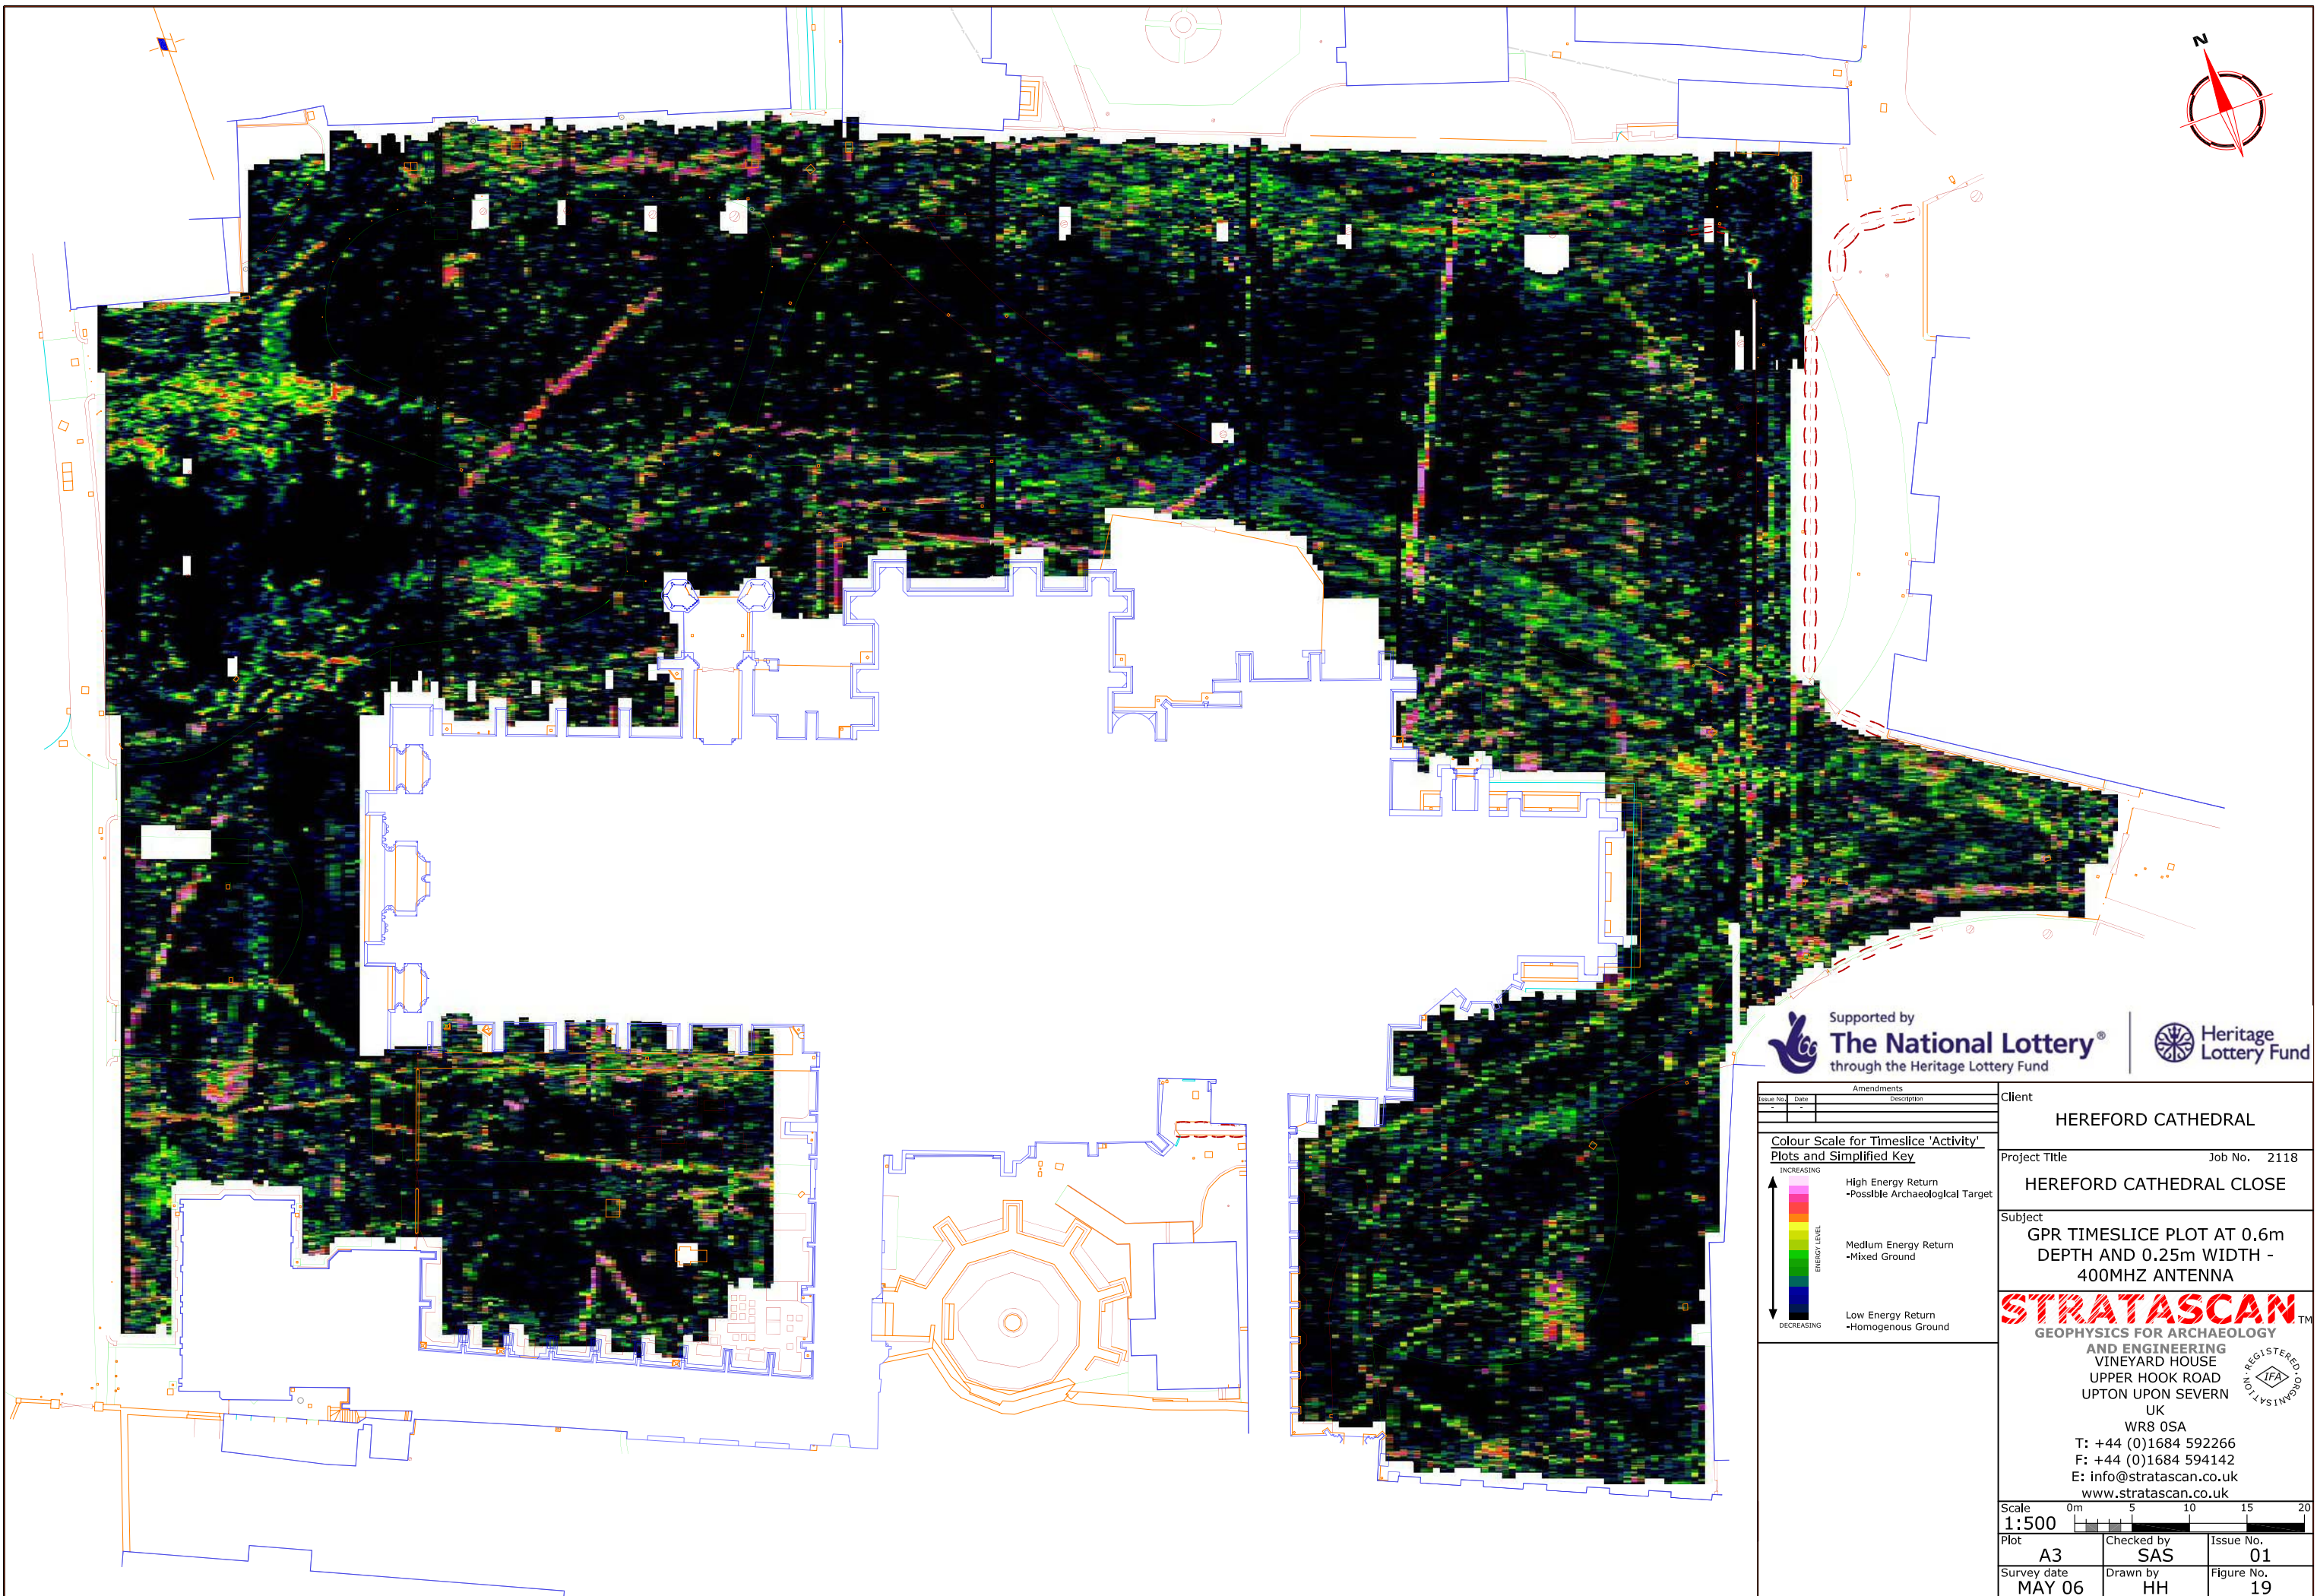

Supported by  
**The National Lottery**  
 through the Heritage Lottery Fund



Amendments  
 Scale No. Date Description  
 - - - - -  
 - - - - -  
 - - - - -


**Colour Scale for Timeslice 'Activity'**  
**Plots and Simplified Key**

INCREASING ENERGY LEVEL


High Energy Return  
 -Possible Archaeological Target

Medium Energy Return  
 -Mixed Ground

DECREASING ENERGY LEVEL  
 Low Energy Return  
 -Homogenous Ground

|  |   |               |
|--|---|---------------|
| Client   | HEREFORD CATHEDRAL  |               |
| Project Title  | HEREFORD CATHEDRAL CLOSE  |               |
| Job No.  | 2118  |               |
| Subject  | GPR TIMESLICE PLOT AT 0.6m DEPTH AND 0.25m WIDTH - 400MHZ ANTENNA |               |
|  <p><b>STRATASCAN</b><br/>       GEOPHYSICS FOR ARCHAEOLOGY<br/>       AND ENGINEERING<br/>       VINEYARD HOUSE<br/>       UPPER HOOK ROAD<br/>       UPTON UPON SEVERN<br/>       UK<br/>       WR8 0SA<br/>       T: +44 (0)1684 592266<br/>       F: +44 (0)1684 594142<br/>       E: info@stratascan.co.uk<br/>       www.stratascan.co.uk</p> |   |               |
| Scale  | 1:500   |               |
| Plot   | A3  | Issue No. 01  |
| Checked by   | SAS   | Figure No. 19 |
| Survey date  | MAY 06  |               |
| Drawn by   | HH  |               |



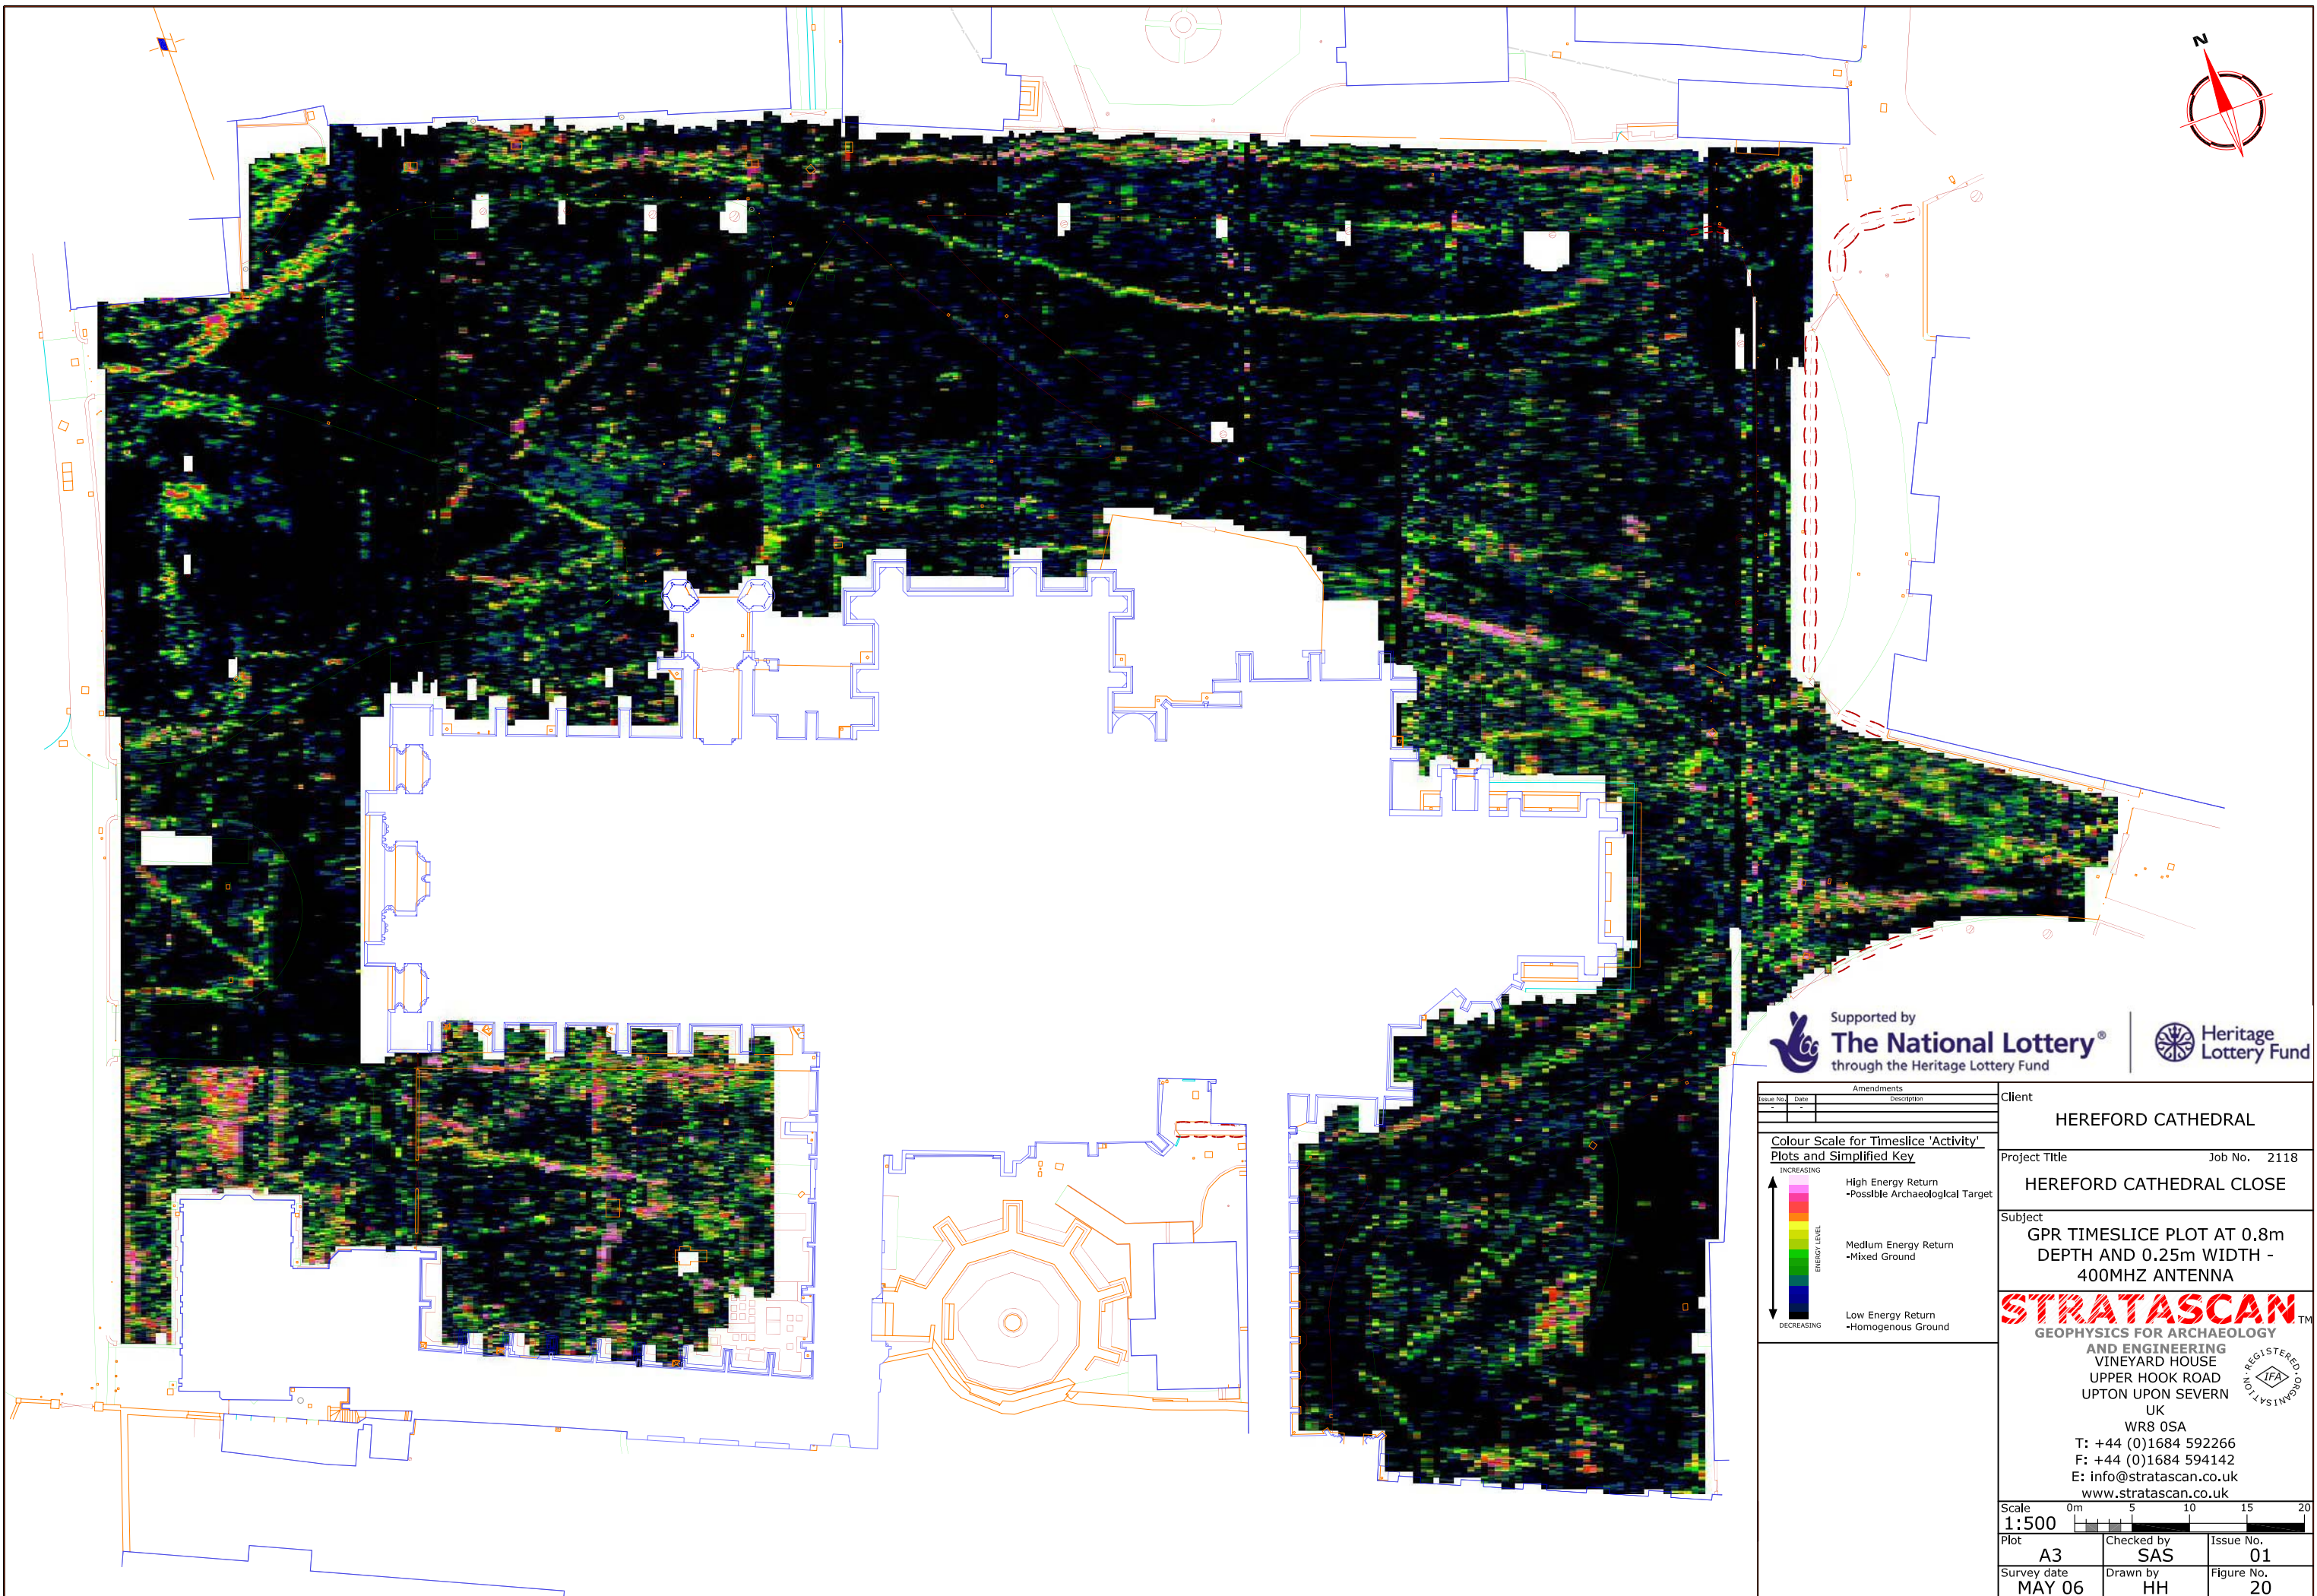


Supported by  
**The National Lottery**  
 through the Heritage Lottery Fund



| Issue No. | Date | Amendments |
|-----------|------|------------|
|           |      |            |

Client  
**HEREFORD CATHEDRAL**

**Colour Scale for Timeslice 'Activity'**  
**Plots and Simplified Key**

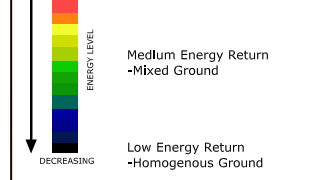

Project Title  
**HEREFORD CATHEDRAL CLOSE**


Job No. 2118

Subject  
**GPR TIMESLICE PLOT AT 0.8m DEPTH AND 0.25m WIDTH - 400MHZ ANTENNA**

**STRATASCAN**  
 GEOPHYSICS FOR ARCHAEOLOGY  
 AND ENGINEERING  
 VINEYARD HOUSE  
 UPPER HOOK ROAD  
 UPTON UPON SEVERN  
 UK  
 WR8 0SA  
 T: +44 (0)1684 592266  
 F: +44 (0)1684 594142  
 E: info@stratascan.co.uk  
 www.stratascan.co.uk



Scale  
**1:500**

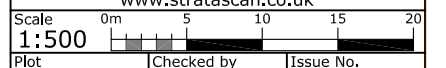

|                              |                          |                         |
|------------------------------|--------------------------|-------------------------|
| Plot<br><b>A3</b>            | Checked by<br><b>SAS</b> | Issue No.<br><b>01</b>  |
| Survey date<br><b>MAY 06</b> | Drawn by<br><b>HH</b>    | Figure No.<br><b>20</b> |





Supported by  
**The National Lottery**  
 through the Heritage Lottery Fund




| Scale No. | Date | Amendments |
|-----------|------|------------|
|           |      |            |

Client  
**HEREFORD CATHEDRAL**

**Colour Scale for Timeslice 'Activity'**  
**Plots and Simplified Key**

Project Title  
**HEREFORD CATHEDRAL CLOSE**

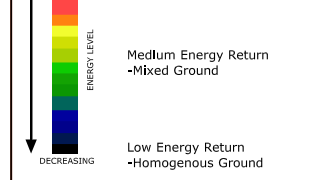


Job No. 2118  
 Subject  
**GPR TIMESLICE PLOT AT 1m DEPTH AND 0.25m WIDTH - 400MHZ ANTENNA**

**STRATASCAN**  
 GEOPHYSICS FOR ARCHAEOLOGY  
 AND ENGINEERING  
 VINEYARD HOUSE  
 UPPER HOOK ROAD  
 UPTON UPON SEVERN  
 UK  
 WR8 0SA  
 T: +44 (0)1684 592266  
 F: +44 (0)1684 594142  
 E: info@stratascan.co.uk  
 www.stratascan.co.uk



|              |               |            |  |
|--------------|---------------|------------|--|
| Scale        | 0m 5 10 15 20 |            |  |
| <b>1:500</b> |               |            |  |
| Plot         | Checked by    | Issue No.  |  |
| A3           | SAS           | 01         |  |
| Survey date  | Drawn by      | Figure No. |  |
| MAY 06       | HH            | 21         |  |



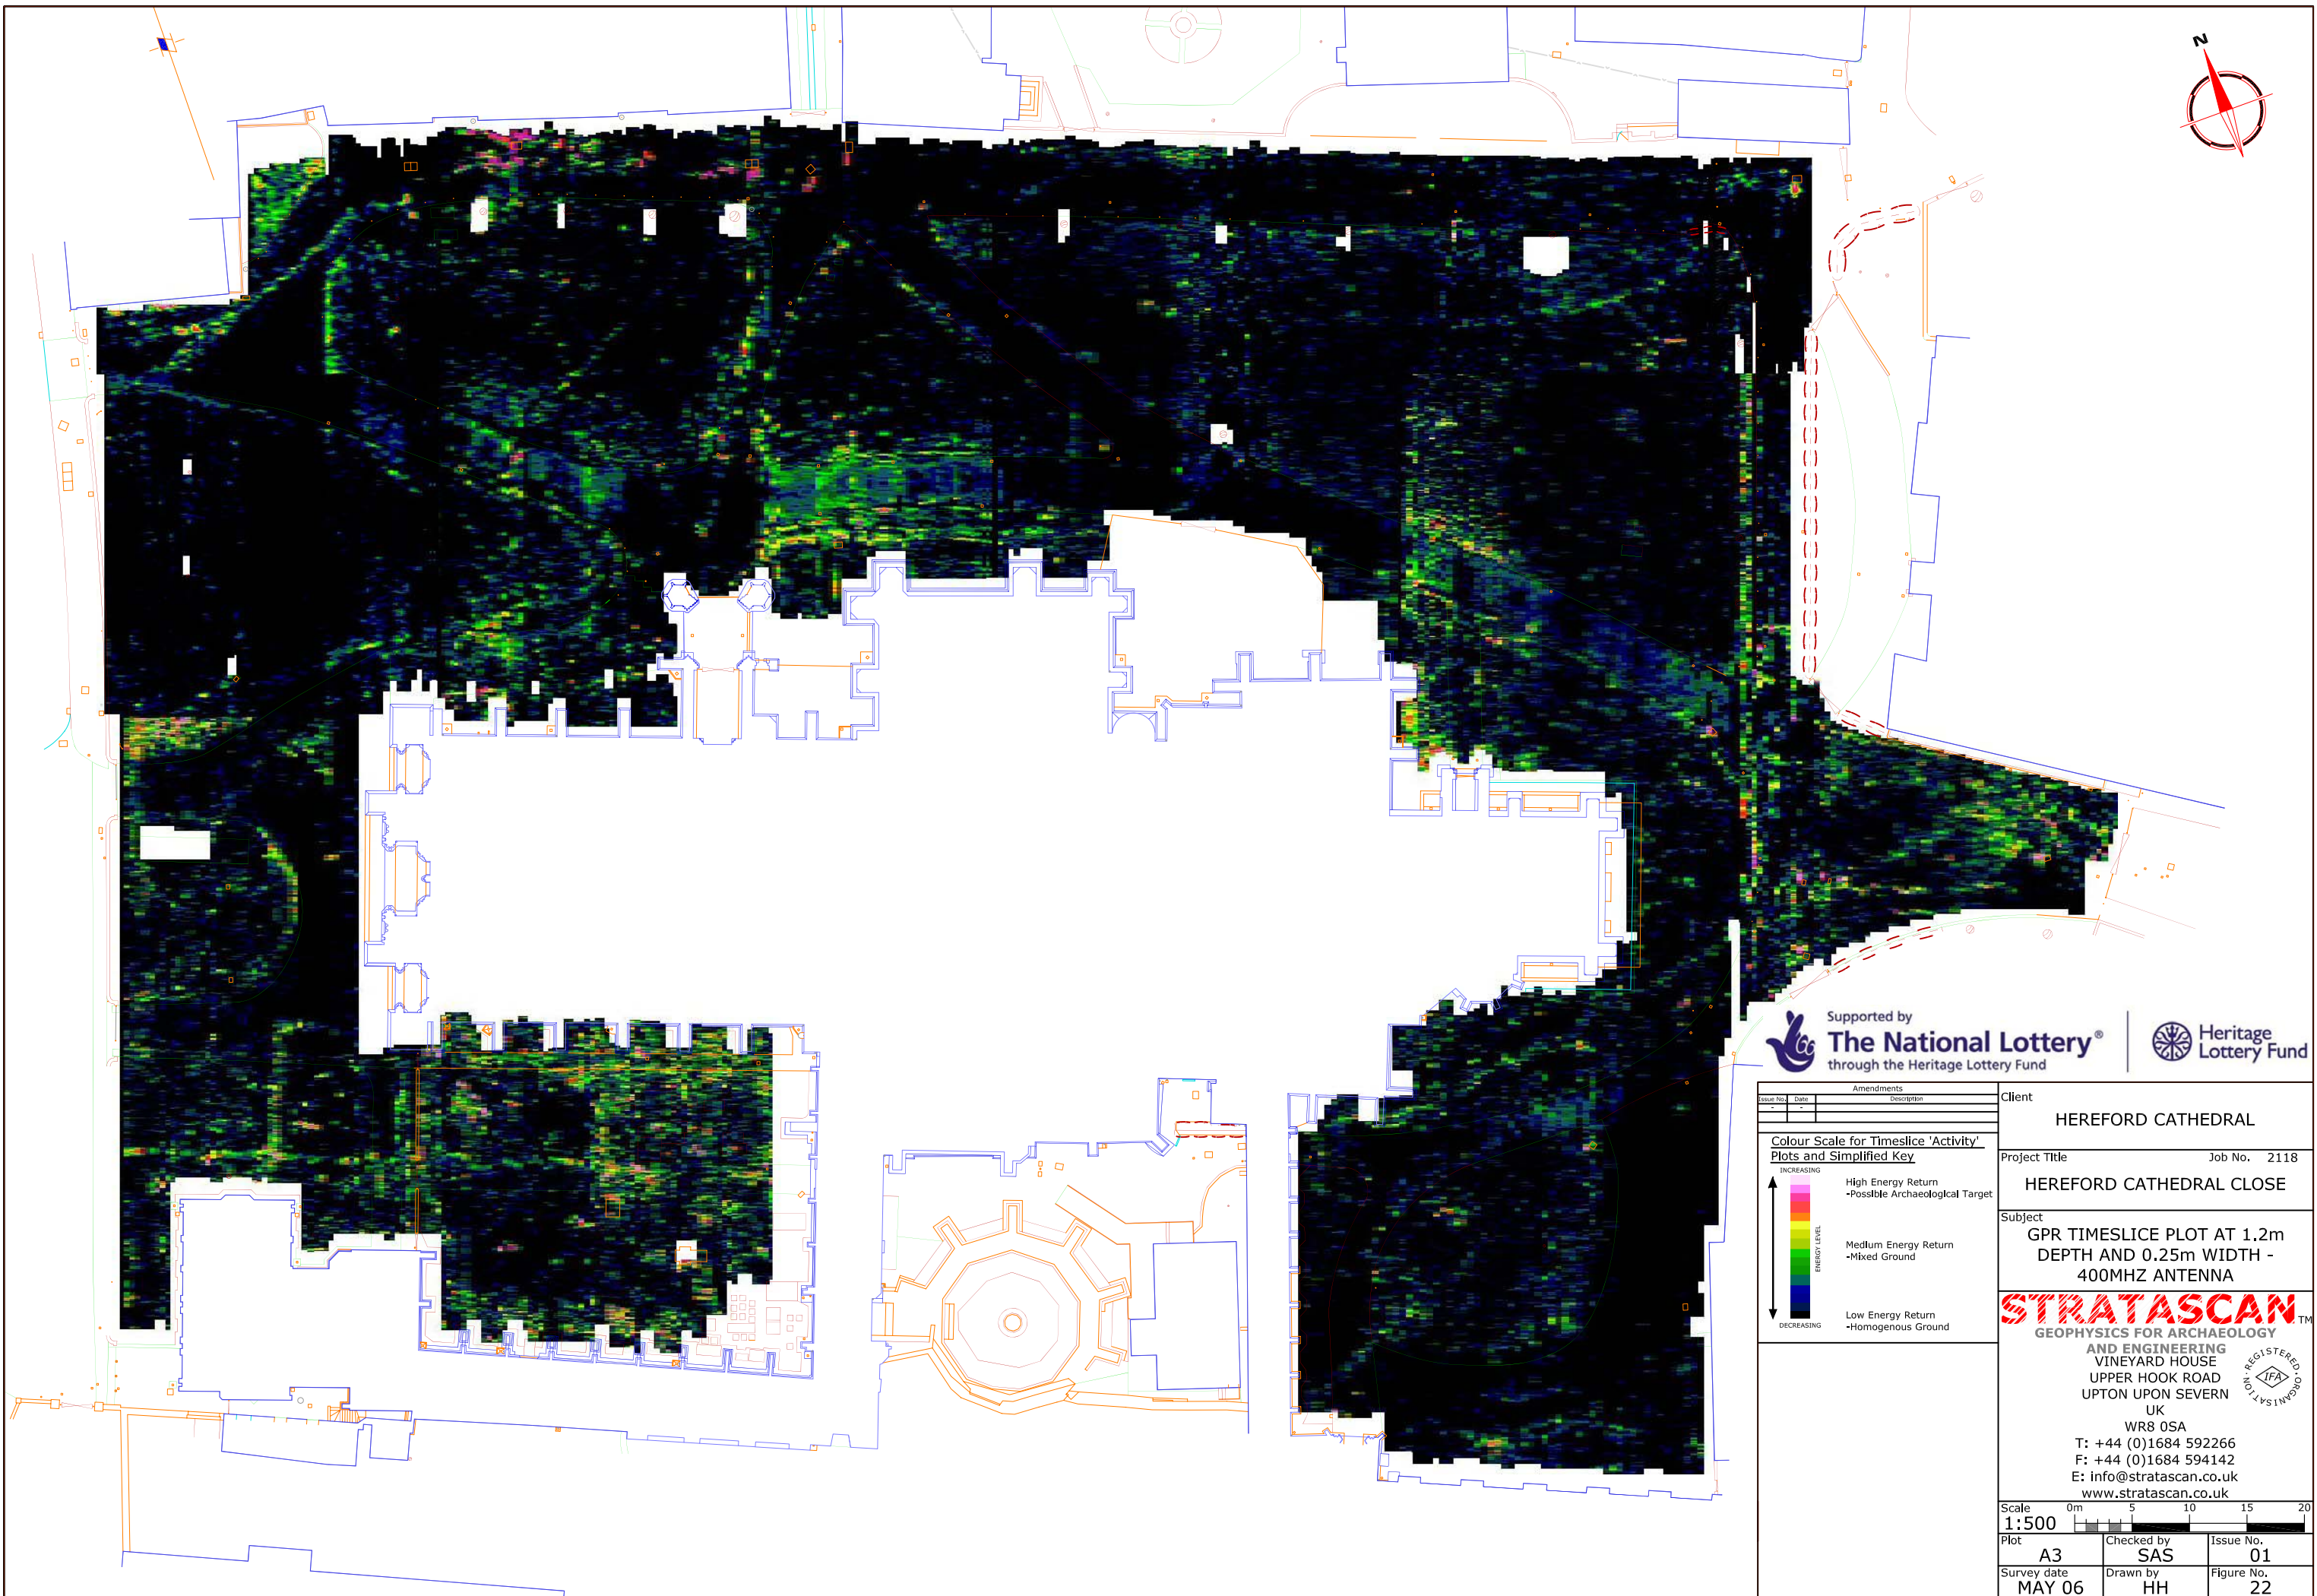

Supported by  
**The National Lottery**  
 through the Heritage Lottery Fund



Amendments  
 Scale No. Date Description  
 - - - - -  
 - - - - -  
 - - - - -  
 - - - - -  
 - - - - -

**Colour Scale for Timeslice 'Activity'**  
**Plots and Simplified Key**

INCREASING ENERGY LEVEL

High Energy Return  
 -Possible Archaeological Target


Medium Energy Return  
 -Mixed Ground

DECREASING ENERGY LEVEL

Low Energy Return  
 -Homogenous Ground

|  |            |   |
|--|------------|---|
| Client   |            | HEREFORD CATHEDRAL  |
| Project Title  |            | HEREFORD CATHEDRAL CLOSE  |
| Job No.  |            | 2118  |
| Subject  |            | GPR TIMESLICE PLOT AT 1.2m DEPTH AND 0.25m WIDTH - 400MHZ ANTENNA                     |
| <br><b>STRATASCAN</b><br>GEOPHYSICS FOR ARCHAEOLOGY<br>AND ENGINEERING<br>VINEYARD HOUSE<br>UPPER HOOK ROAD<br>UPTON UPON SEVERN<br>UK<br>WR8 0SA<br>T: +44 (0)1684 592266<br>F: +44 (0)1684 594142<br>E: info@stratascan.co.uk<br>www.stratascan.co.uk |            |  |
| Scale  |            | 0m 5 10 15 20   |
| 1:500  |            |   |
| Plot   | Checked by | Issue No.   |
| A3   | SAS        | 01  |
| Survey date  | Drawn by   | Figure No.  |
| MAY 06   | HH         | 22  |



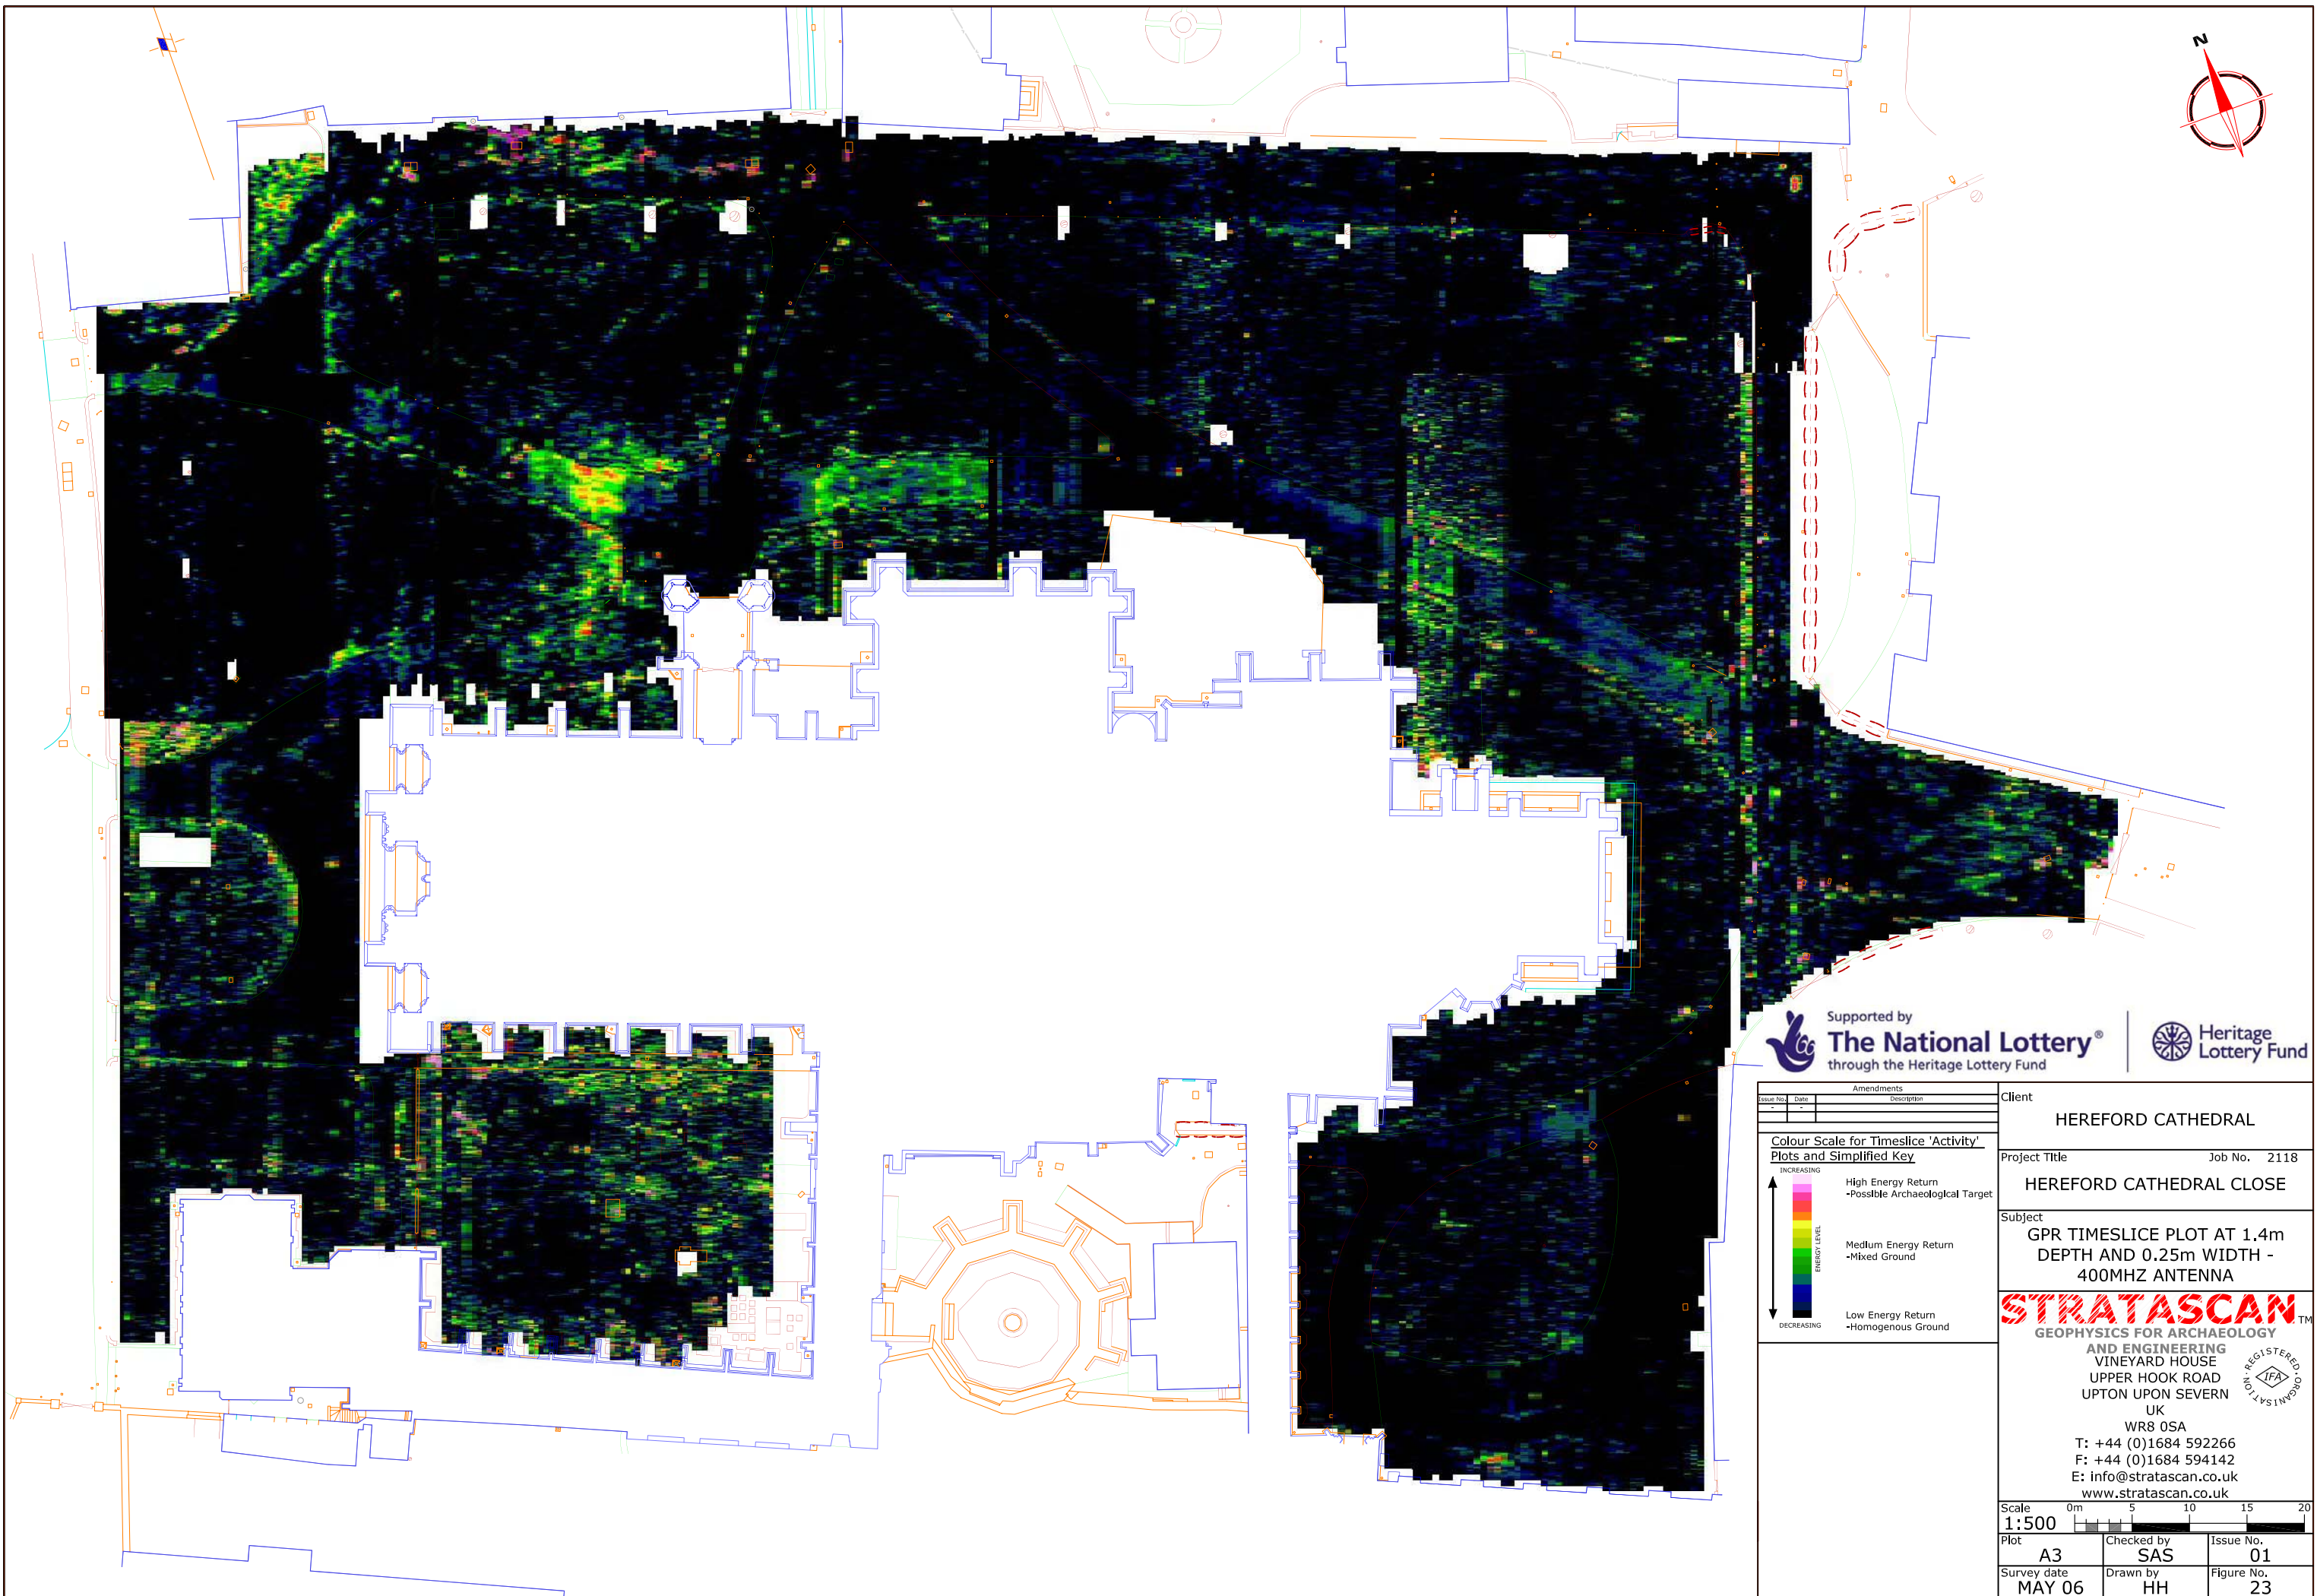


Supported by  
**The National Lottery**  
 through the Heritage Lottery Fund



| Issue No. | Date | Amendments |
|-----------|------|------------|
|           |      |            |

Client  
**HEREFORD CATHEDRAL**

**Colour Scale for Timeslice 'Activity'**  
**Plots and Simplified Key**

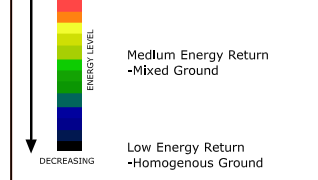

Project Title  
**HEREFORD CATHEDRAL CLOSE**

Job No. 2118  
 Subject  
**GPR TIMESLICE PLOT AT 1.4m DEPTH AND 0.25m WIDTH - 400MHZ ANTENNA**

**STRATASCAN**  
 GEOPHYSICS FOR ARCHAEOLOGY  
 AND ENGINEERING  
 VINEYARD HOUSE  
 UPPER HOOK ROAD  
 UPTON UPON SEVERN  
 UK  
 WR8 0SA  
 T: +44 (0)1684 592266  
 F: +44 (0)1684 594142  
 E: info@stratascan.co.uk  
 www.stratascan.co.uk




Scale 1:500  
 0m 5 10 15 20

|                              |                          |                         |
|------------------------------|--------------------------|-------------------------|
| Plot<br><b>A3</b>            | Checked by<br><b>SAS</b> | Issue No.<br><b>01</b>  |
| Survey date<br><b>MAY 06</b> | Drawn by<br><b>HH</b>    | Figure No.<br><b>23</b> |



| Amendments |      |             |
|------------|------|-------------|
| Issue No.  | Date | Description |
|            |      |             |

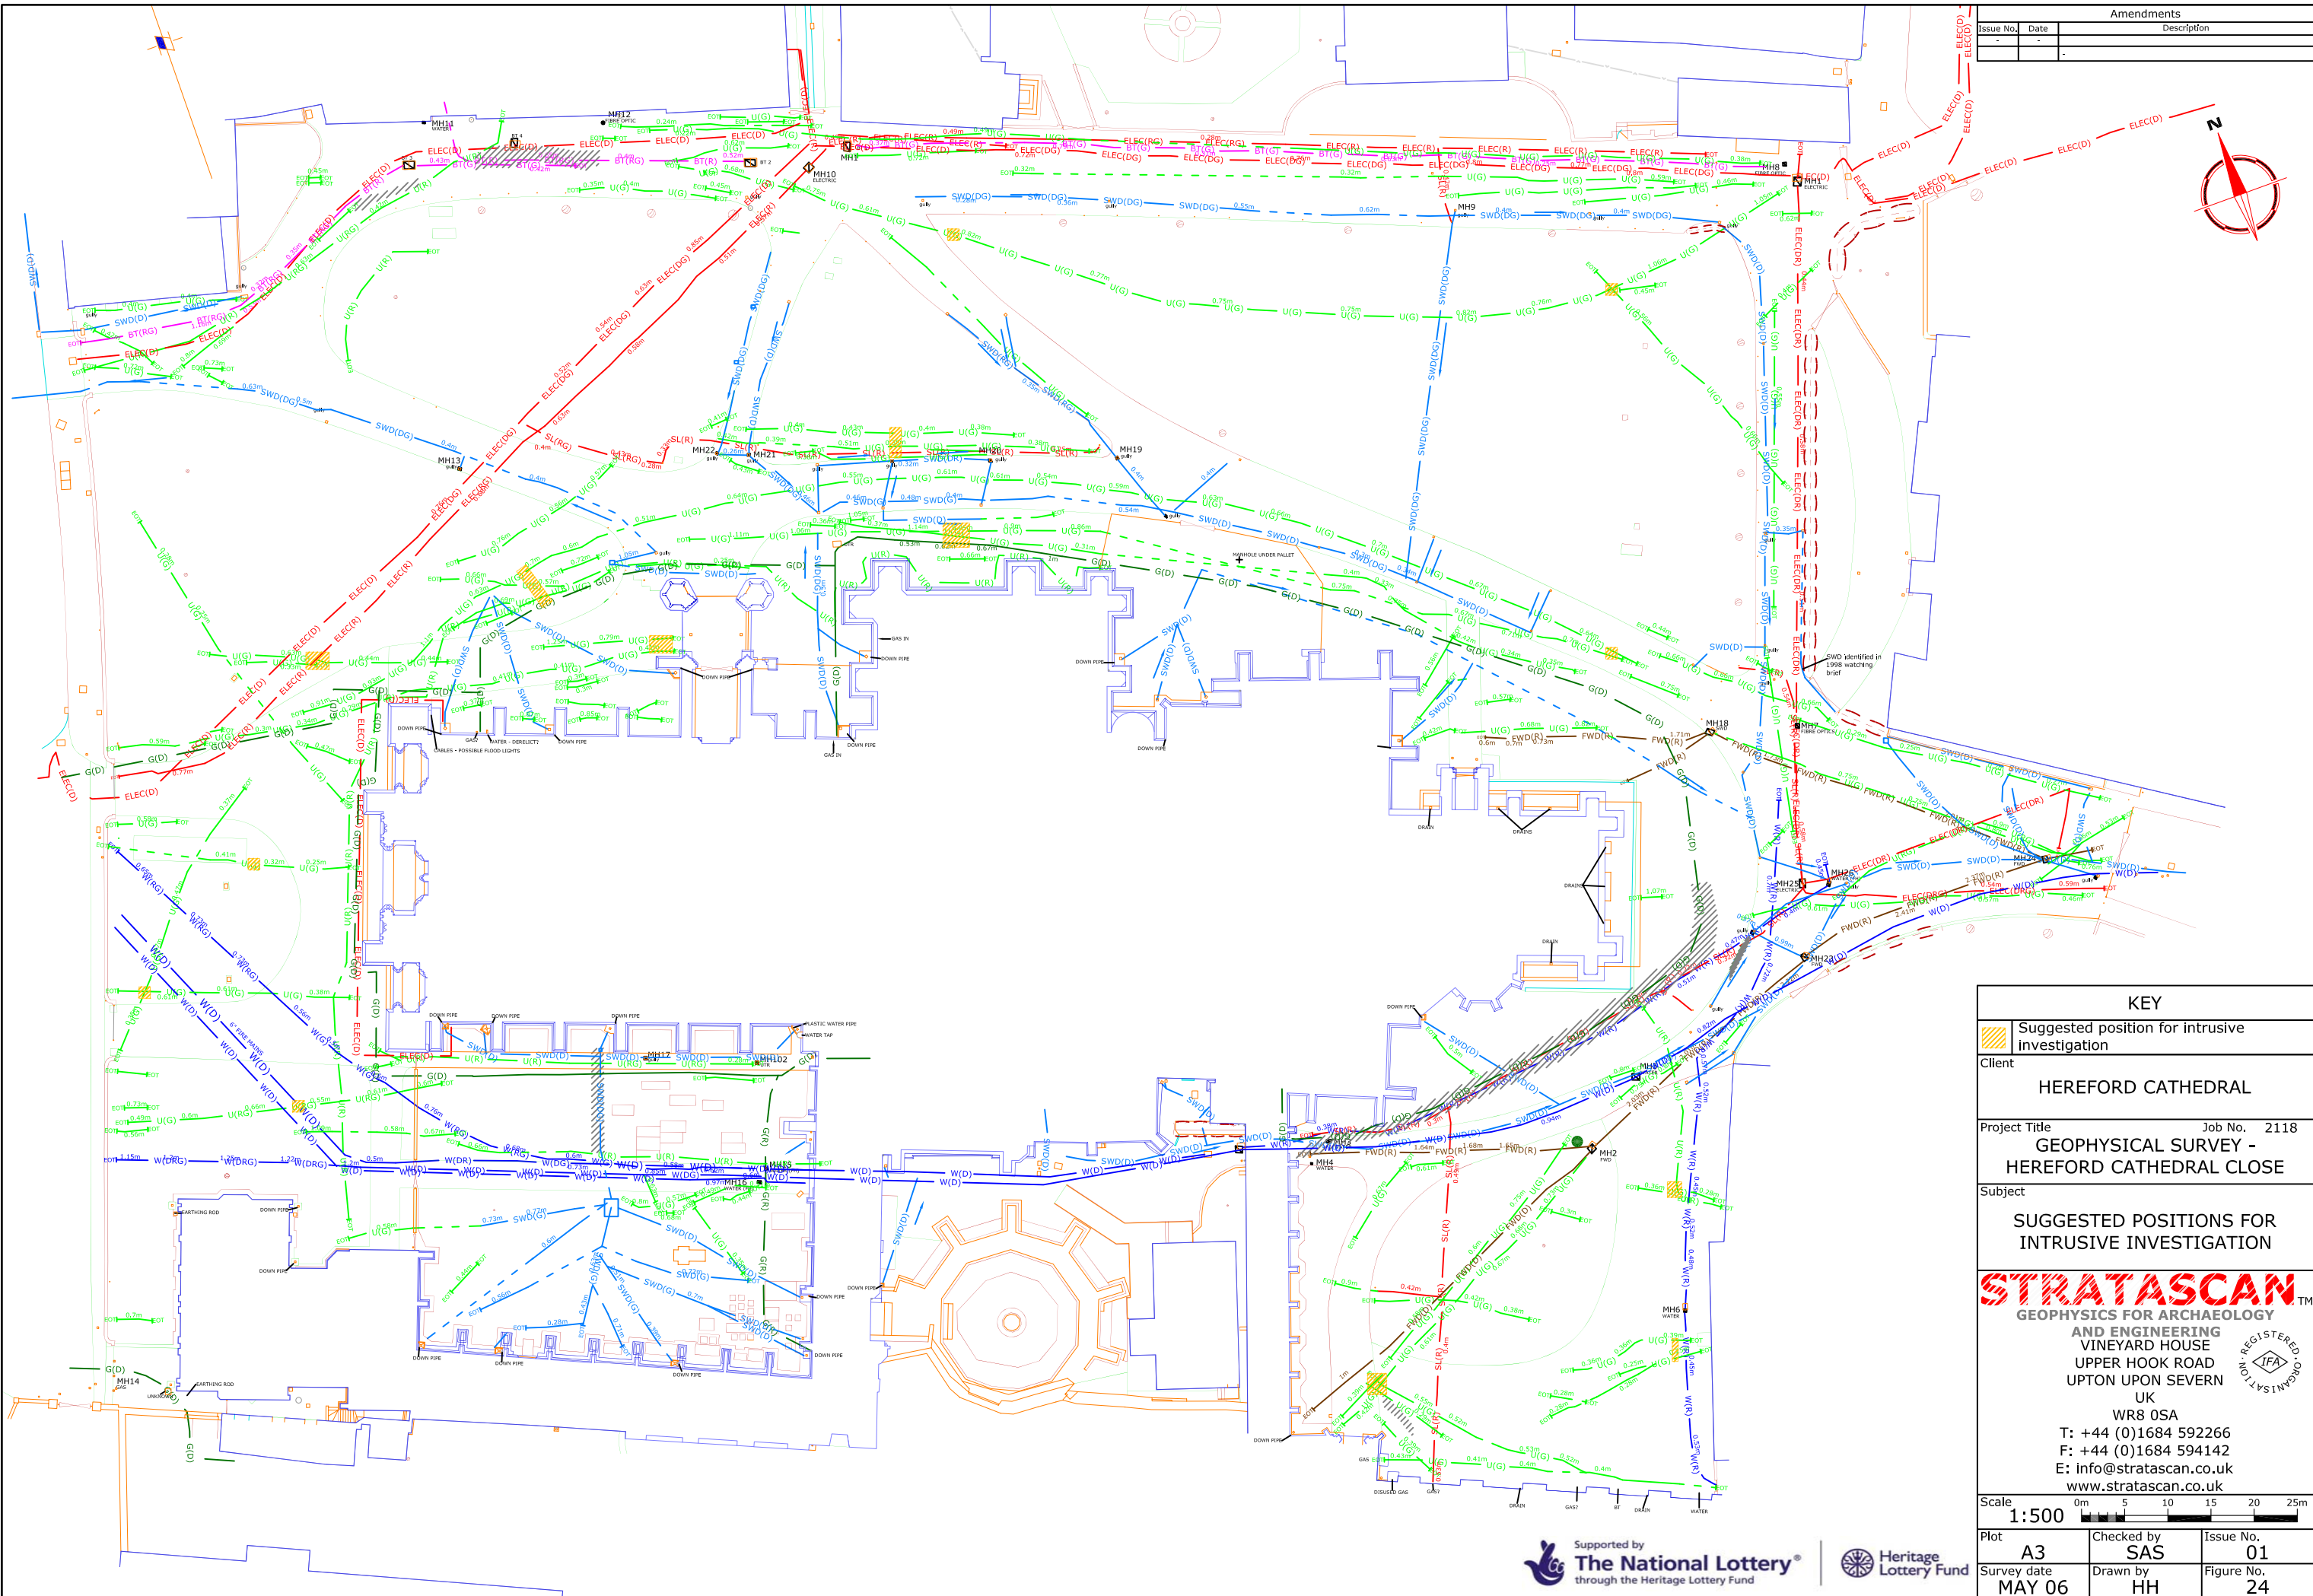


|  |                          |                         |
|--|--------------------------|-------------------------|
| <b>KEY</b>   |                          |                         |
|  Suggested position for intrusive investigation   |                          |                         |
| Client<br><b>HEREFORD CATHEDRAL</b>  |                          |                         |
| Project Title<br><b>GEOPHYSICAL SURVEY -<br/>HEREFORD CATHEDRAL CLOSE</b>  |                          | Job No. 2118            |
| Subject<br><b>SUGGESTED POSITIONS FOR<br/>INTRUSIVE INVESTIGATION</b>  |                          |                         |
|   |                          |                         |
| <b>GEOPHYSICS FOR ARCHAEOLOGY<br/>AND ENGINEERING</b><br>VINEYARD HOUSE<br>UPPER HOOK ROAD<br>UPTON UPON SEVERN<br>UK<br>WR8 0SA<br>T: +44 (0)1684 592266<br>F: +44 (0)1684 594142<br>E: info@stratascan.co.uk<br>www.stratascan.co.uk |                          |                         |
| Scale<br><b>1:500</b>  |                          |                         |
| Plot<br><b>A3</b>  | Checked by<br><b>SAS</b> | Issue No.<br><b>01</b>  |
| Survey date<br><b>MAY 06</b>   | Drawn by<br><b>HH</b>    | Figure No.<br><b>24</b> |





| Amendments |      |             |
|------------|------|-------------|
| Issue No.  | Date | Description |
|            |      |             |

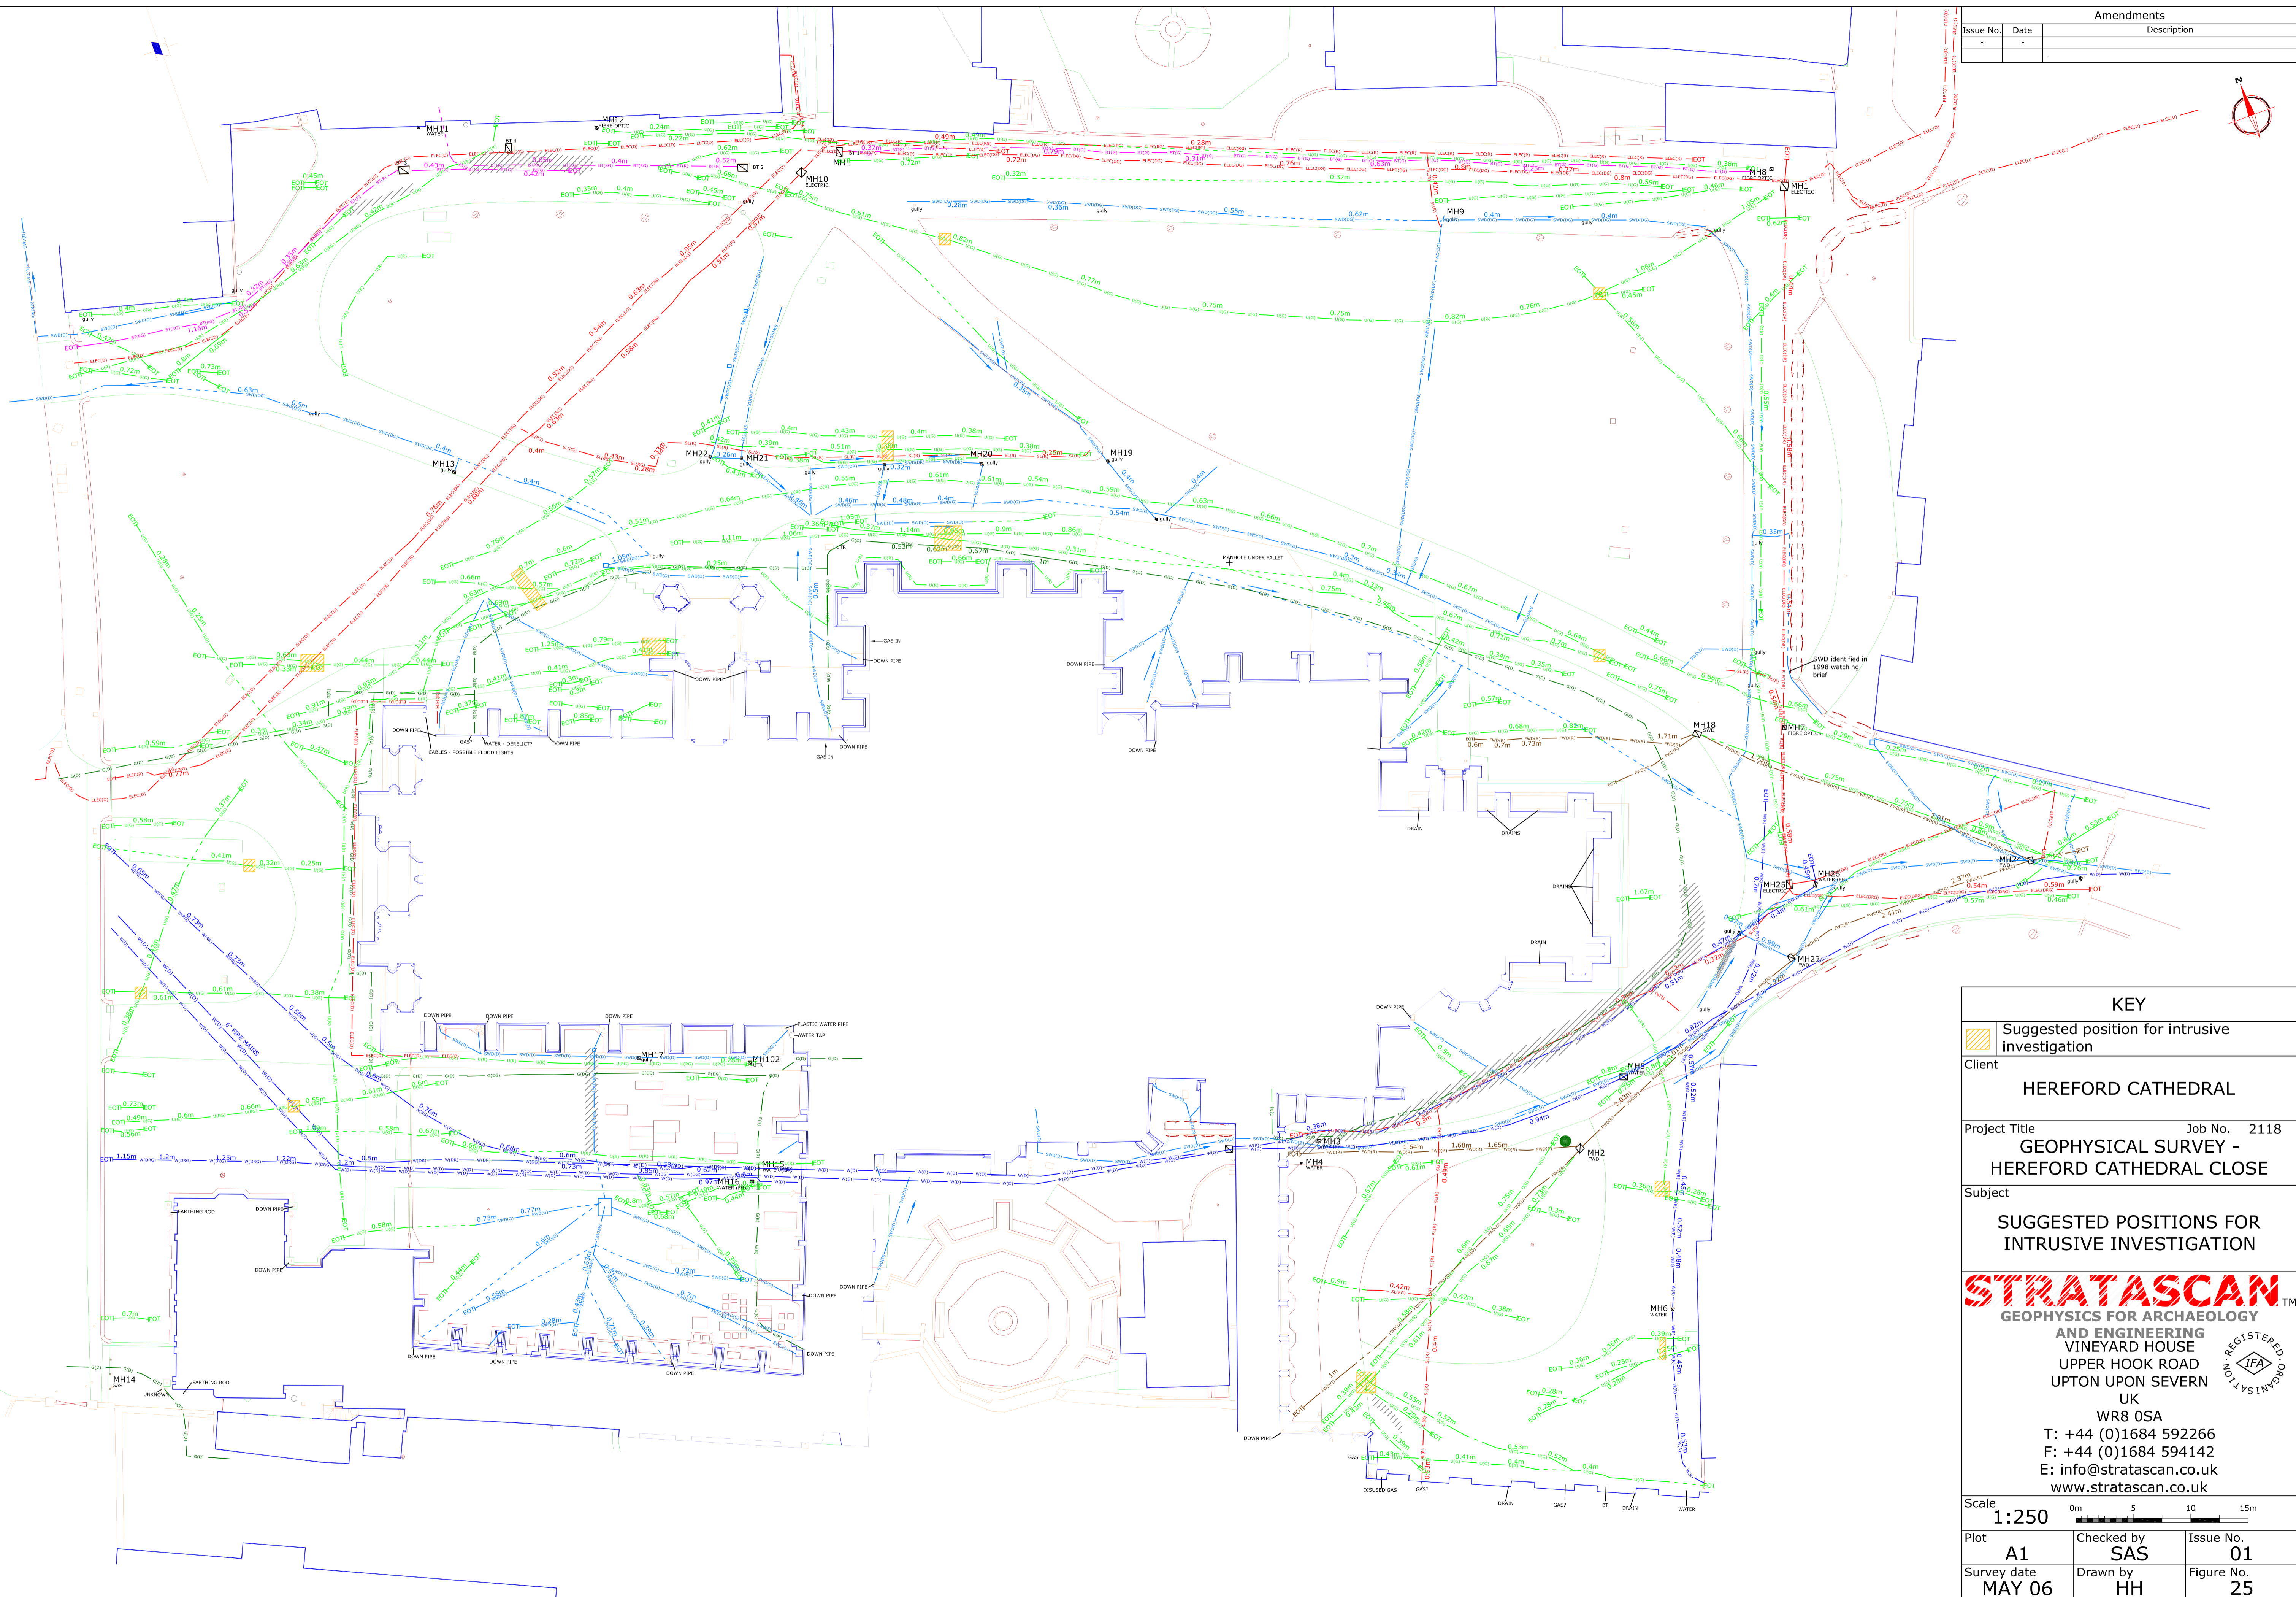

| KEY  |  |
|--|--|
|  | Suggested position for intrusive investigation |
| Client<br><b>HEREFORD CATHEDRAL</b>  |  |
| Project Title<br><b>GEOPHYSICAL SURVEY -<br/>HEREFORD CATHEDRAL CLOSE</b>  | Job No. 2118                                   |
| Subject<br><b>SUGGESTED POSITIONS FOR<br/>INTRUSIVE INVESTIGATION</b>  |  |
| <br><b>STRATASCAN™</b><br>GEOPHYSICS FOR ARCHAEOLOGY<br>AND ENGINEERING<br>VINEYARD HOUSE<br>UPPER HOOK ROAD<br>UPTON UPON SEVERN<br>UK<br>WR8 0SA<br>T: +44 (0)1684 592266<br>F: +44 (0)1684 594142<br>E: info@stratascan.co.uk<br>www.stratascan.co.uk |  |
| Scale<br><b>1:250</b>  |  |
| Plot<br><b>A1</b>  | Checked by<br><b>SAS</b>                       |
| Survey date<br><b>MAY 06</b>   | Issue No.<br><b>01</b>                         |
|  | Drawn by<br><b>HH</b>                          |
|  | Figure No.<br><b>25</b>                        |